


Extended	April	3	1940
"	Jan	24	1942
"	July	2	1943
"	Dec	14	1945
"	Feb	6	1947
"	Sept	4	1947
"	Dec	10	1948
"	May	9	1950
"	Nov	25	1952
"	Dec	14	1953
"	Dec	15	1954
"	Jan	6	1956
Abandoned			

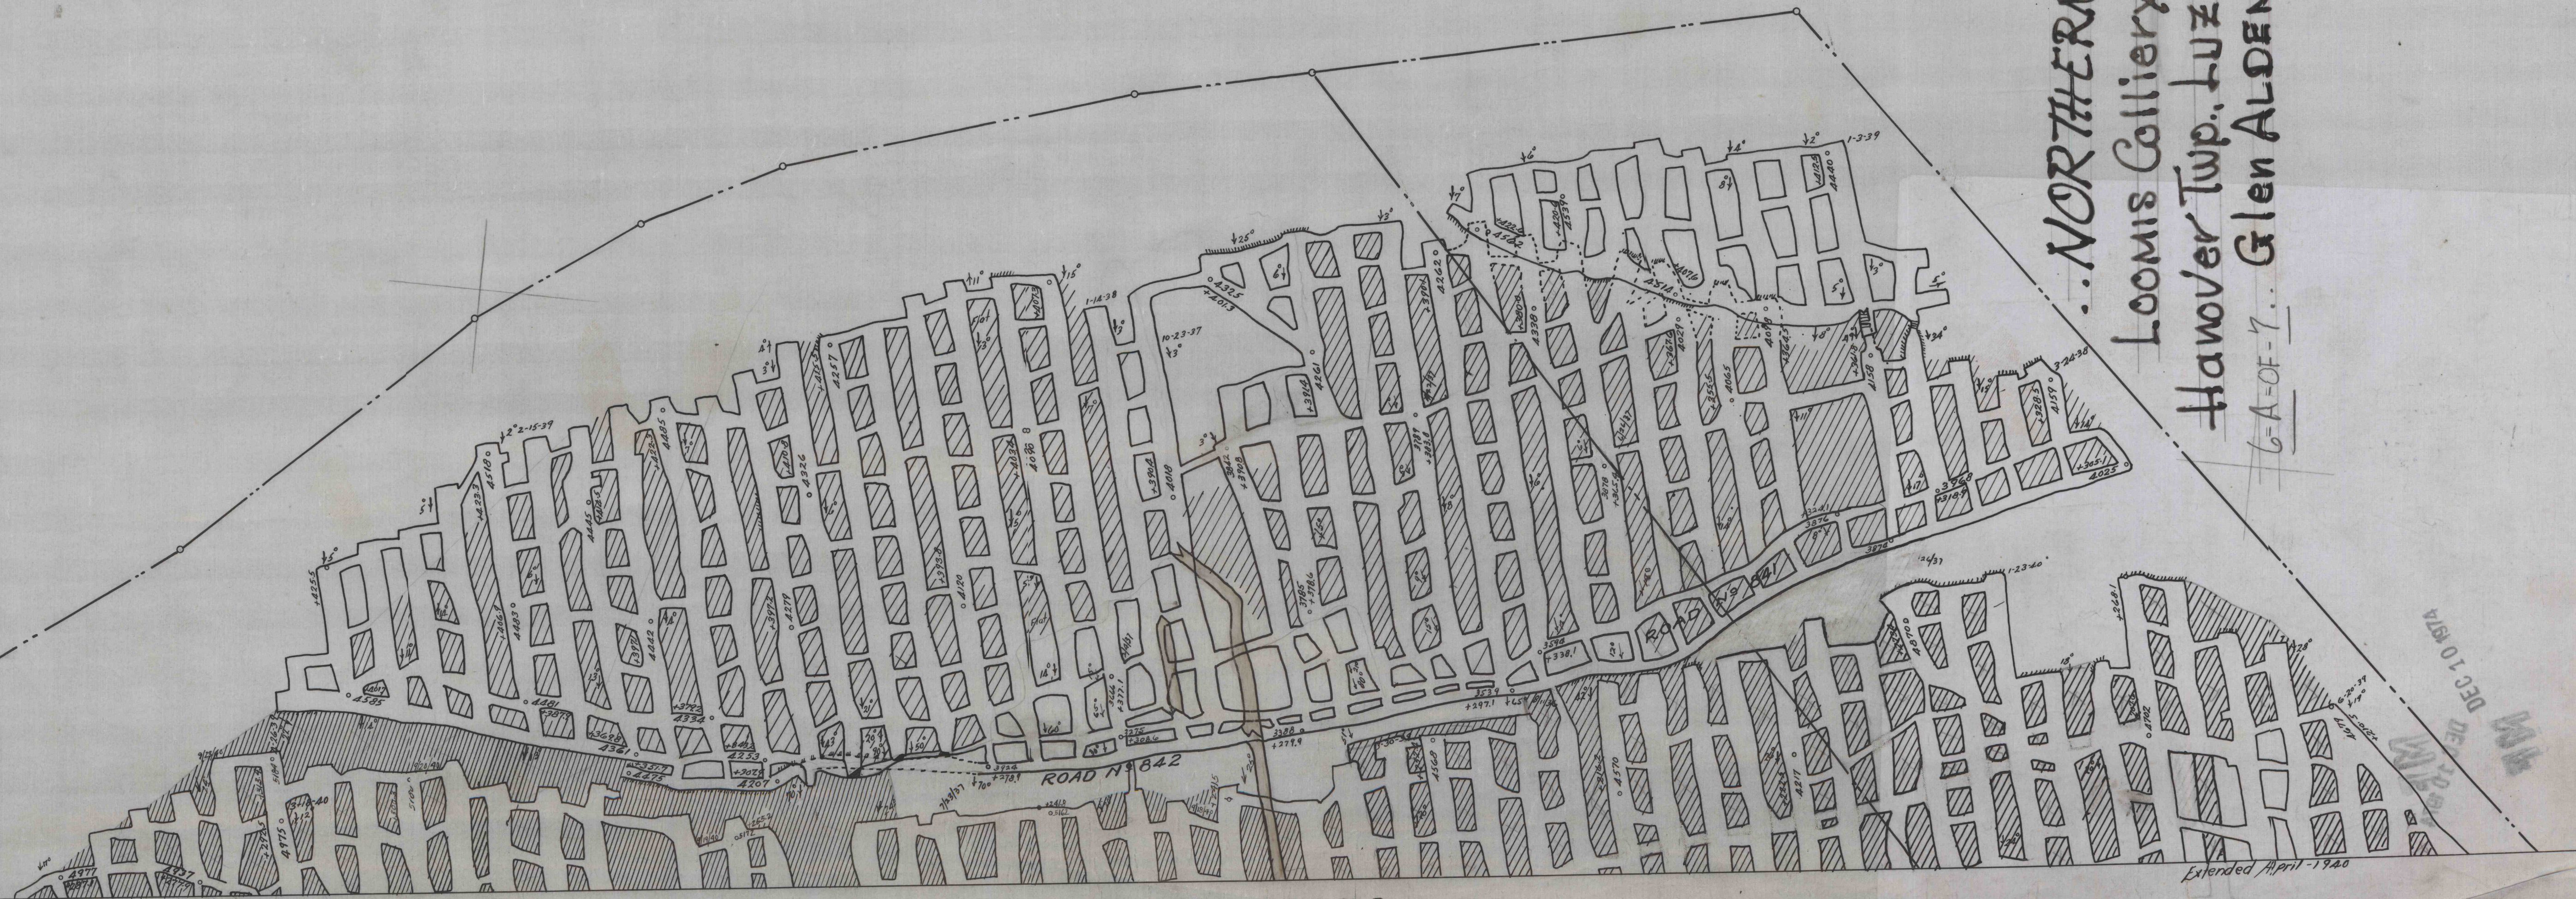

LOOMIS ABBOTT VEIN.

..NORTHERN COALFIELD..

LOOMIS COLLIERY.. ABBOTT VEIN.. I"=100'.

Hanover Twp., Luzerne County, NANTICOKE, PA.

6-A-Of-7.. Glen Alden Coal Co.,

DEC 10 1984

DEC 10 1974