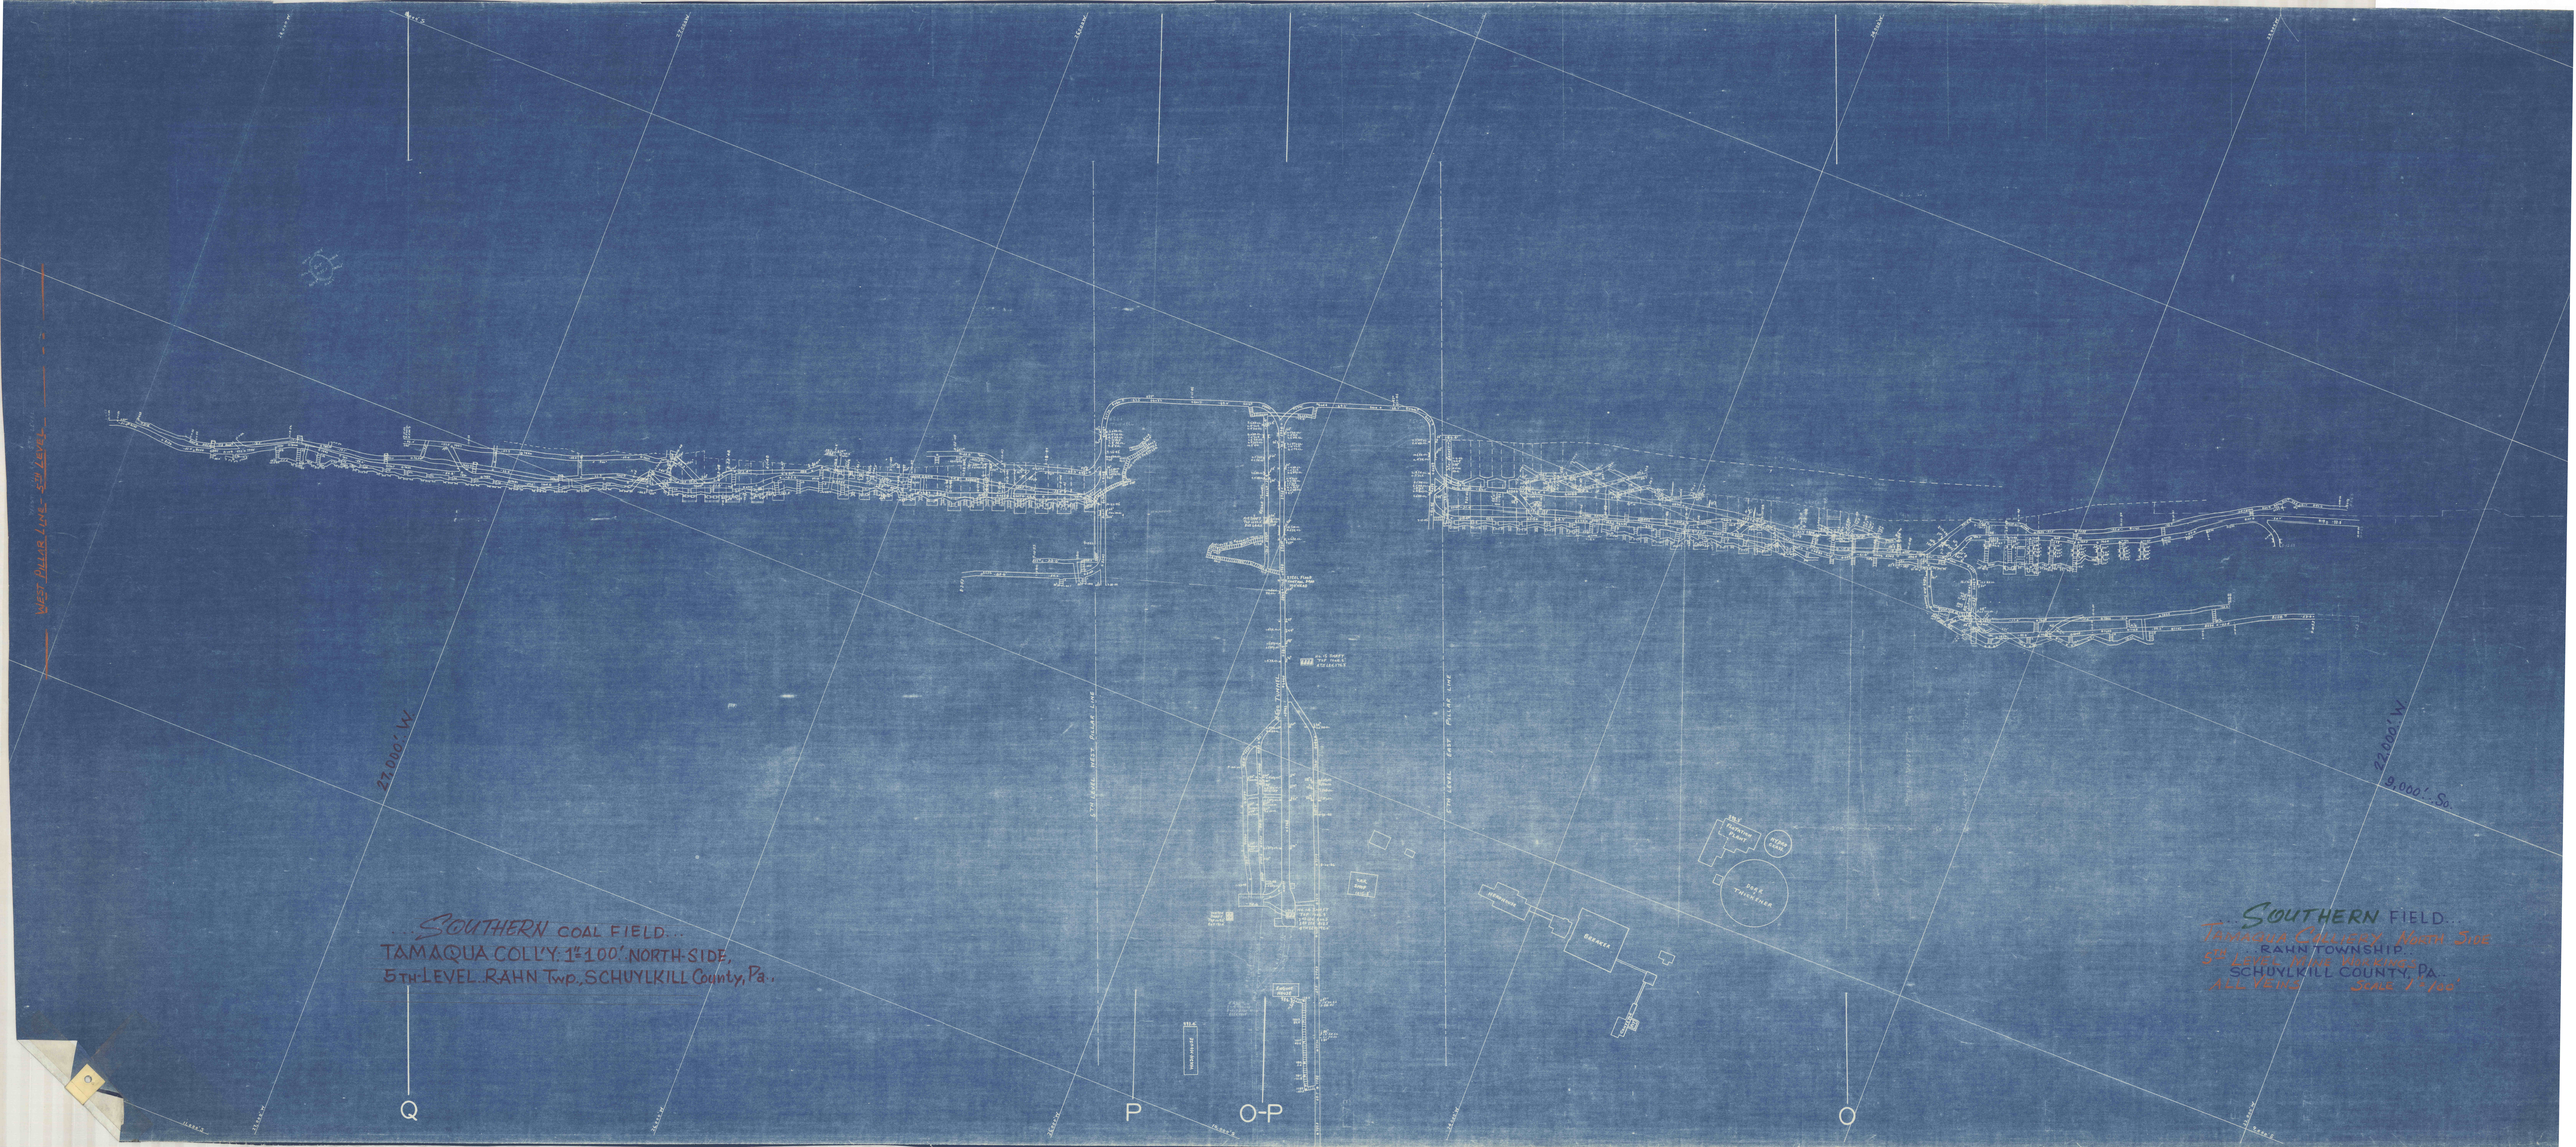
SOUTHERN COAL FIELD.
TAMAQUA COLL'Y. 1"=100' NORTH SIDE.
5TH LEVEL. RAHN Twp., SCHUYLKILL County, Pa.
SOUTHERN FIELD.
TAMAQUA COLLIERY. NORTH SIDE
RAHN TOWNSHIP.
SCHUYLKILL COUNTY, PA.
ALL VEINS
SCALE 1"=100'
Q
P
O-P
O
27,000' W.
22,000' W.
9,000' So.