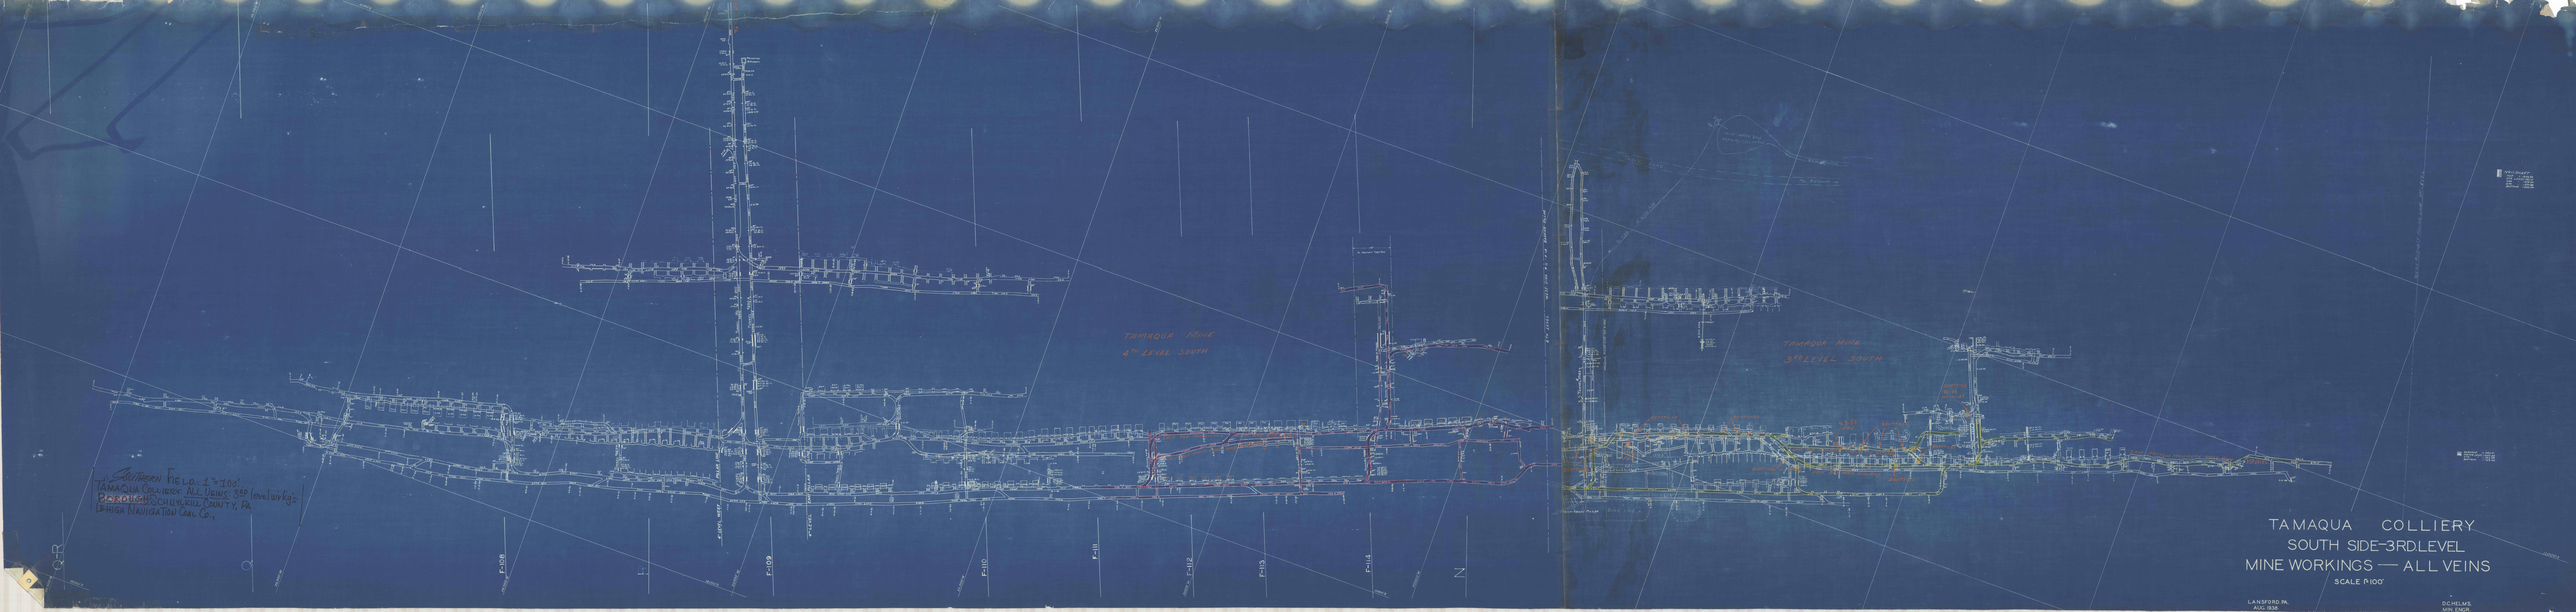
Southern Field. 1" = 100'.
Tamaqua Colliery. All Veins: 3rd level workings.
Borough of Schuylkill County, Pa.
Lehigh Navigation Coal Co.
TAMAQUA MINE
4TH LEVEL SOUTH
TAMAQUA MINE
3RD LEVEL SOUTH
TAMAQUA COLLIERY
SOUTH SIDE-3RD LEVEL
MINE WORKINGS — ALL VEINS
SCALE 1"=100'
LANSFORD, PA.
AUG. 1938
D.C. HELMS.
MIN. ENGR.