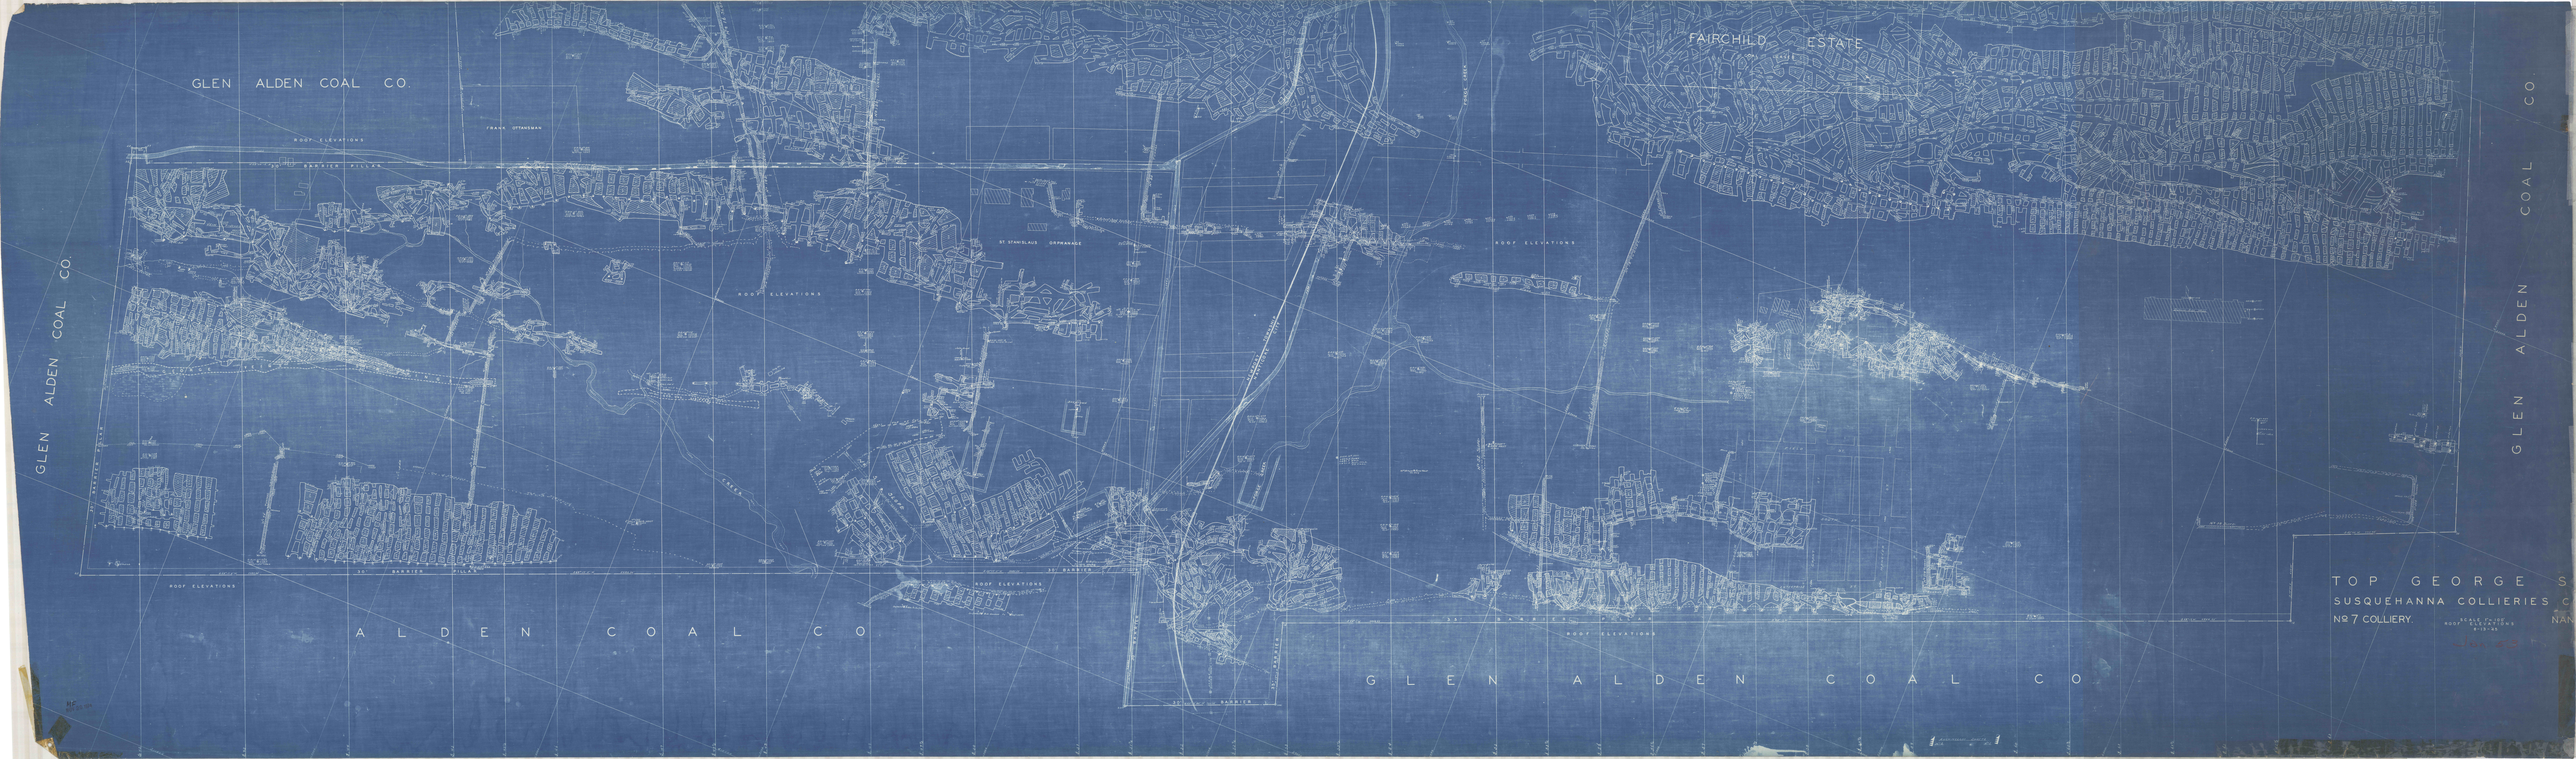
GLEN ALDEN COAL CO.
FAIRCHILD ESTATE
GLEN ALDEN COAL CO.
GLEN ALDEN COAL CO.
ROOF ELEVATIONS
FRANK OTTENSMAN
BARRIER PILLAR
ST. STANISLAUS ORPHANAGE
ROOF ELEVATIONS
ROOF ELEVATIONS
ROOF ELEVATIONS
ROOF ELEVATIONS
ROOF ELEVATIONS
BARRIER
BARRIER
BARRIER
A L D E N C O A L C O
G L E N A L D E N C O A L C O
T O P G E O R G E S
SUSQUEHANNA COLLIERIES C
Nº 7 COLLIERY.
NAN