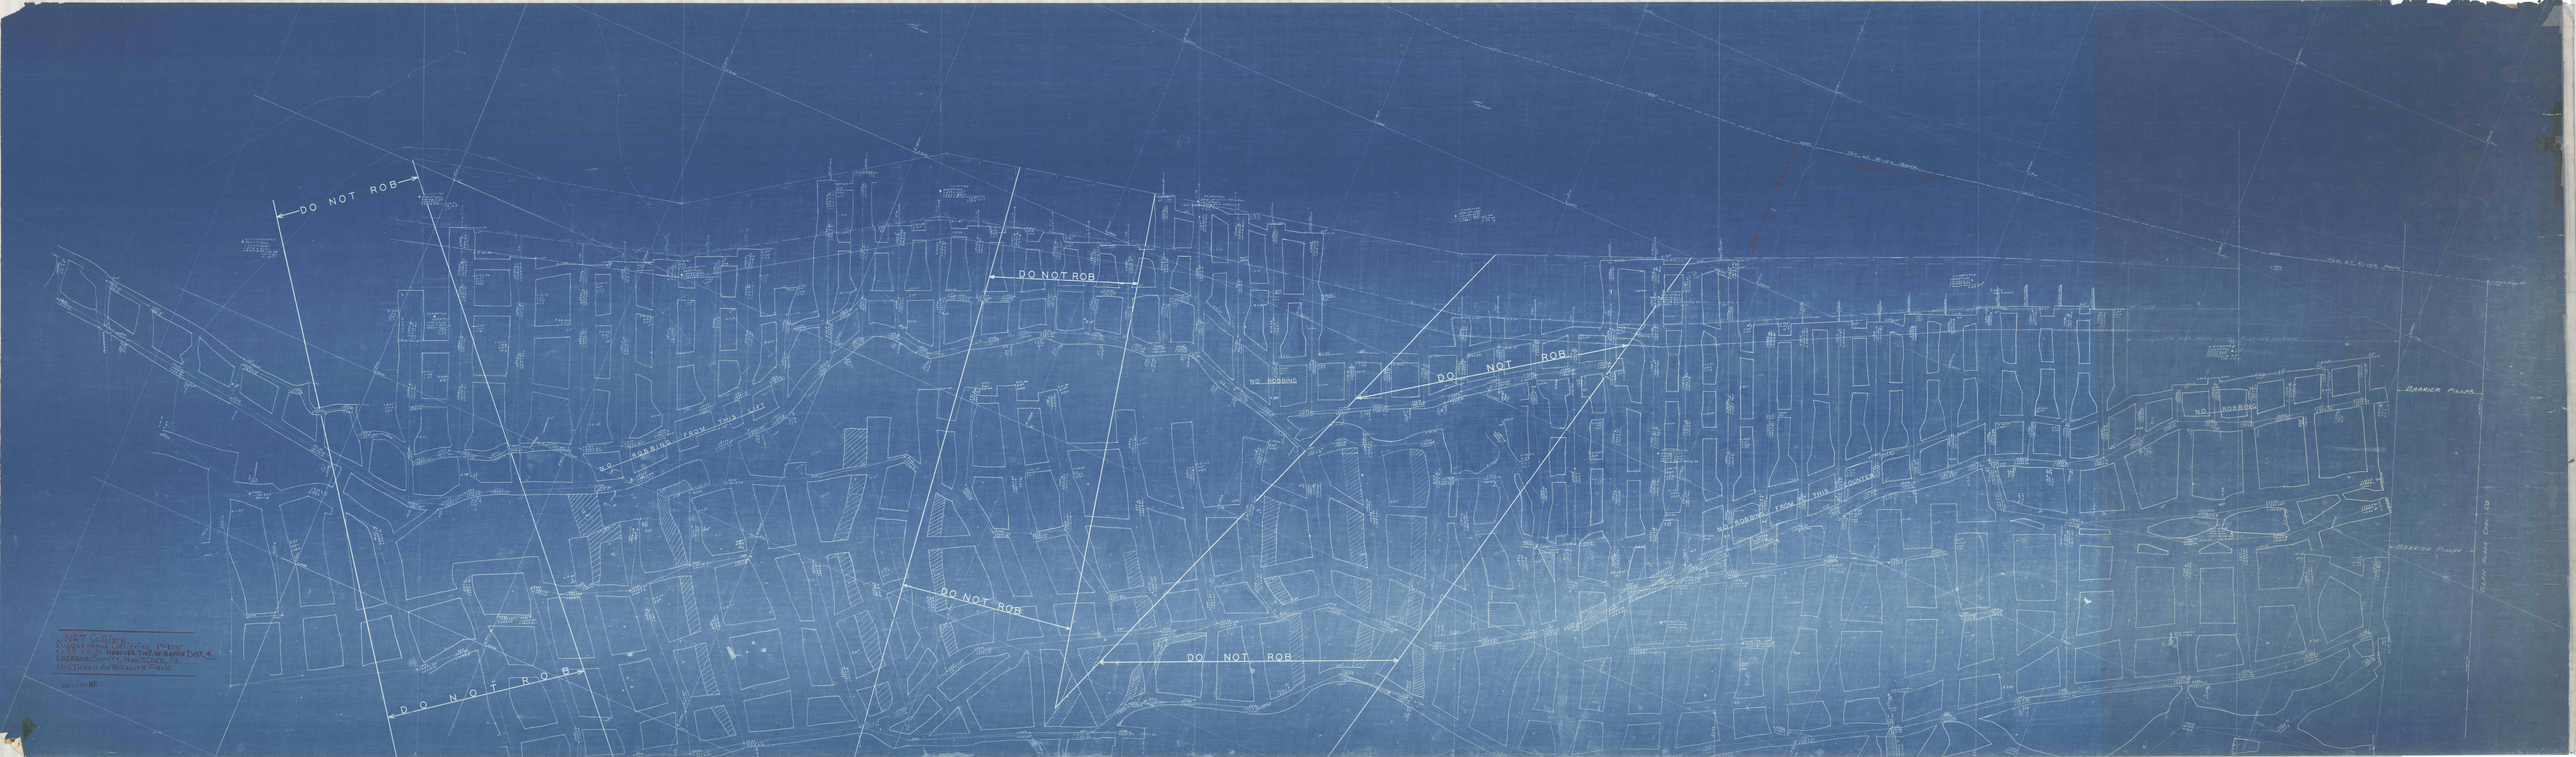
DO NOT ROB
DO NOT ROB
DO NOT ROB
DO NOT ROB
DO NOT ROB
NO ROBBING FROM THIS LINE
NO ROBBING
NO ROBBING FROM THIS COURTER
NO ROBBING
BARRIER PILLAR
BARRIER PILLAR
No 27 Colliery
SUSQUEHANNA COAL COMPANY
SCALE 1" = 100'
HANOVER TWP. M. & MINE DIST. 4
LUZERNE COUNTY, NANTICOKE, PA.
NORTHERN ANTHRACITE FIELD.