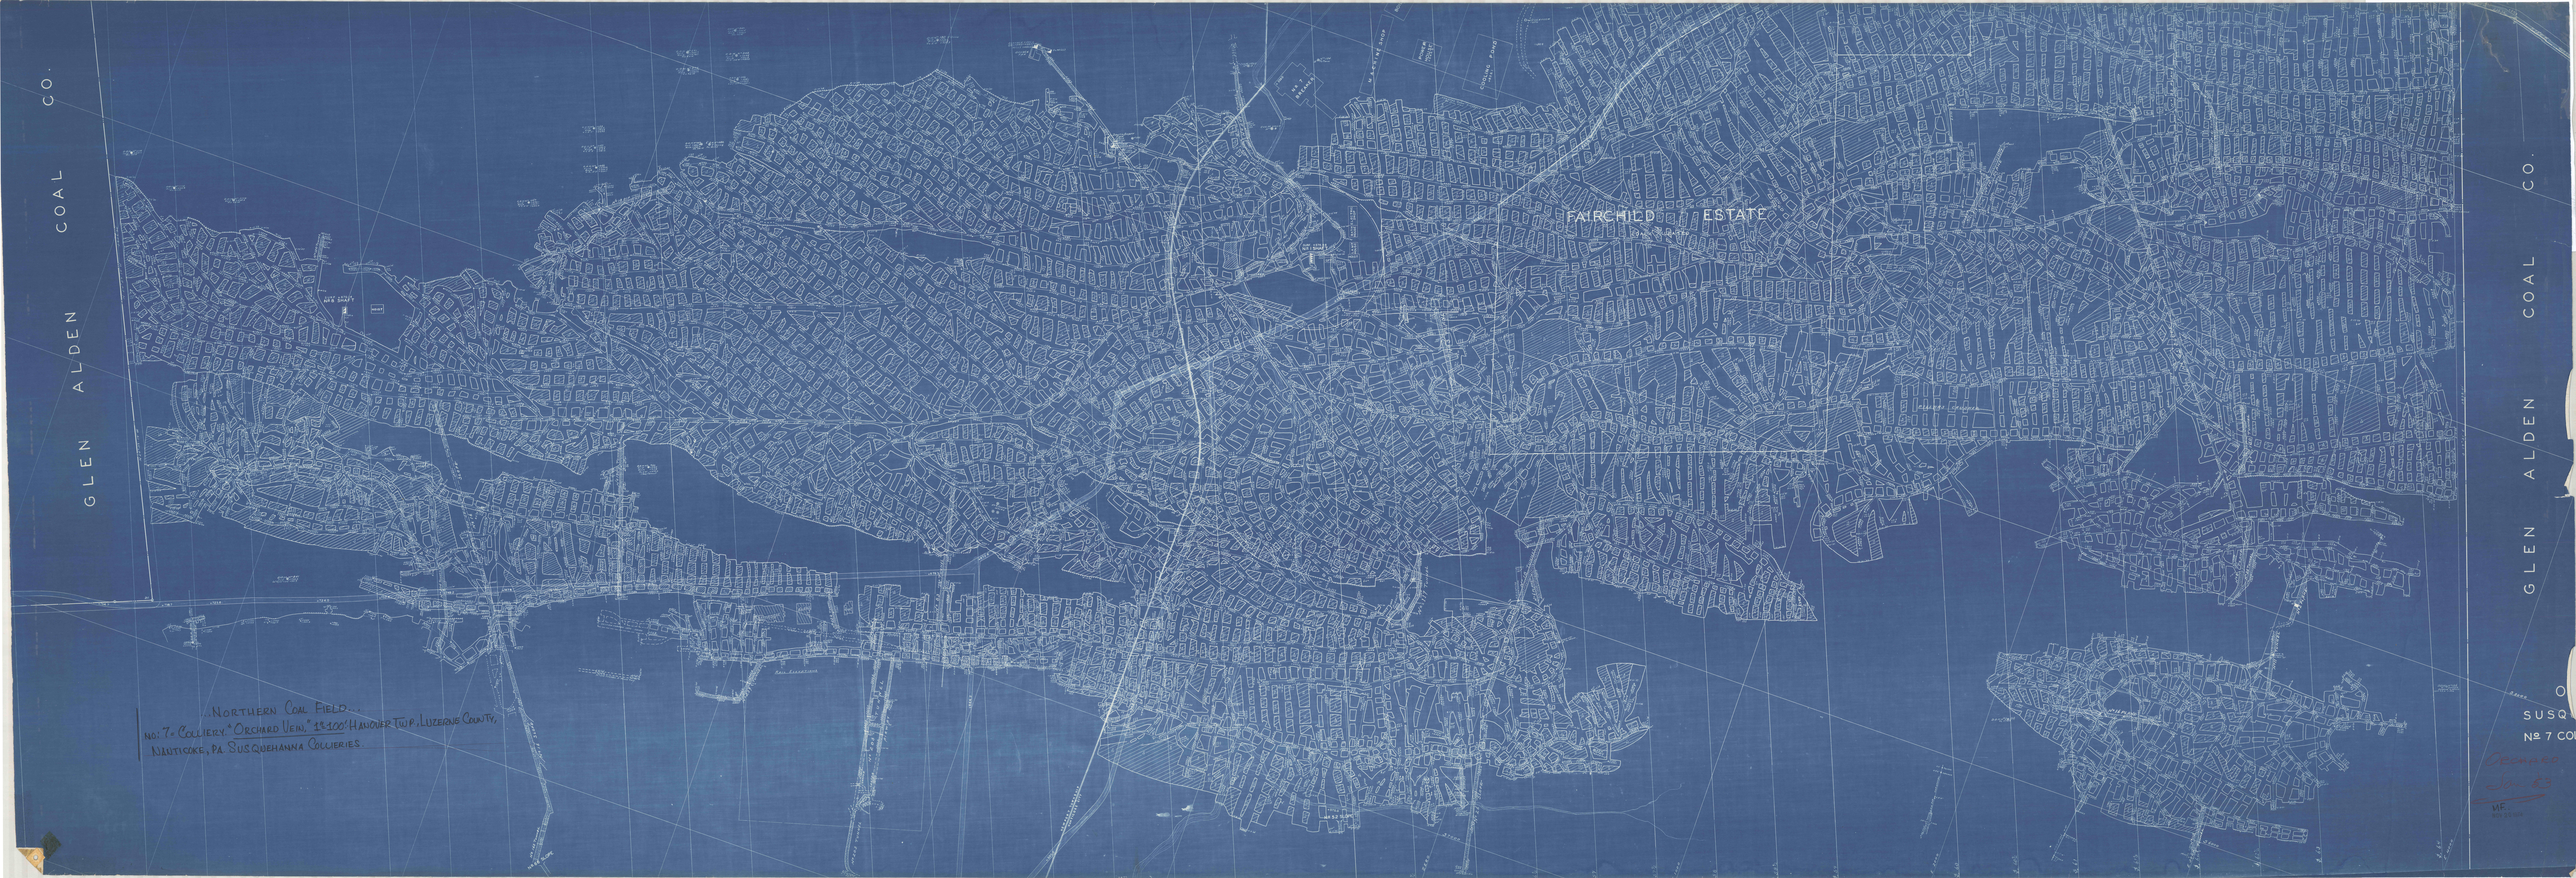

GLEN ALDEN COAL CO.
FAIRCHILD ESTATE
GLEN ALDEN COAL CO.
No 16 SLOPE
DDH No 186
4" WATER
GEORGE to MILLS
S 5000
E 4000

..NORTHERN COAL FIELD..
NO: 7= COLLIERY. "ORCHARD VEIN," 1"=100': HANOVER TWP., LUZERNE COUNTY,
NANTICOKE, PA. SUSQUEHANNA COLLIERIES.

O
SUSQ
Nº 7 COL

Orchard
Jan 53

MF..
NOV 20 1974