


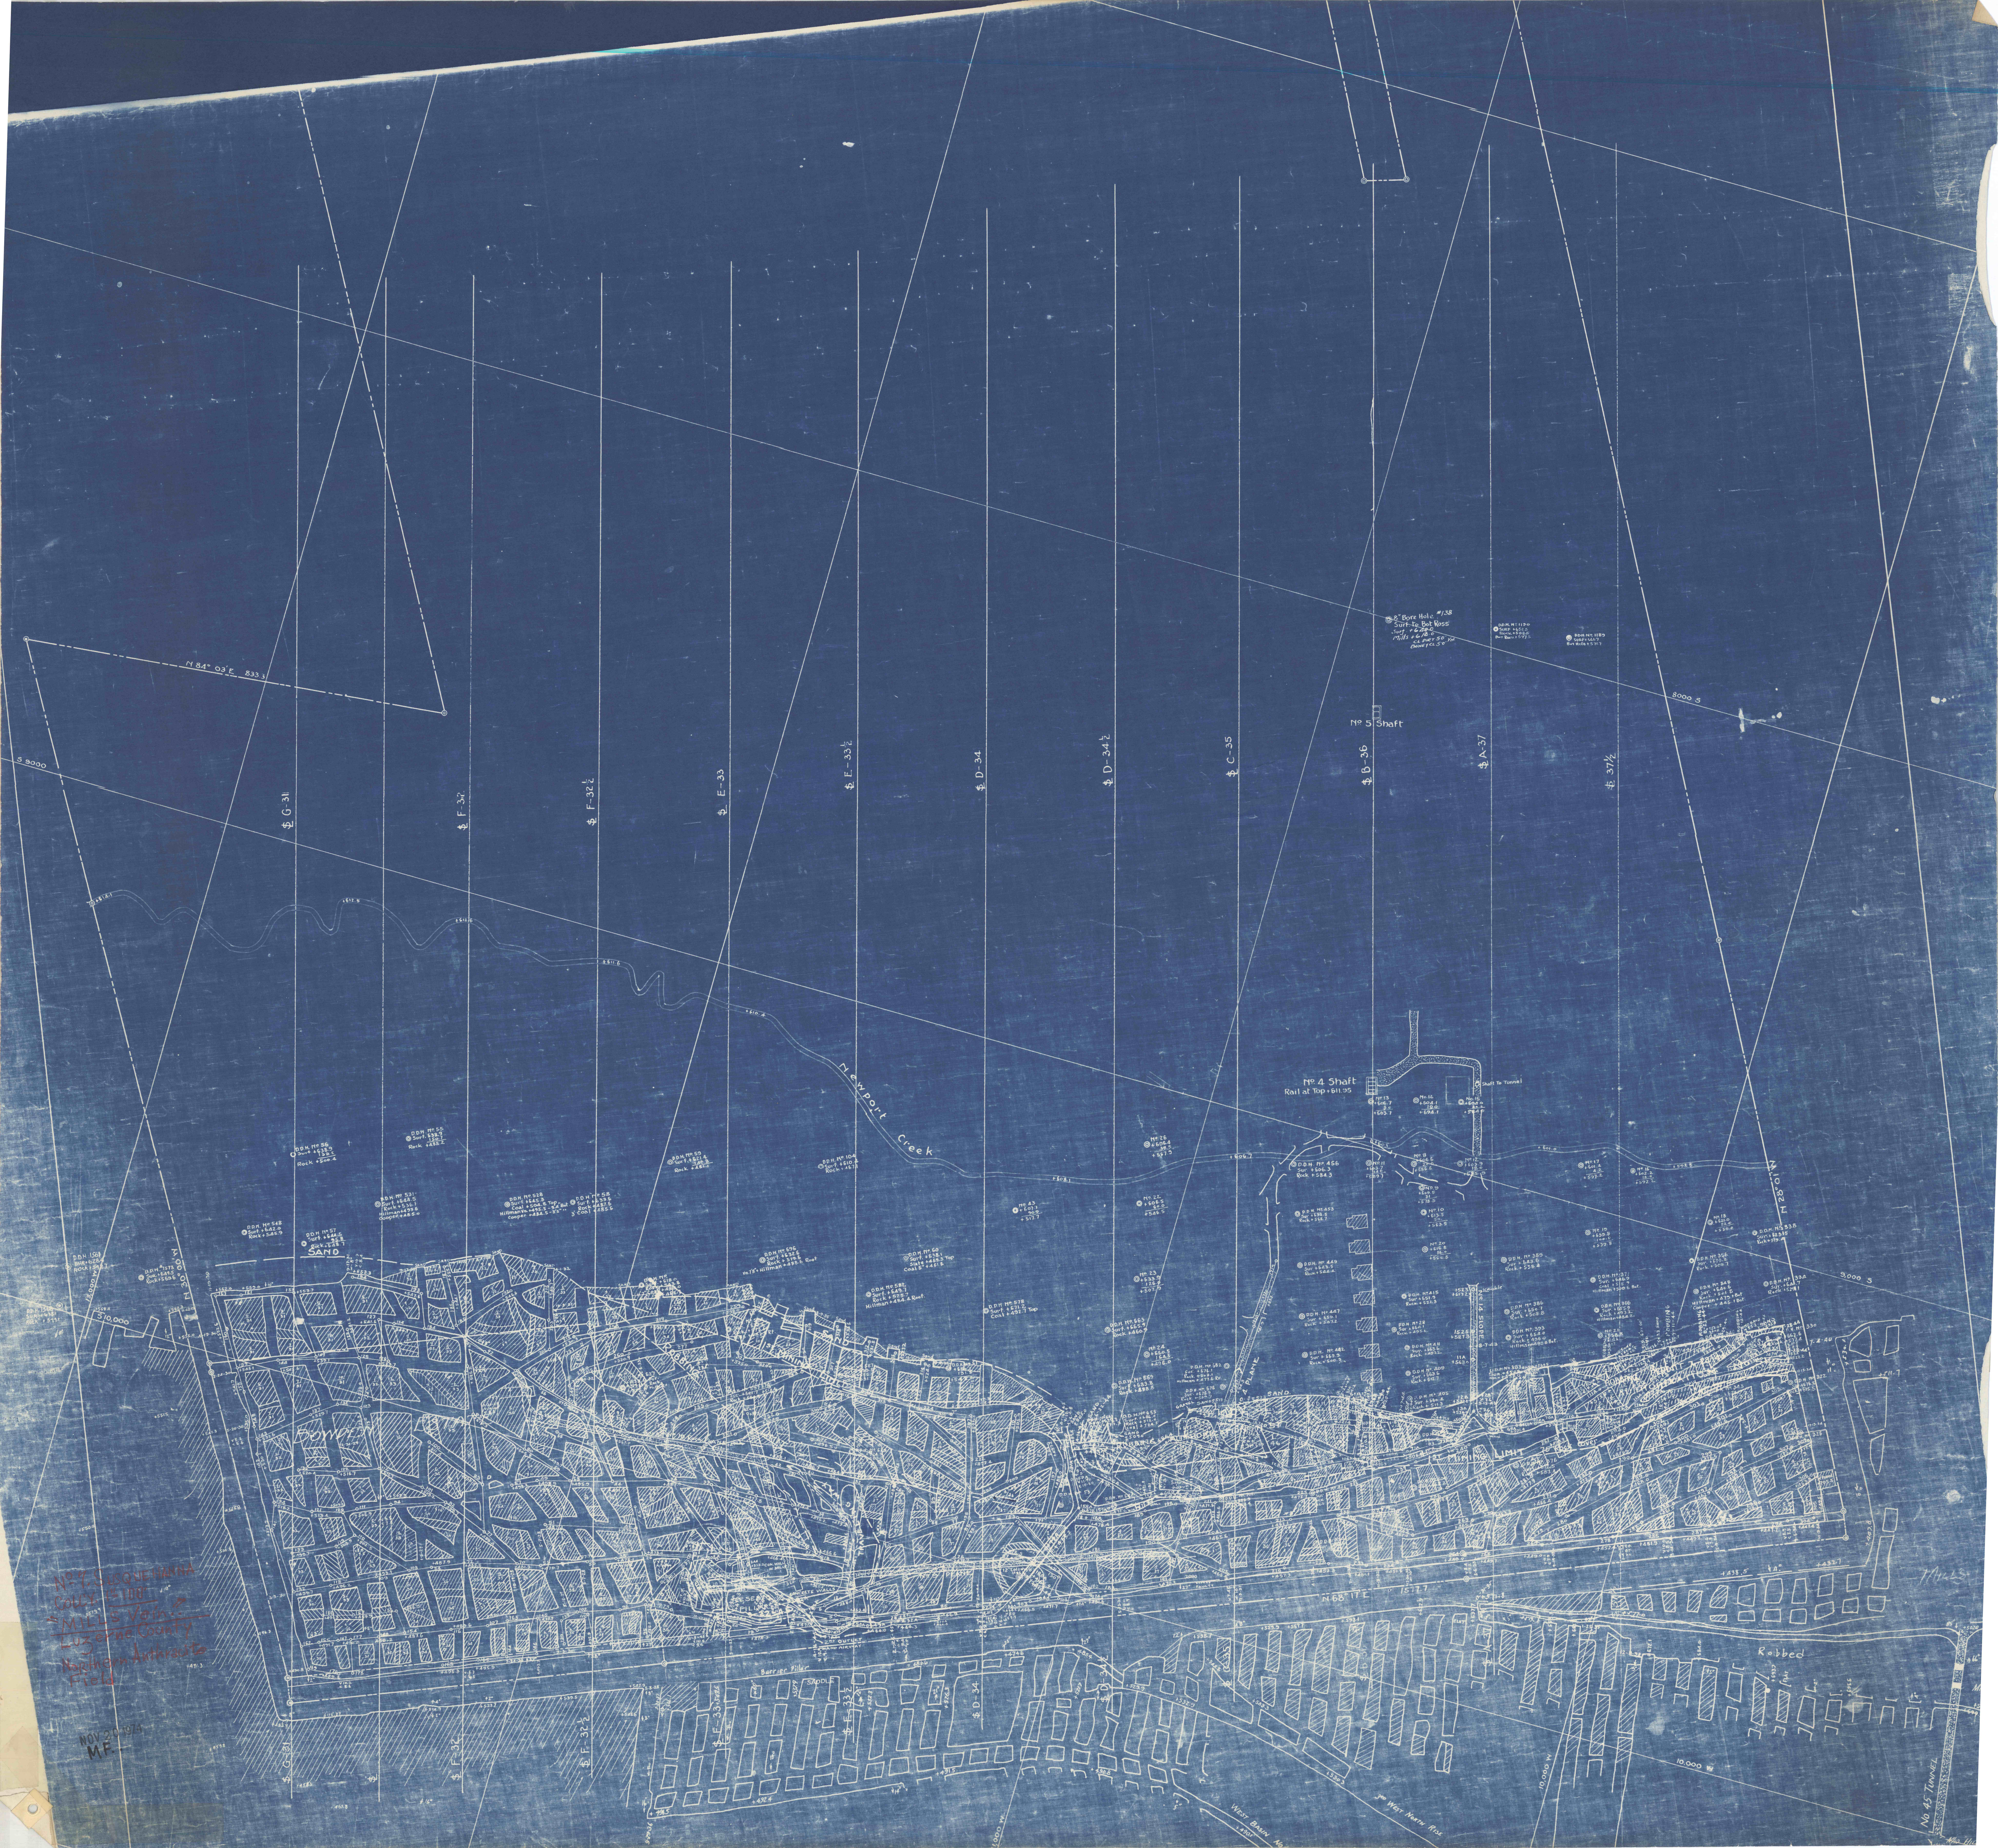

N.P. SUGQUEHANNA
COAL FIELD
Luzerne County
Northern Anthracite
Field

NOV 20 1914
M.F.