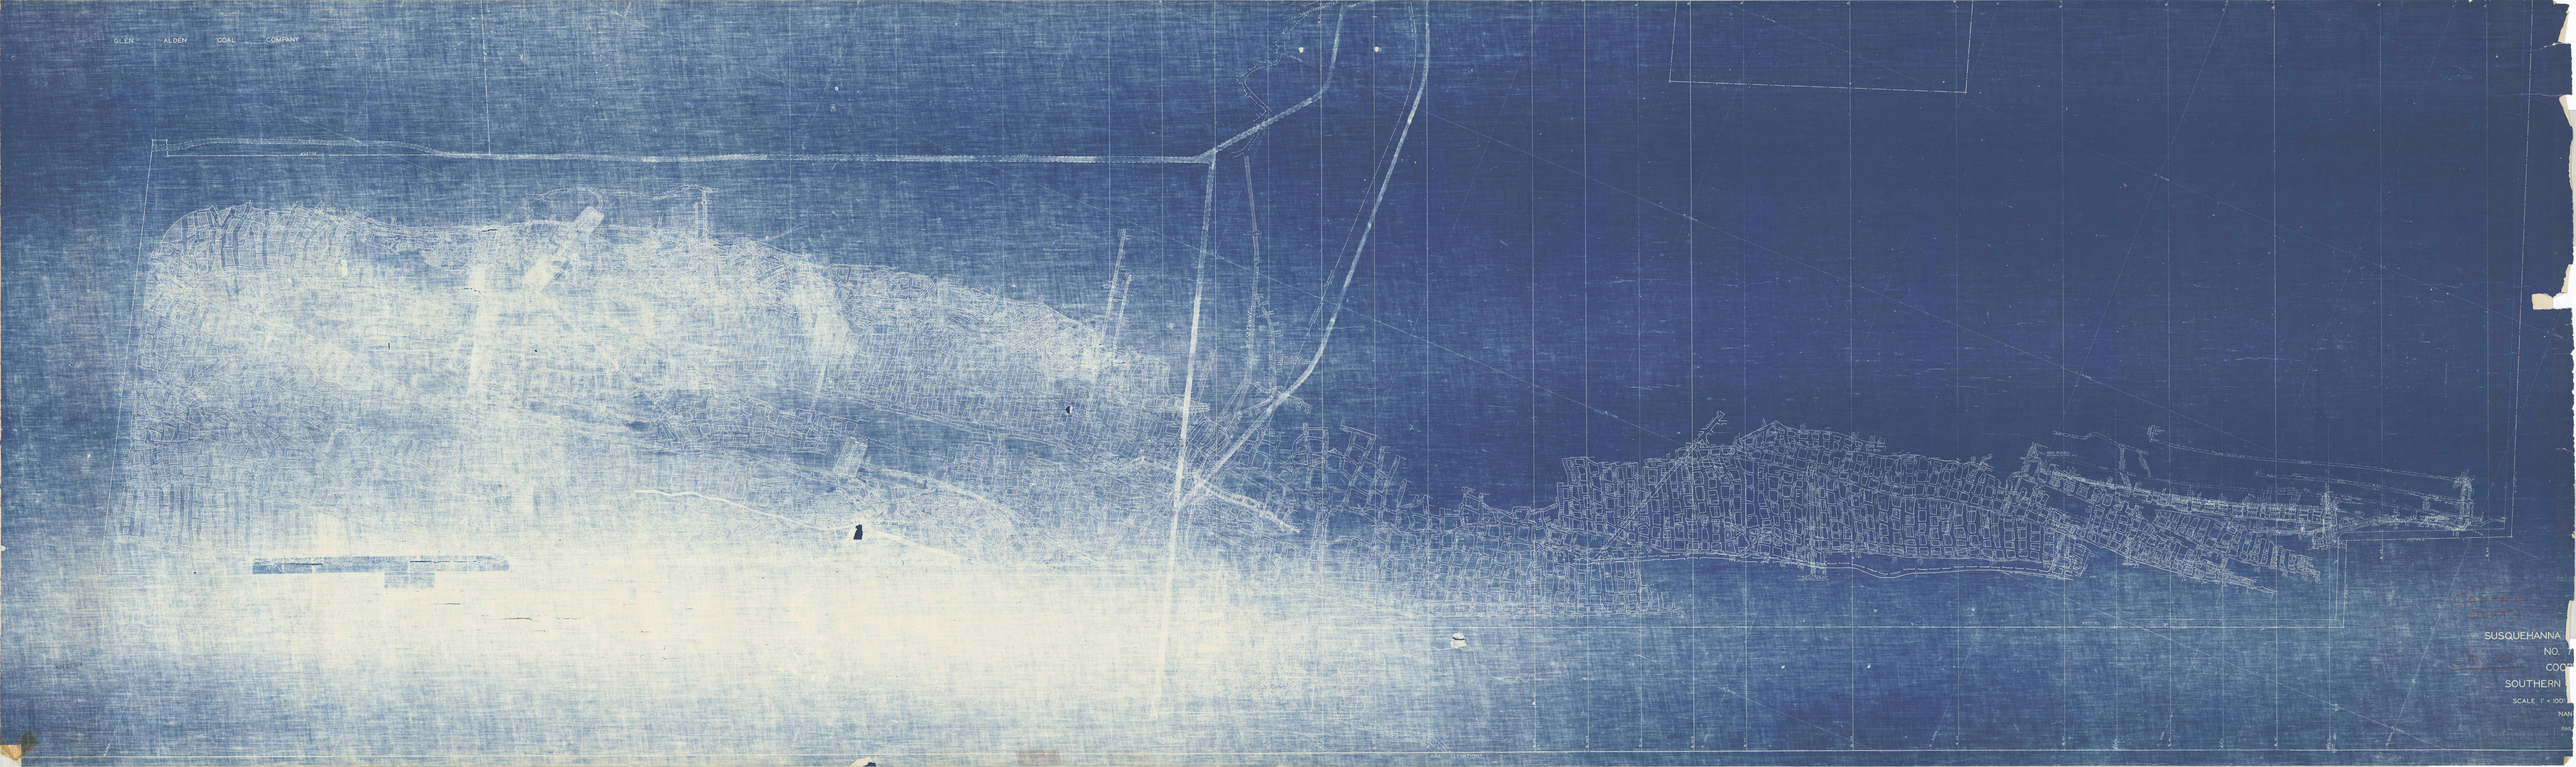

GLEN ALDEN COAL COMPANY
SUSQUEHANNA
NO.
COC
SOUTHERN
SCALE 1" = 100
NAN