


Northern COAL FIELD:
SEVEN Colliery.. COOPER VEIN, 1 1/2 100'
HANOVER TWP, LUZERNE COUNTY,
NANTICOKE, PA, SUSQUEHANNA COLLIERIES.

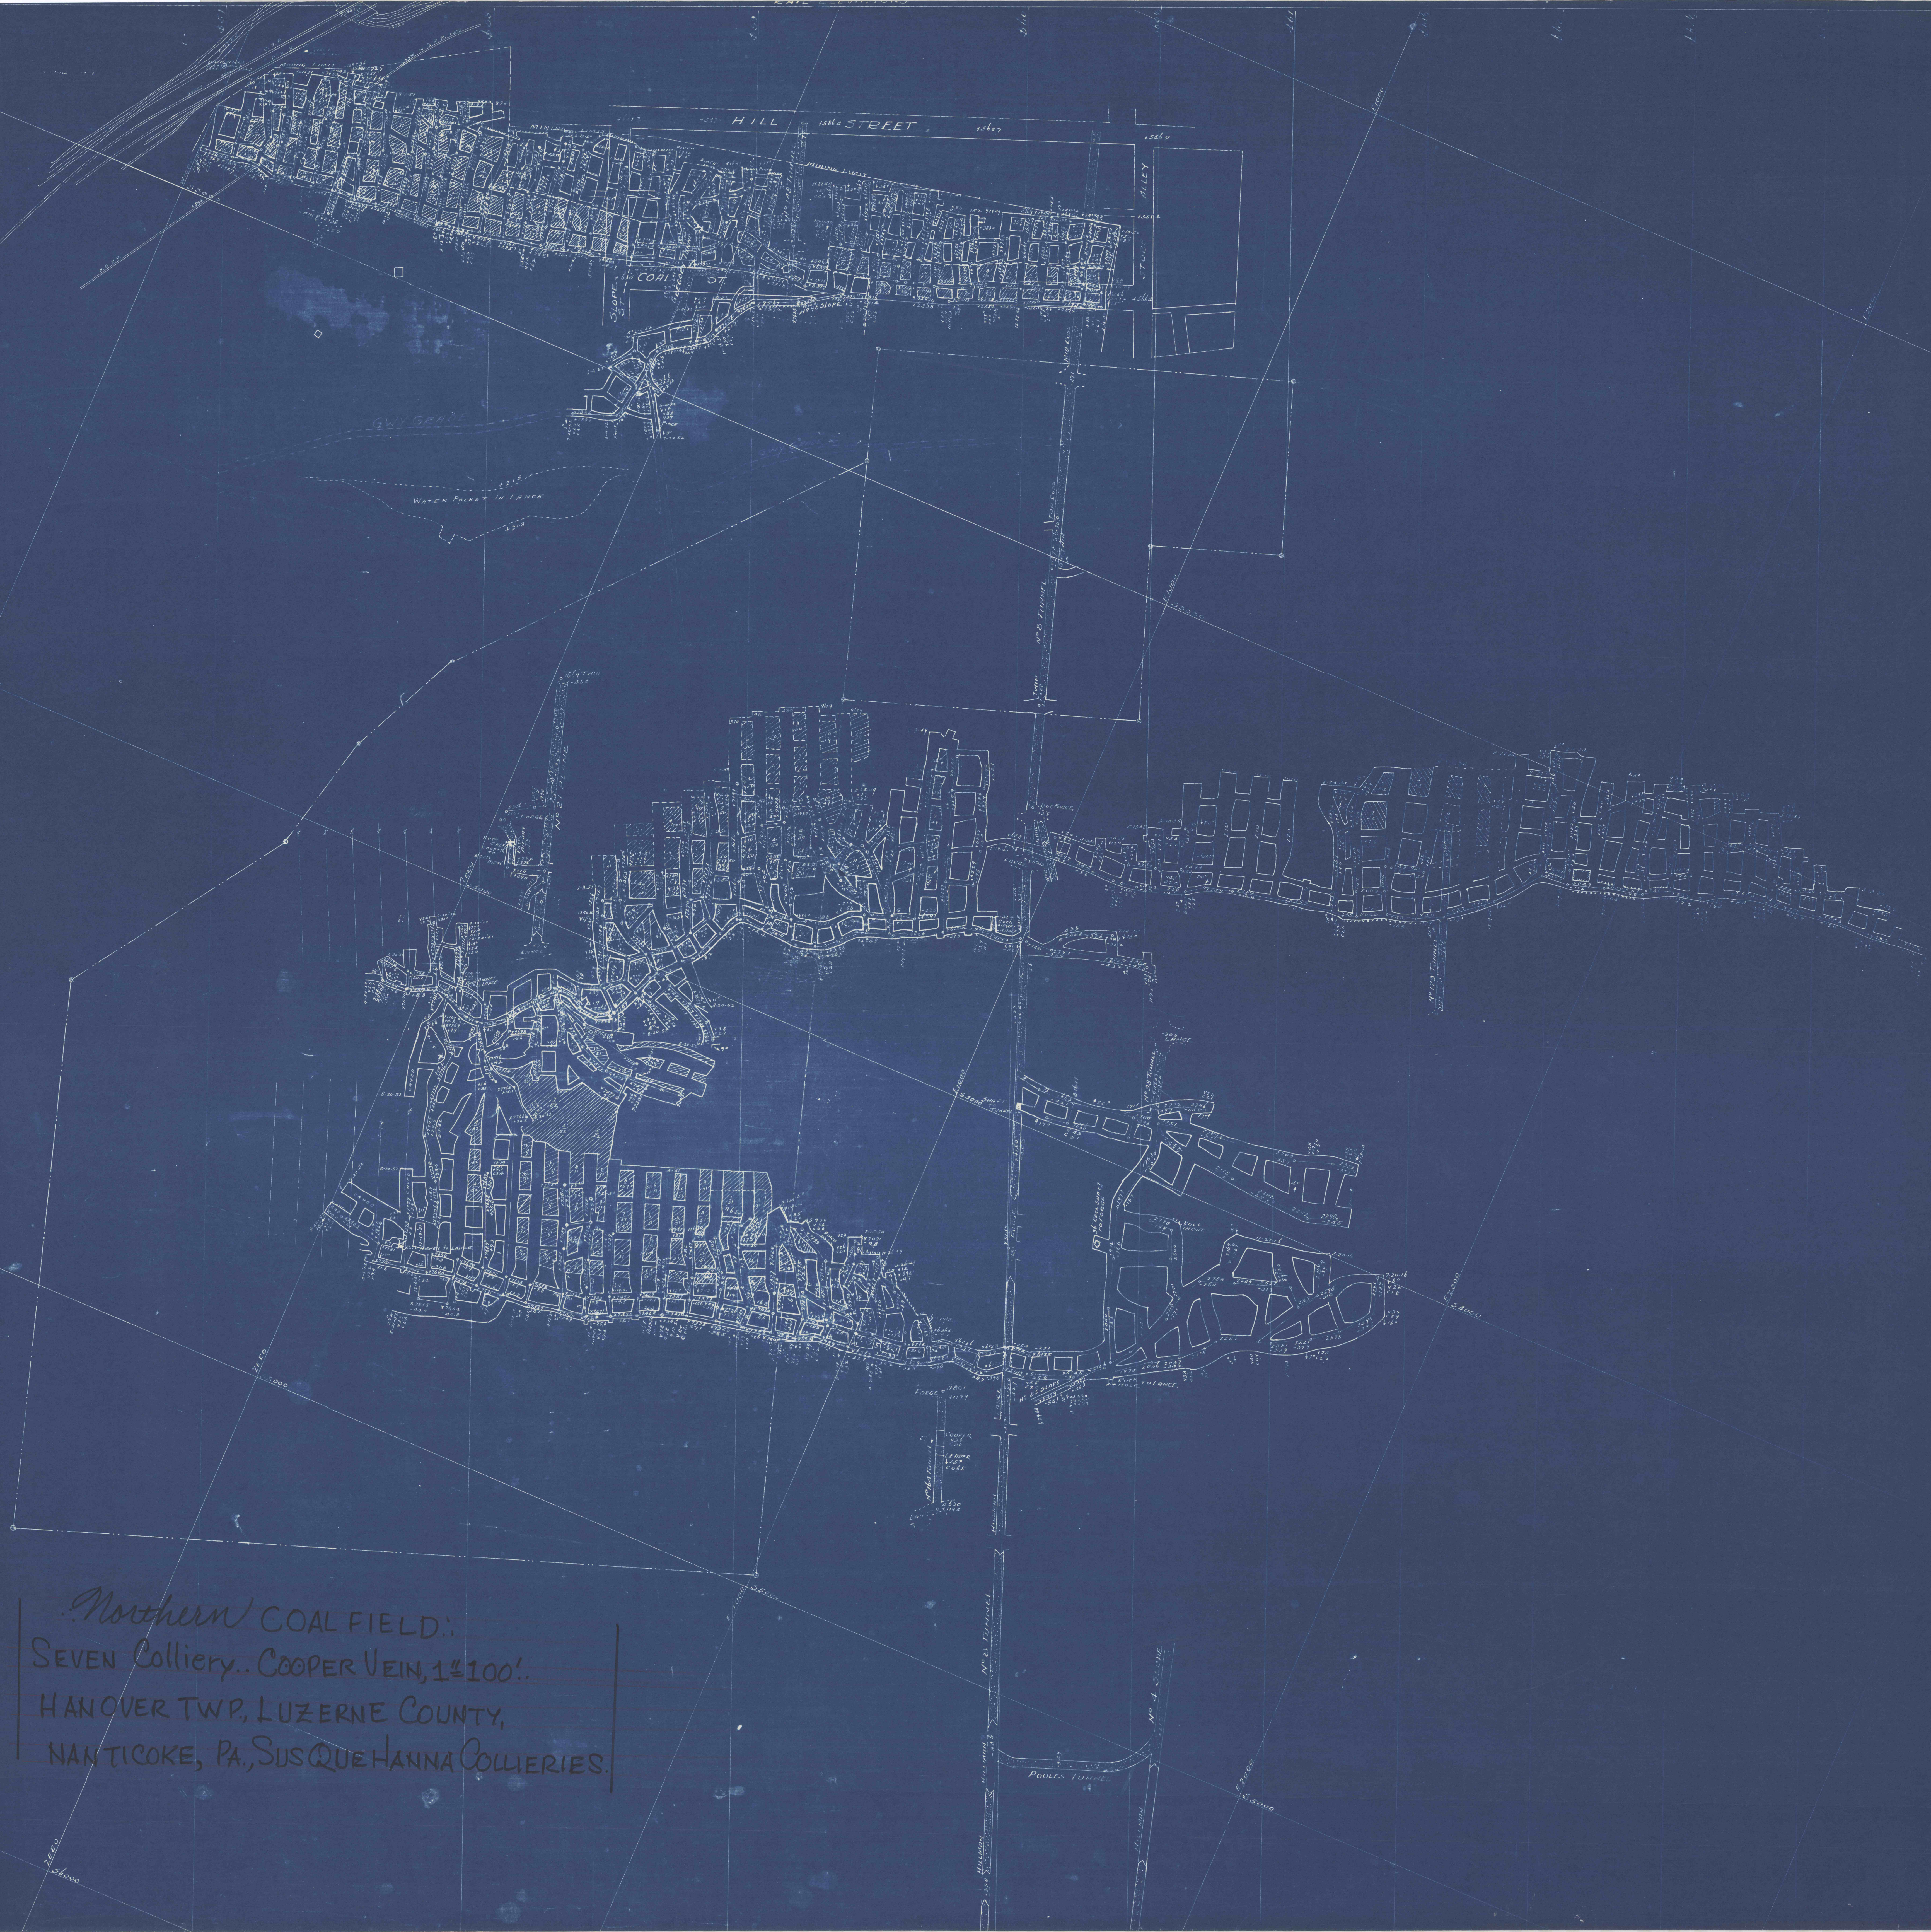

MF
NOV 20 1972