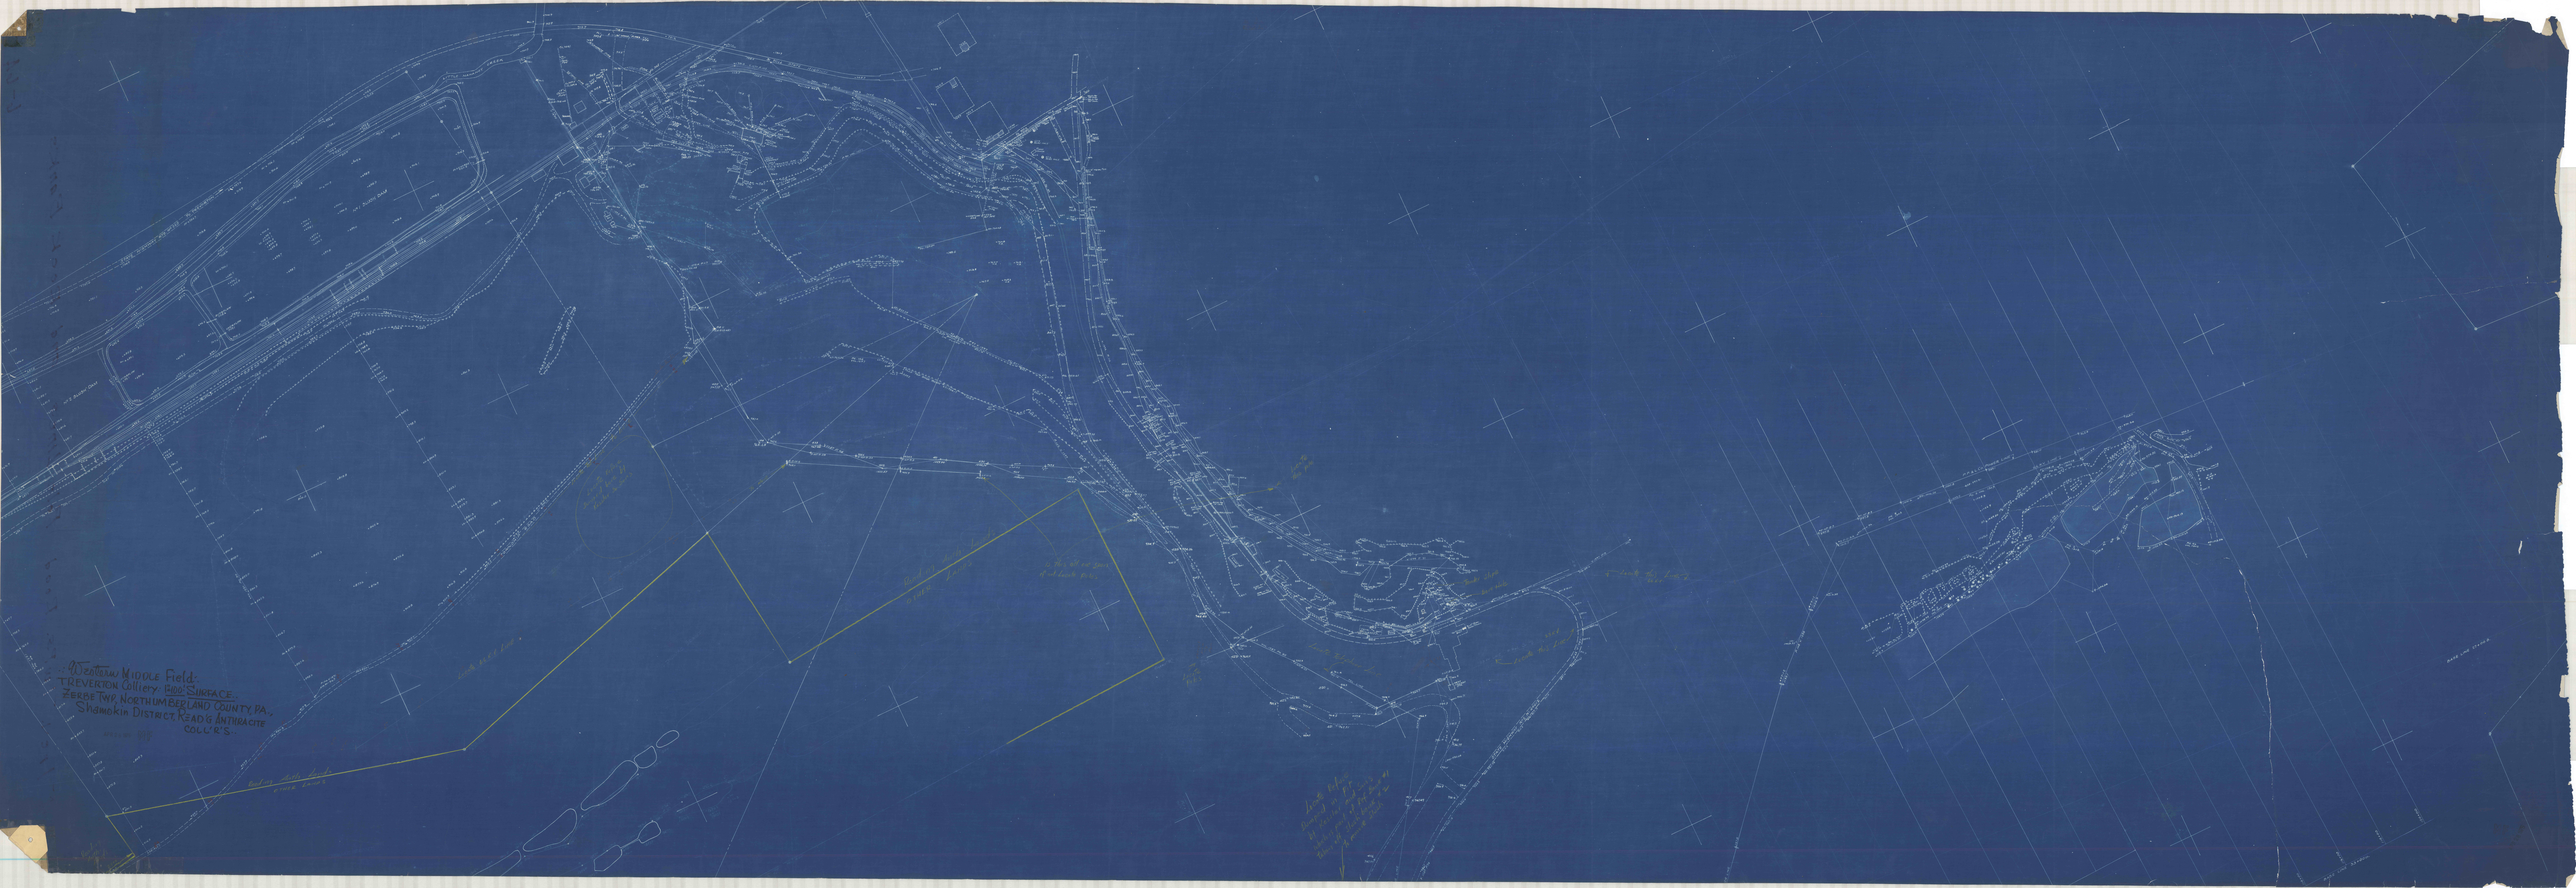

Western Middle Field
Treverton Colliery Plan of Surface
Zerbe Twp. Northumberland County, Pa.
Shamokin District, Read's Anthracite
Coll'r's.