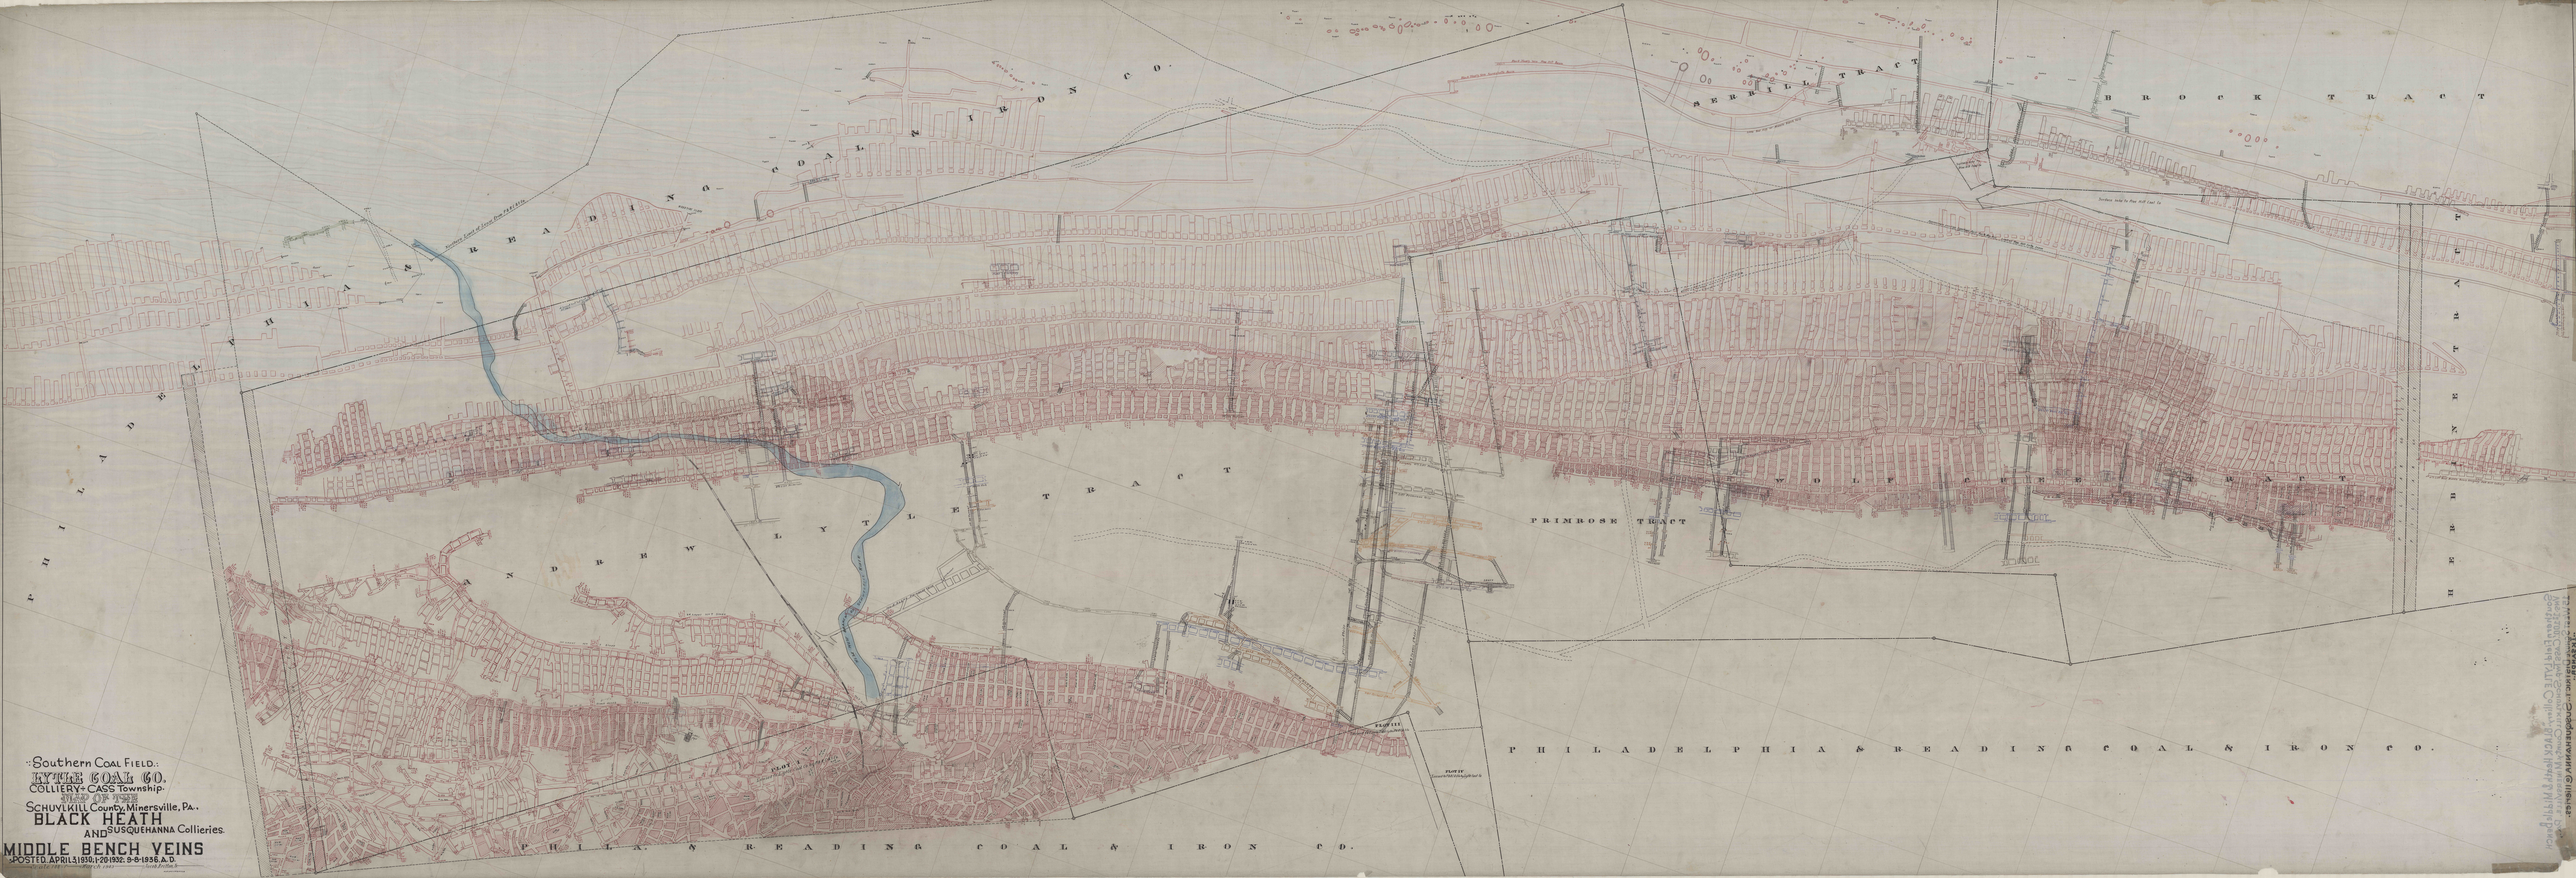

PHILADELPHIA & READING COAL & IRON CO.
SERRILL TRACT
BROCK TRACT
ANDREW LYTLE TRACT
PRIMROSE TRACT
WOLF CREEK TRACT
HERBERT TRACT
PHILA. & READING COAL & IRON CO.
PHILADELPHIA & READING COAL & IRON CO.
Southern Coal Field:
LYTLE COAL CO.
COLLIERY - CASS Township
Schuylkill County, Minersville, Pa.
BLACK HEATH
AND SUSQUEHANNA Collieries.
MIDDLE BENCH VEINS
POSTED APRIL 5, 1930, 1-20-1932, 8-8-1936, A. D.