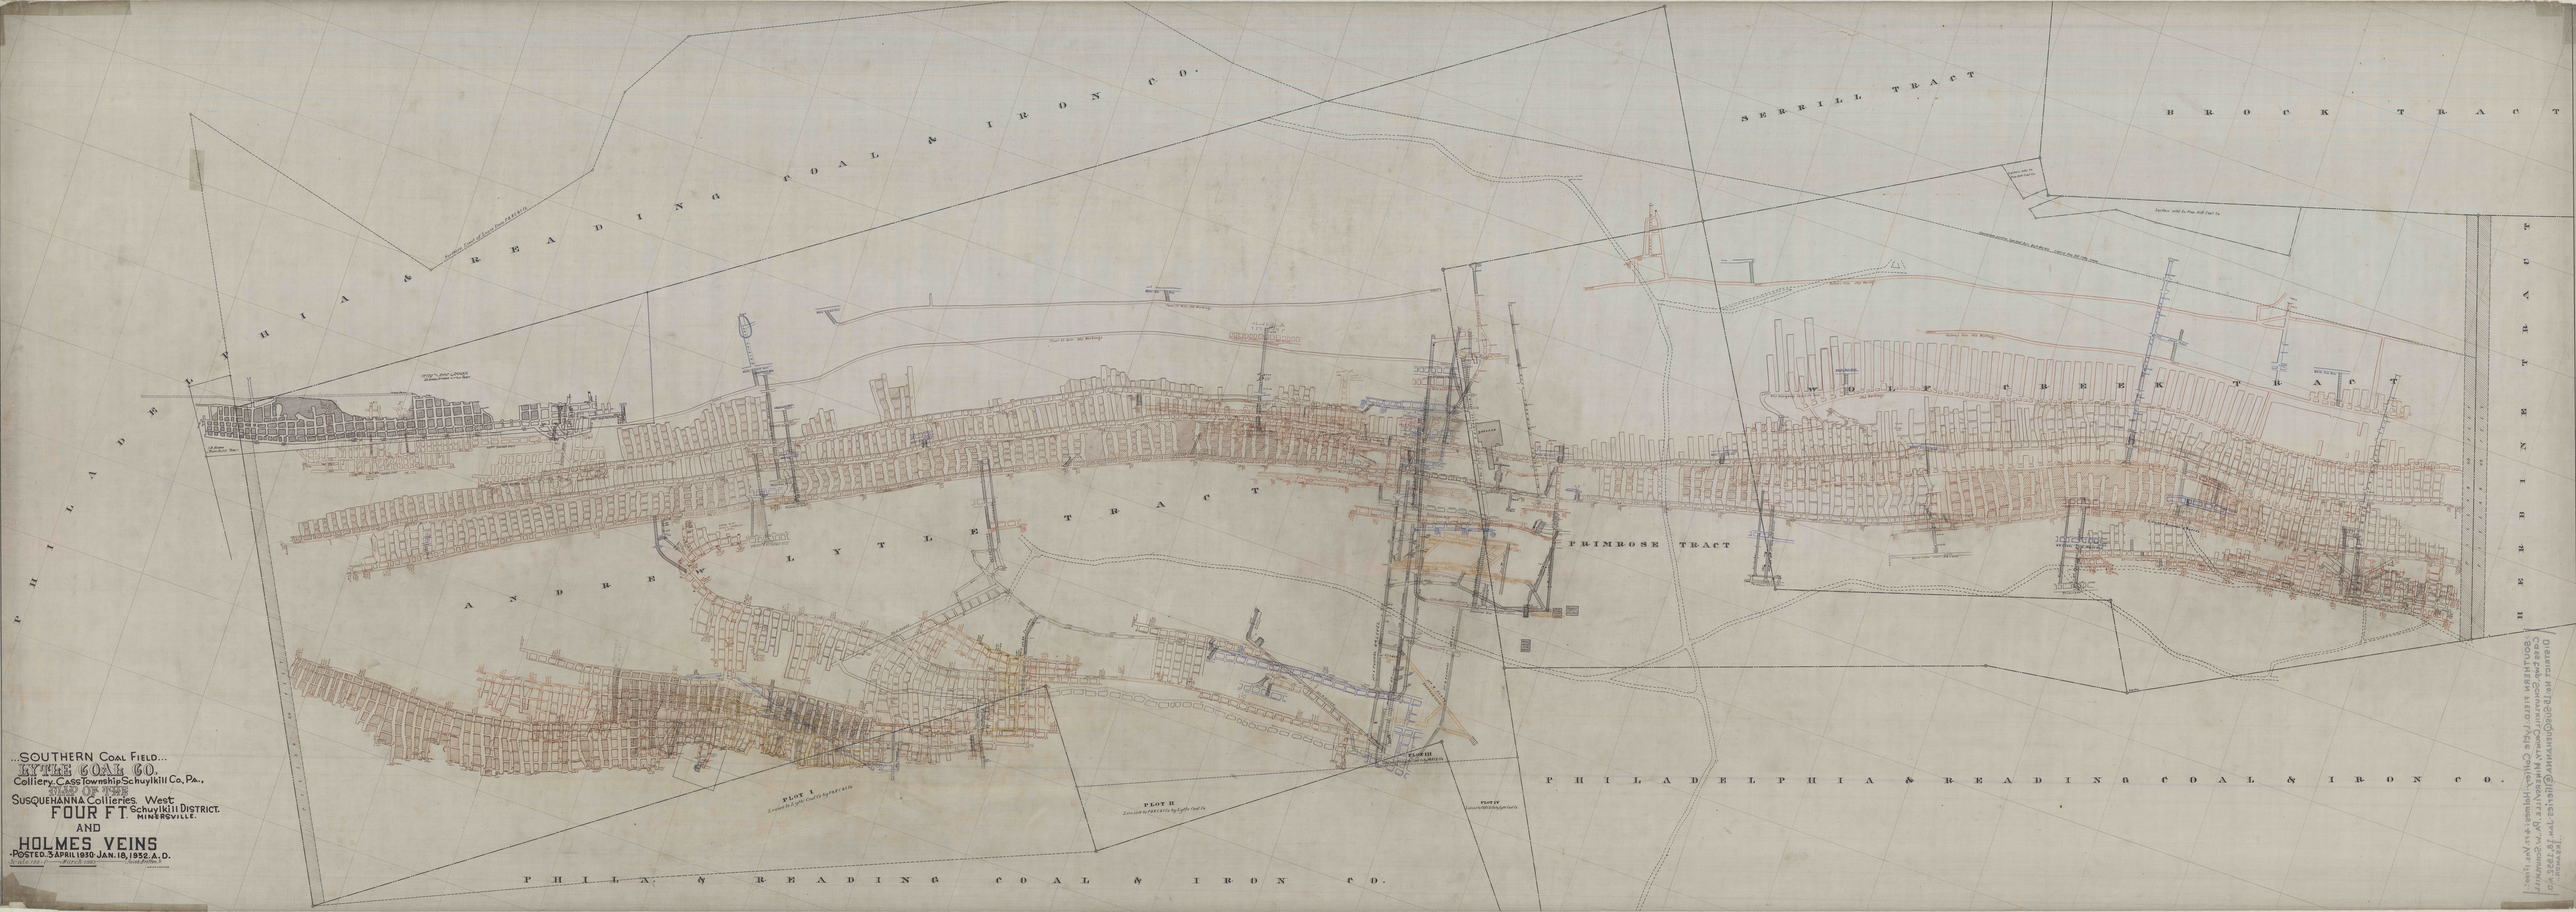

PHILADELPHIA & READING COAL & IRON CO.
SERRILL TRACT
BROCK TRACT
WOLF CREEK TRACT
LYTLE TRACT
ANDREW
PRIMROSE TRACT
PHILADELPHIA & READING COAL & IRON CO.
PHILA. & READING COAL & IRON CO.
PLOT I
PLOT II
PLOT IV
SOUTHERN Coal Field...
LYTLE COAL CO.
Colliery, Cass Township Schuylkill Co, Pa.,
MAP OF THE
Susquehanna Collieries West
FOUR FT. Schuylkill DISTRICT.
MINERSVILLE.
AND
HOLMES VEINS
POSTED 5 APRIL 1930 JAN. 18, 1952 A.D.