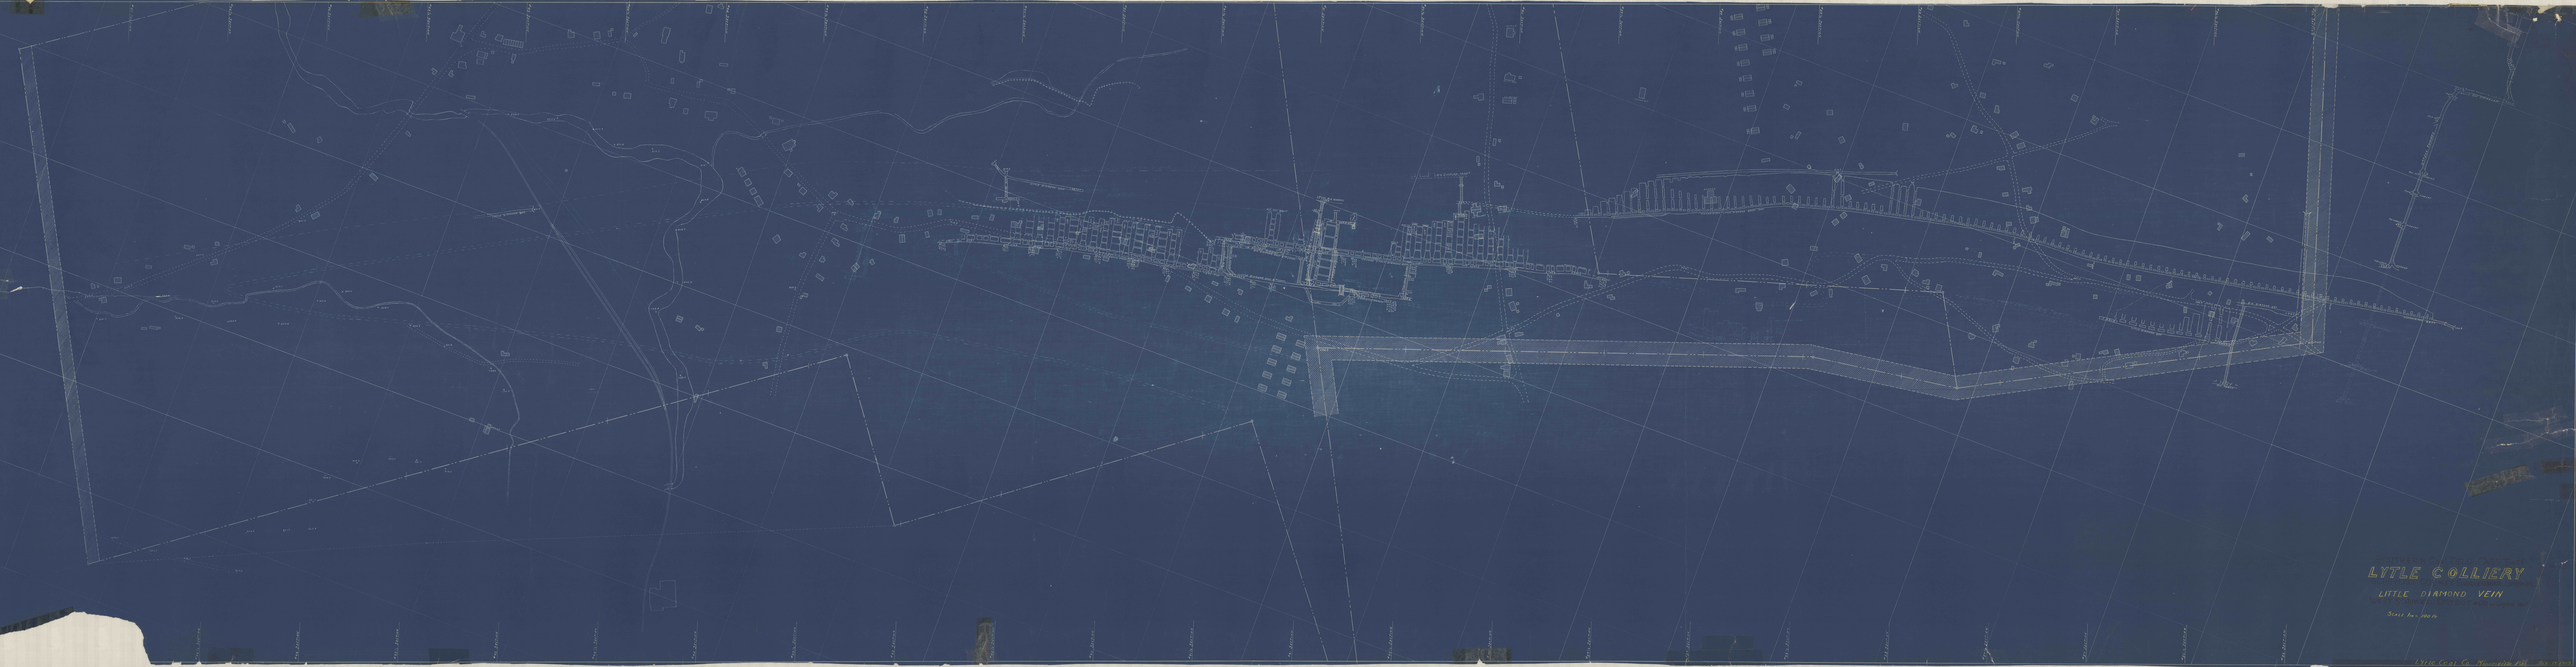

LYTLE COLLIERY
LITTLE DIAMOND VEIN