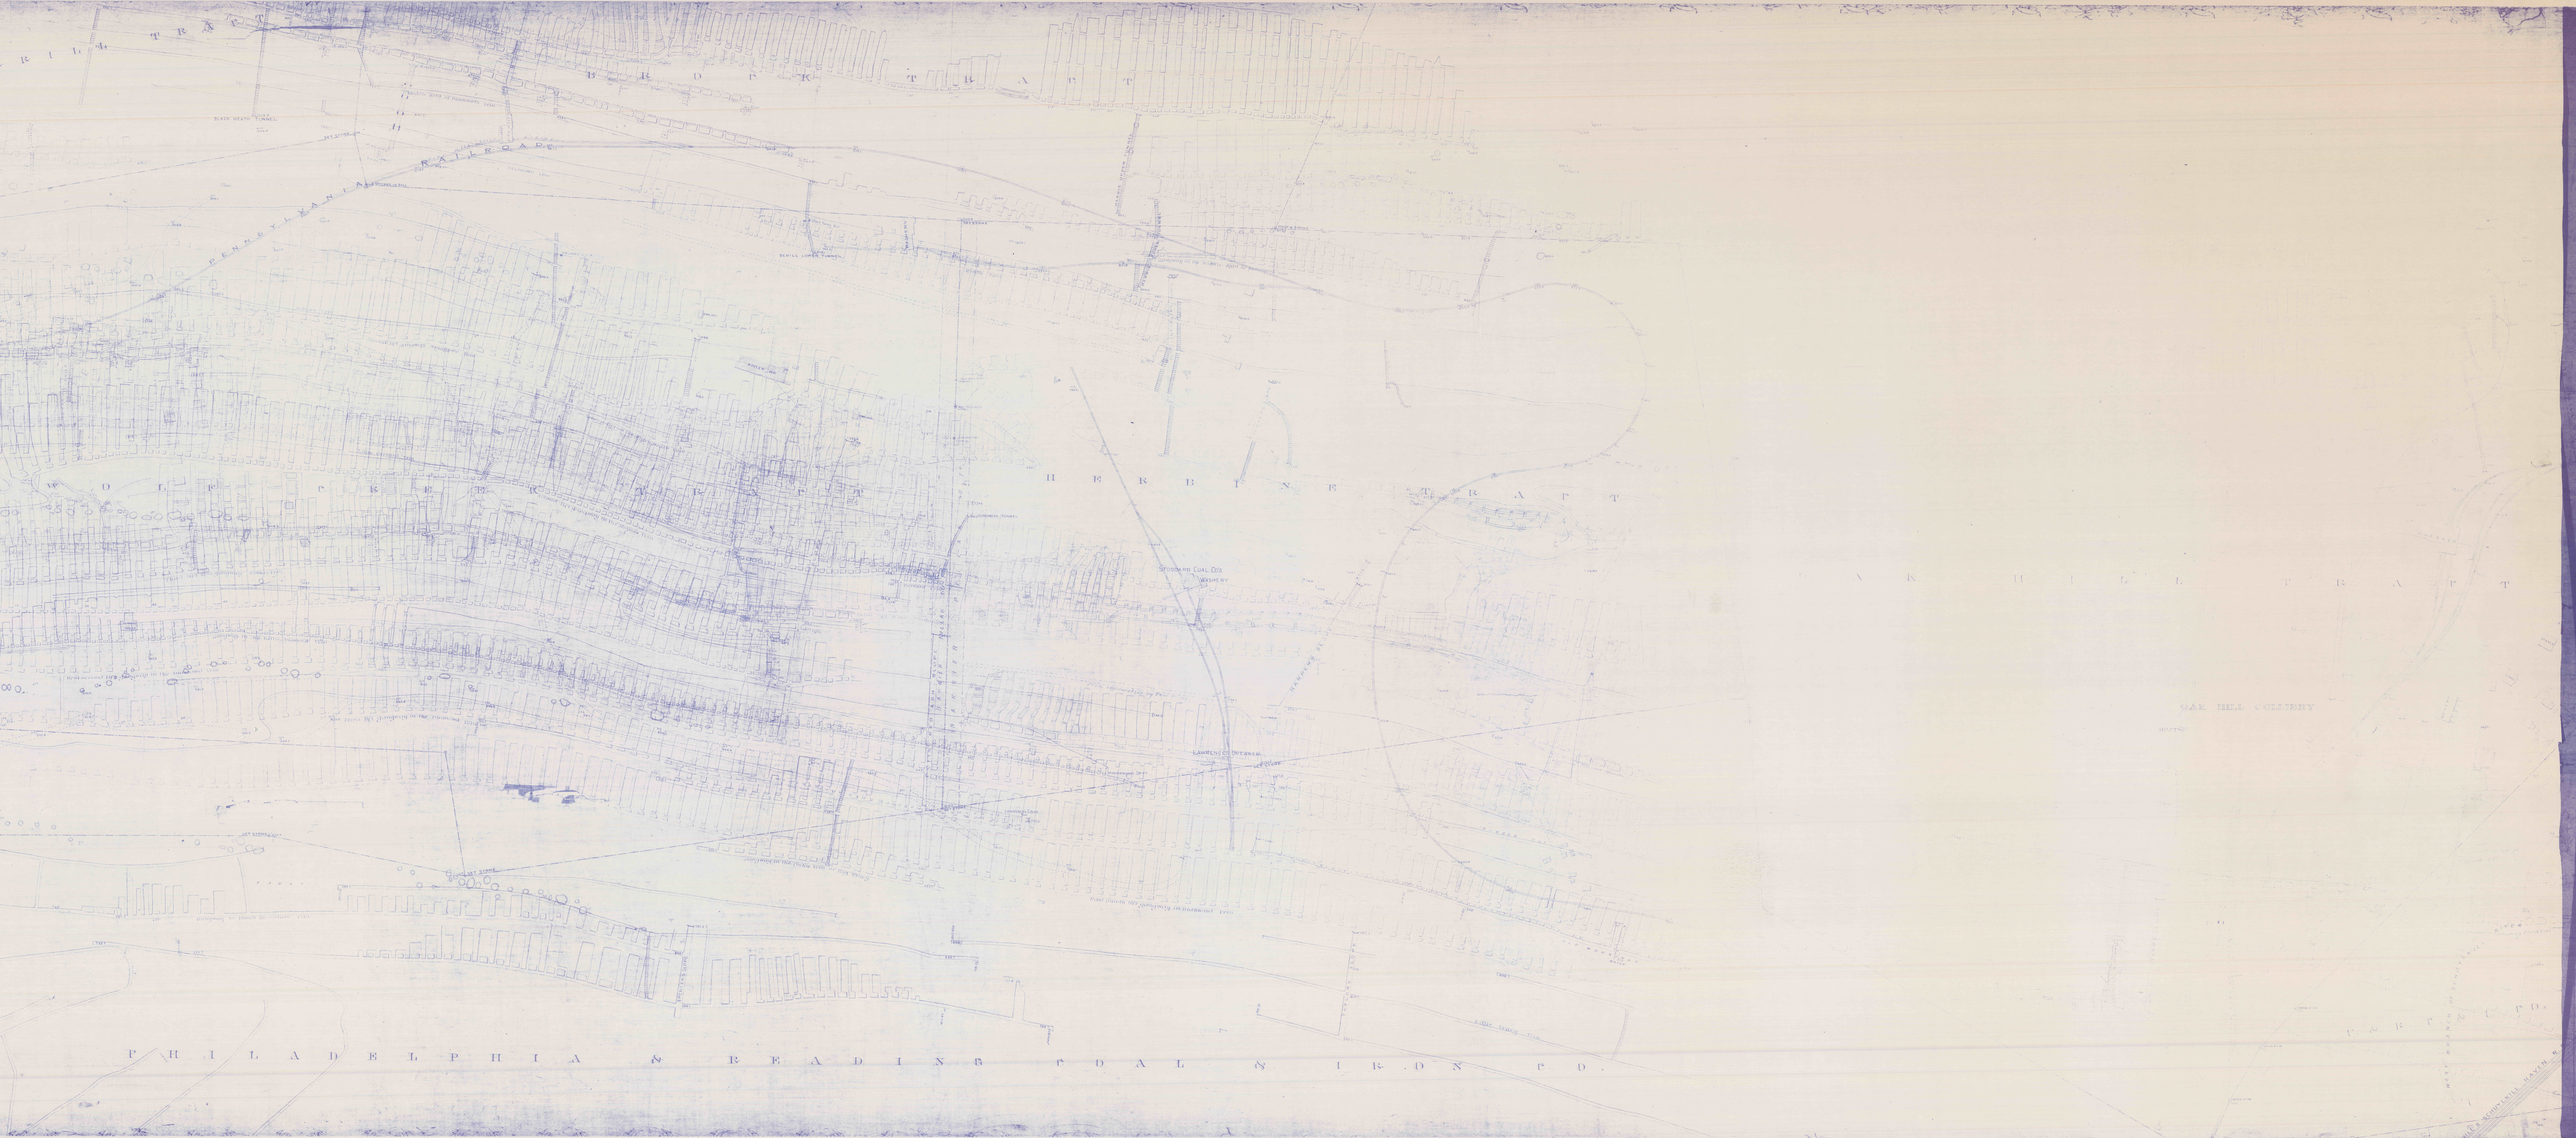
BERDEK TRACT
PENNSYLVANIA RAILROAD
HERBERT TRACT
STOCKWELL COAL CO'S WASHERY
LAWRENCE CONTINUED
PHILADELPHIA & READING COAL & IRON CO.