


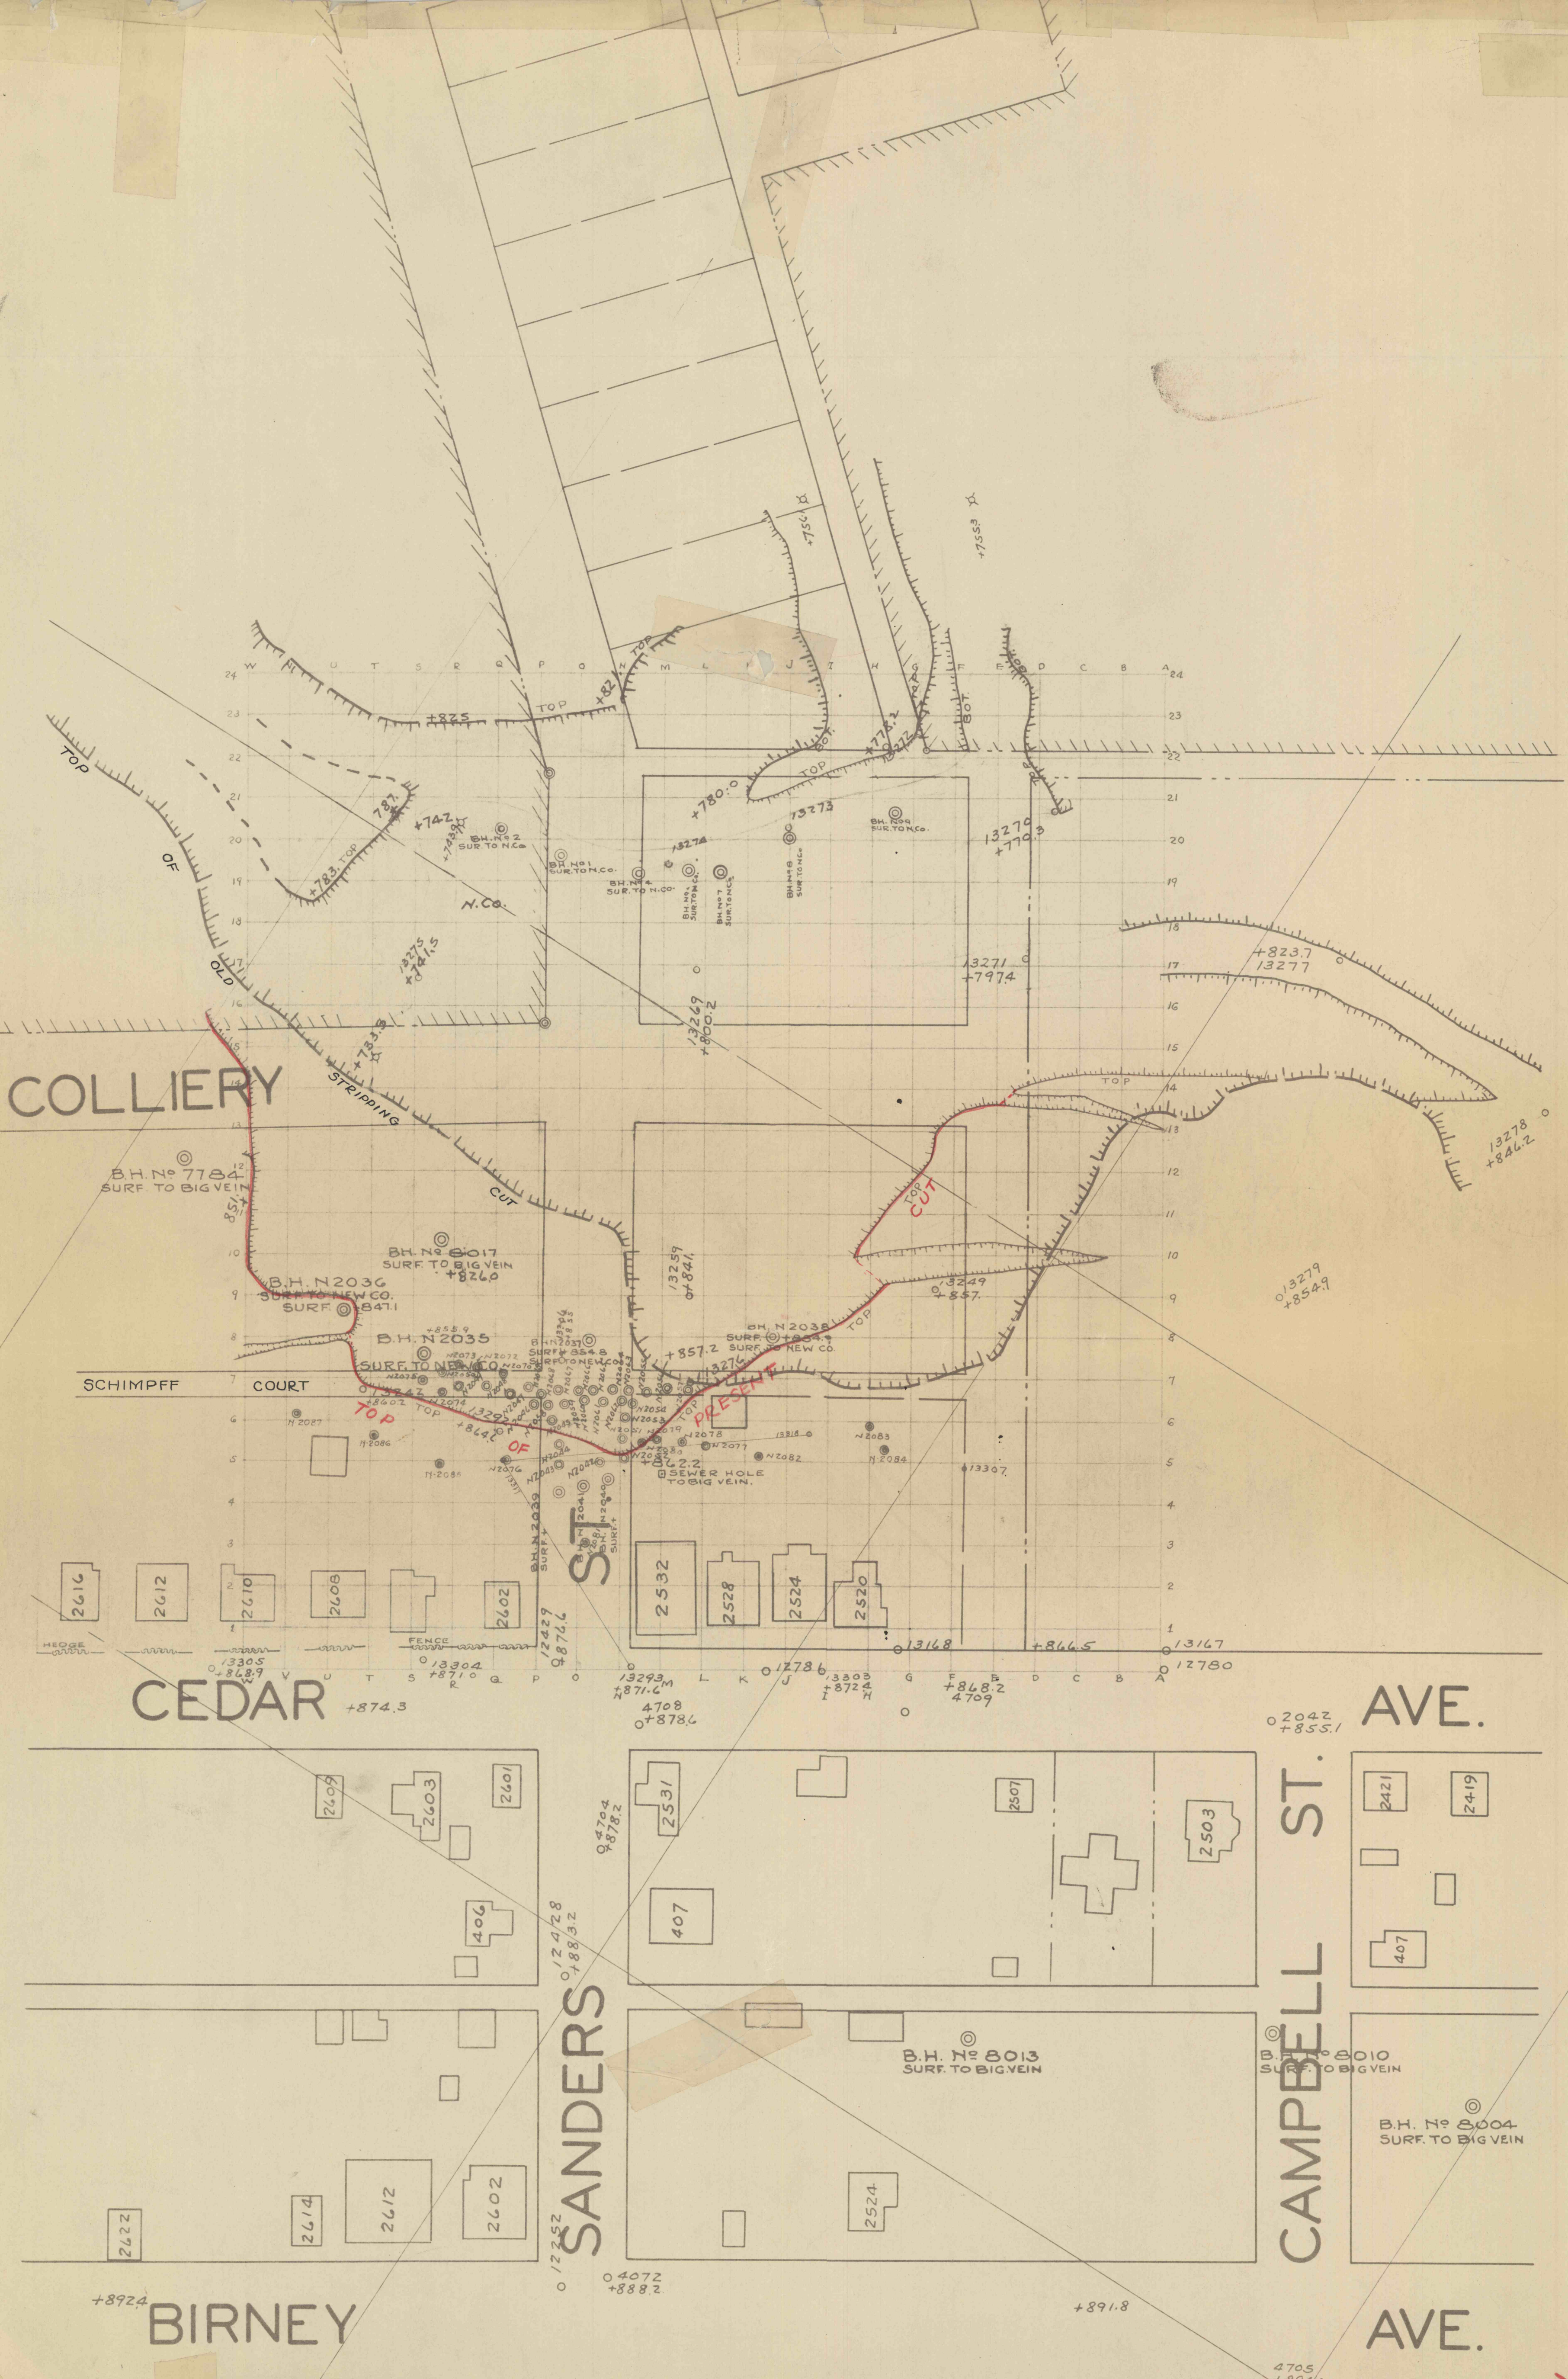

..NORTHERN FIELD..
NATIONAL COLLY
SURFACE LACKAWANNA TWP.,
CEDAR AVE. FIRE LACKA., COUNTY PA..
SCALE 1"=50'

1"=50'