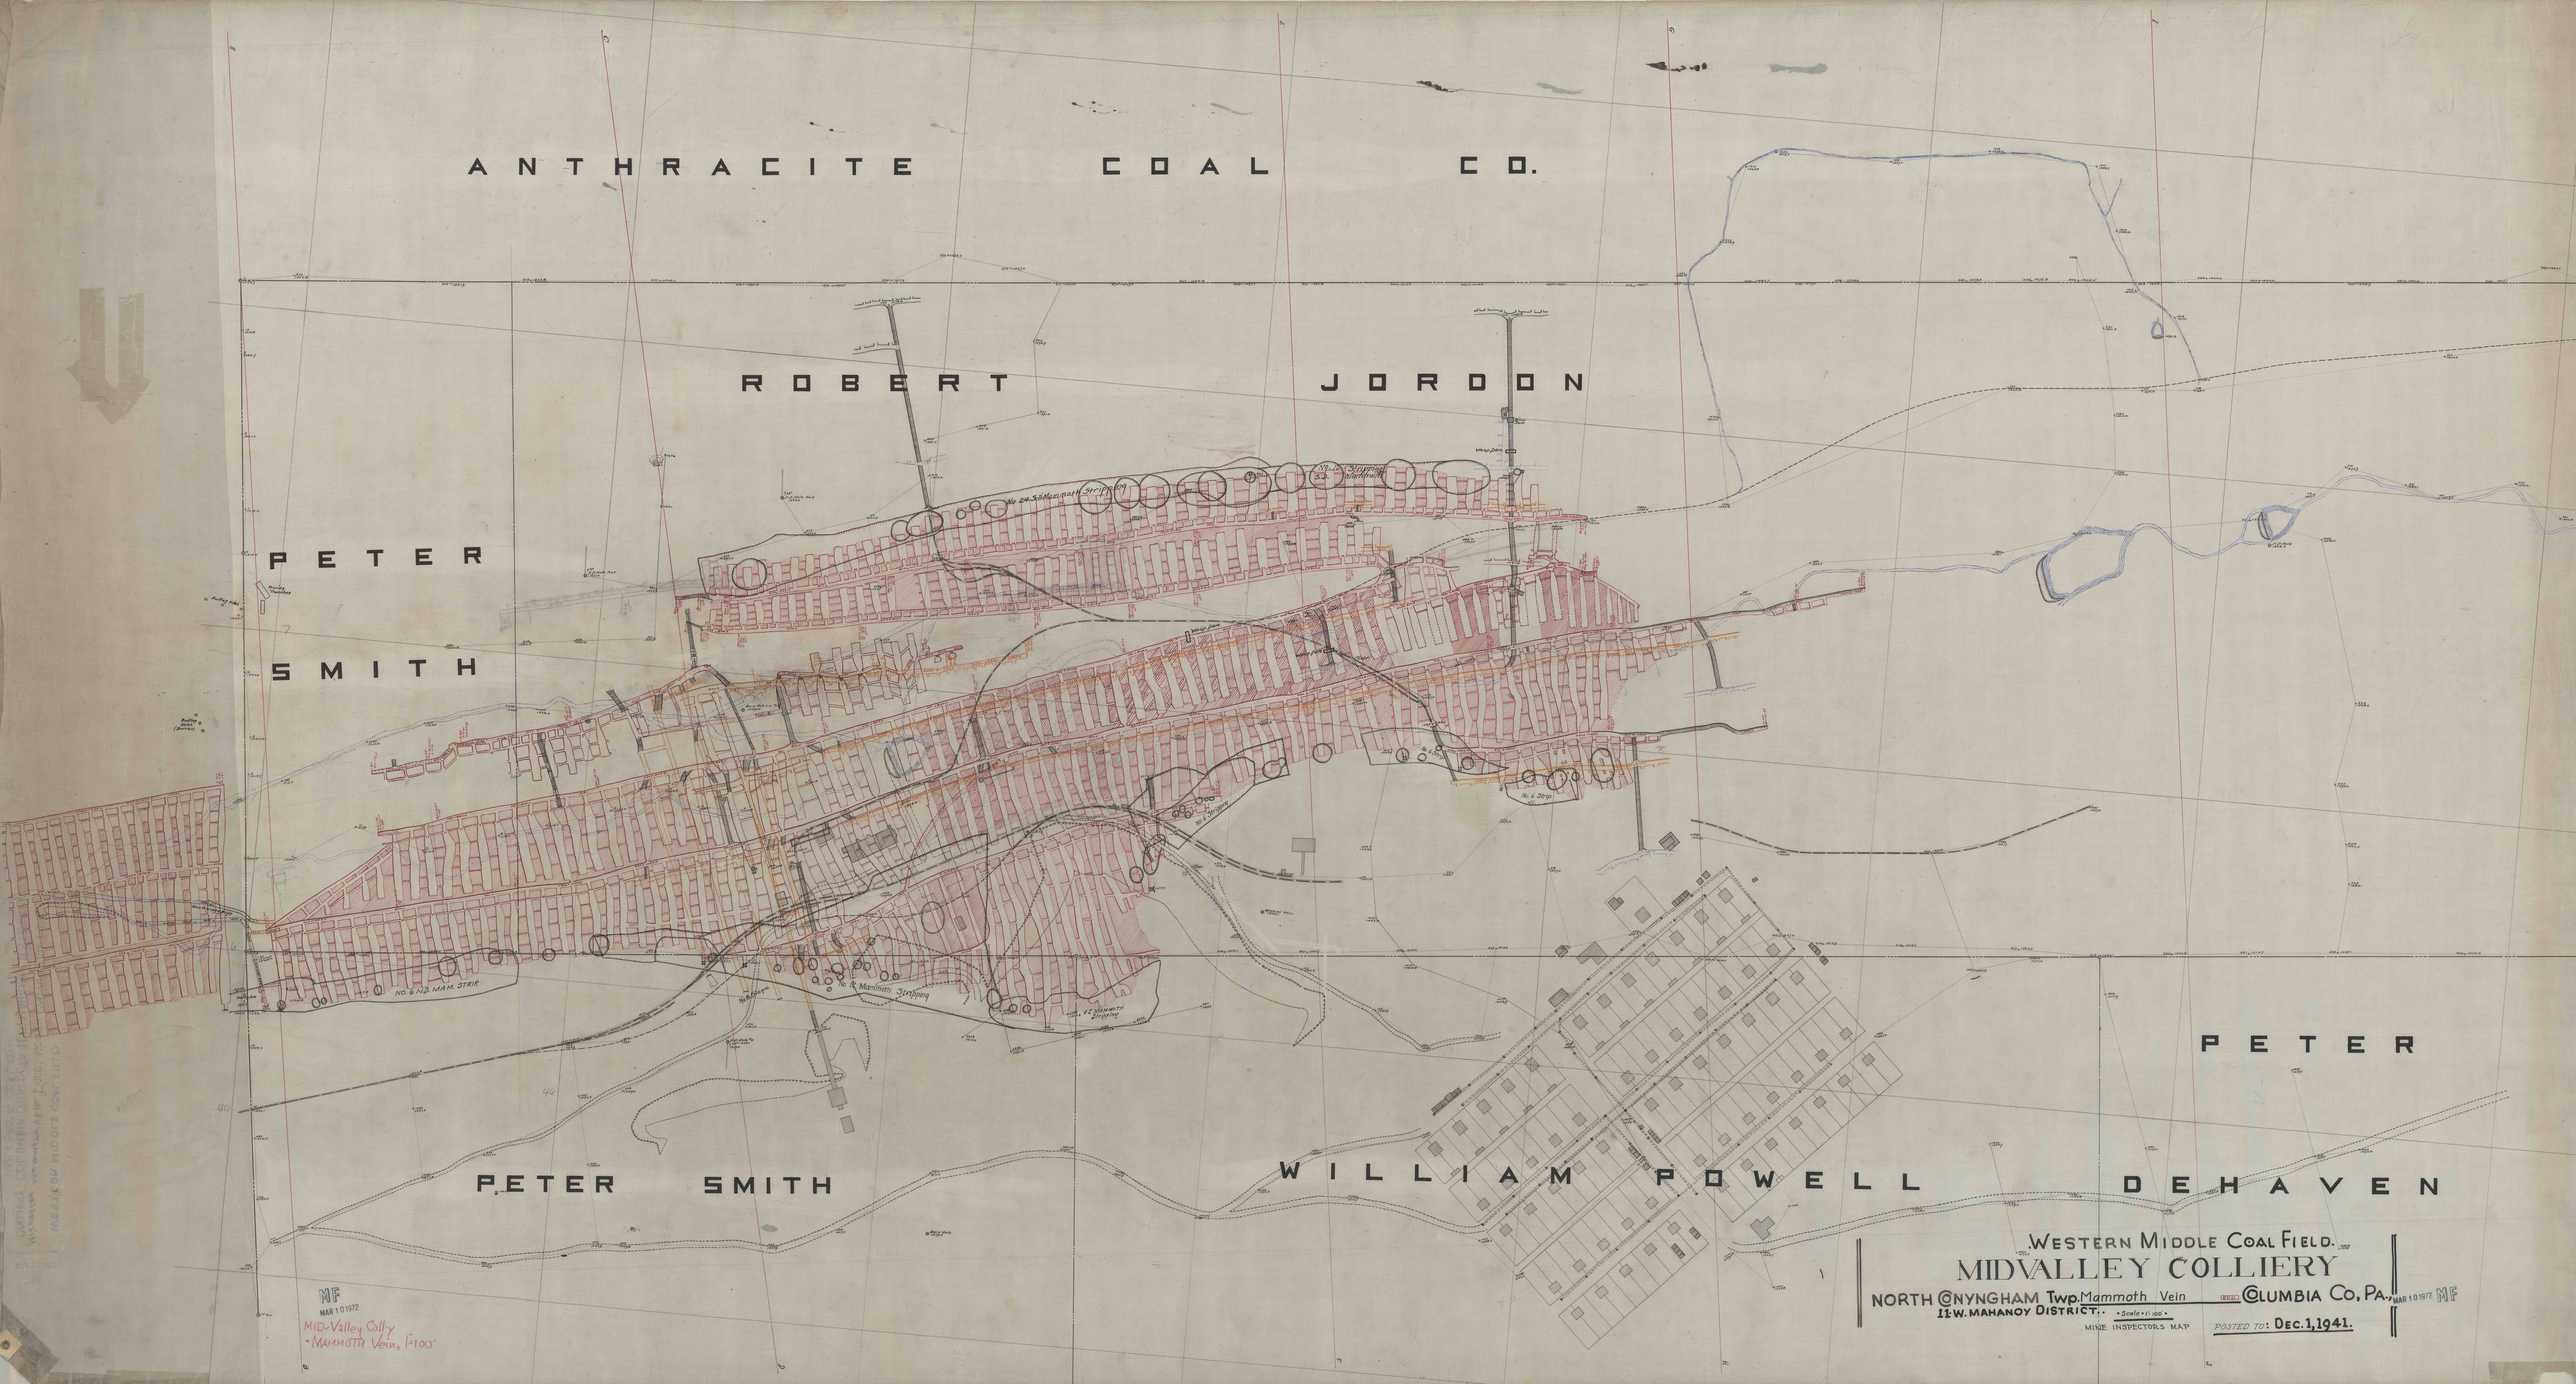

ANTHRACITE COAL CO.
ROBERT JORDON
PETER SMITH
PETER SMITH
WILLIAM POWELL
PETER DEHAVEN
No 24 S.D. Mammoth Stripping
No. 16 Stripping S.D. Mammoth
Brick Dam
Wood Dam
P.P. Hole No. 3
NO. 6 N.D. MAM. STRIP.
No. 12 Mammoth Stripping
No. 8 Slope
#2 MAMMOTH Stripping
No. 6 Strip.
Bore Hole
P.P. Hole #4
46

WESTERN MIDDLE COAL FIELD.

MIDVALLEY COLLIERY

NORTH CONYNGHAM Twp. Mammoth Vein COLUMBIA Co, PA.

11-W. MAHANOY DISTRICT. • Scale • 1" = 100' •

MINE INSPECTORS MAP POSTED TO: Dec. 1, 1941.

MAR 10 1972 MF

MF
MAR 10 1972

MID-Valley Coll'y
• MAMMOTH Vein, 1" = 100'