


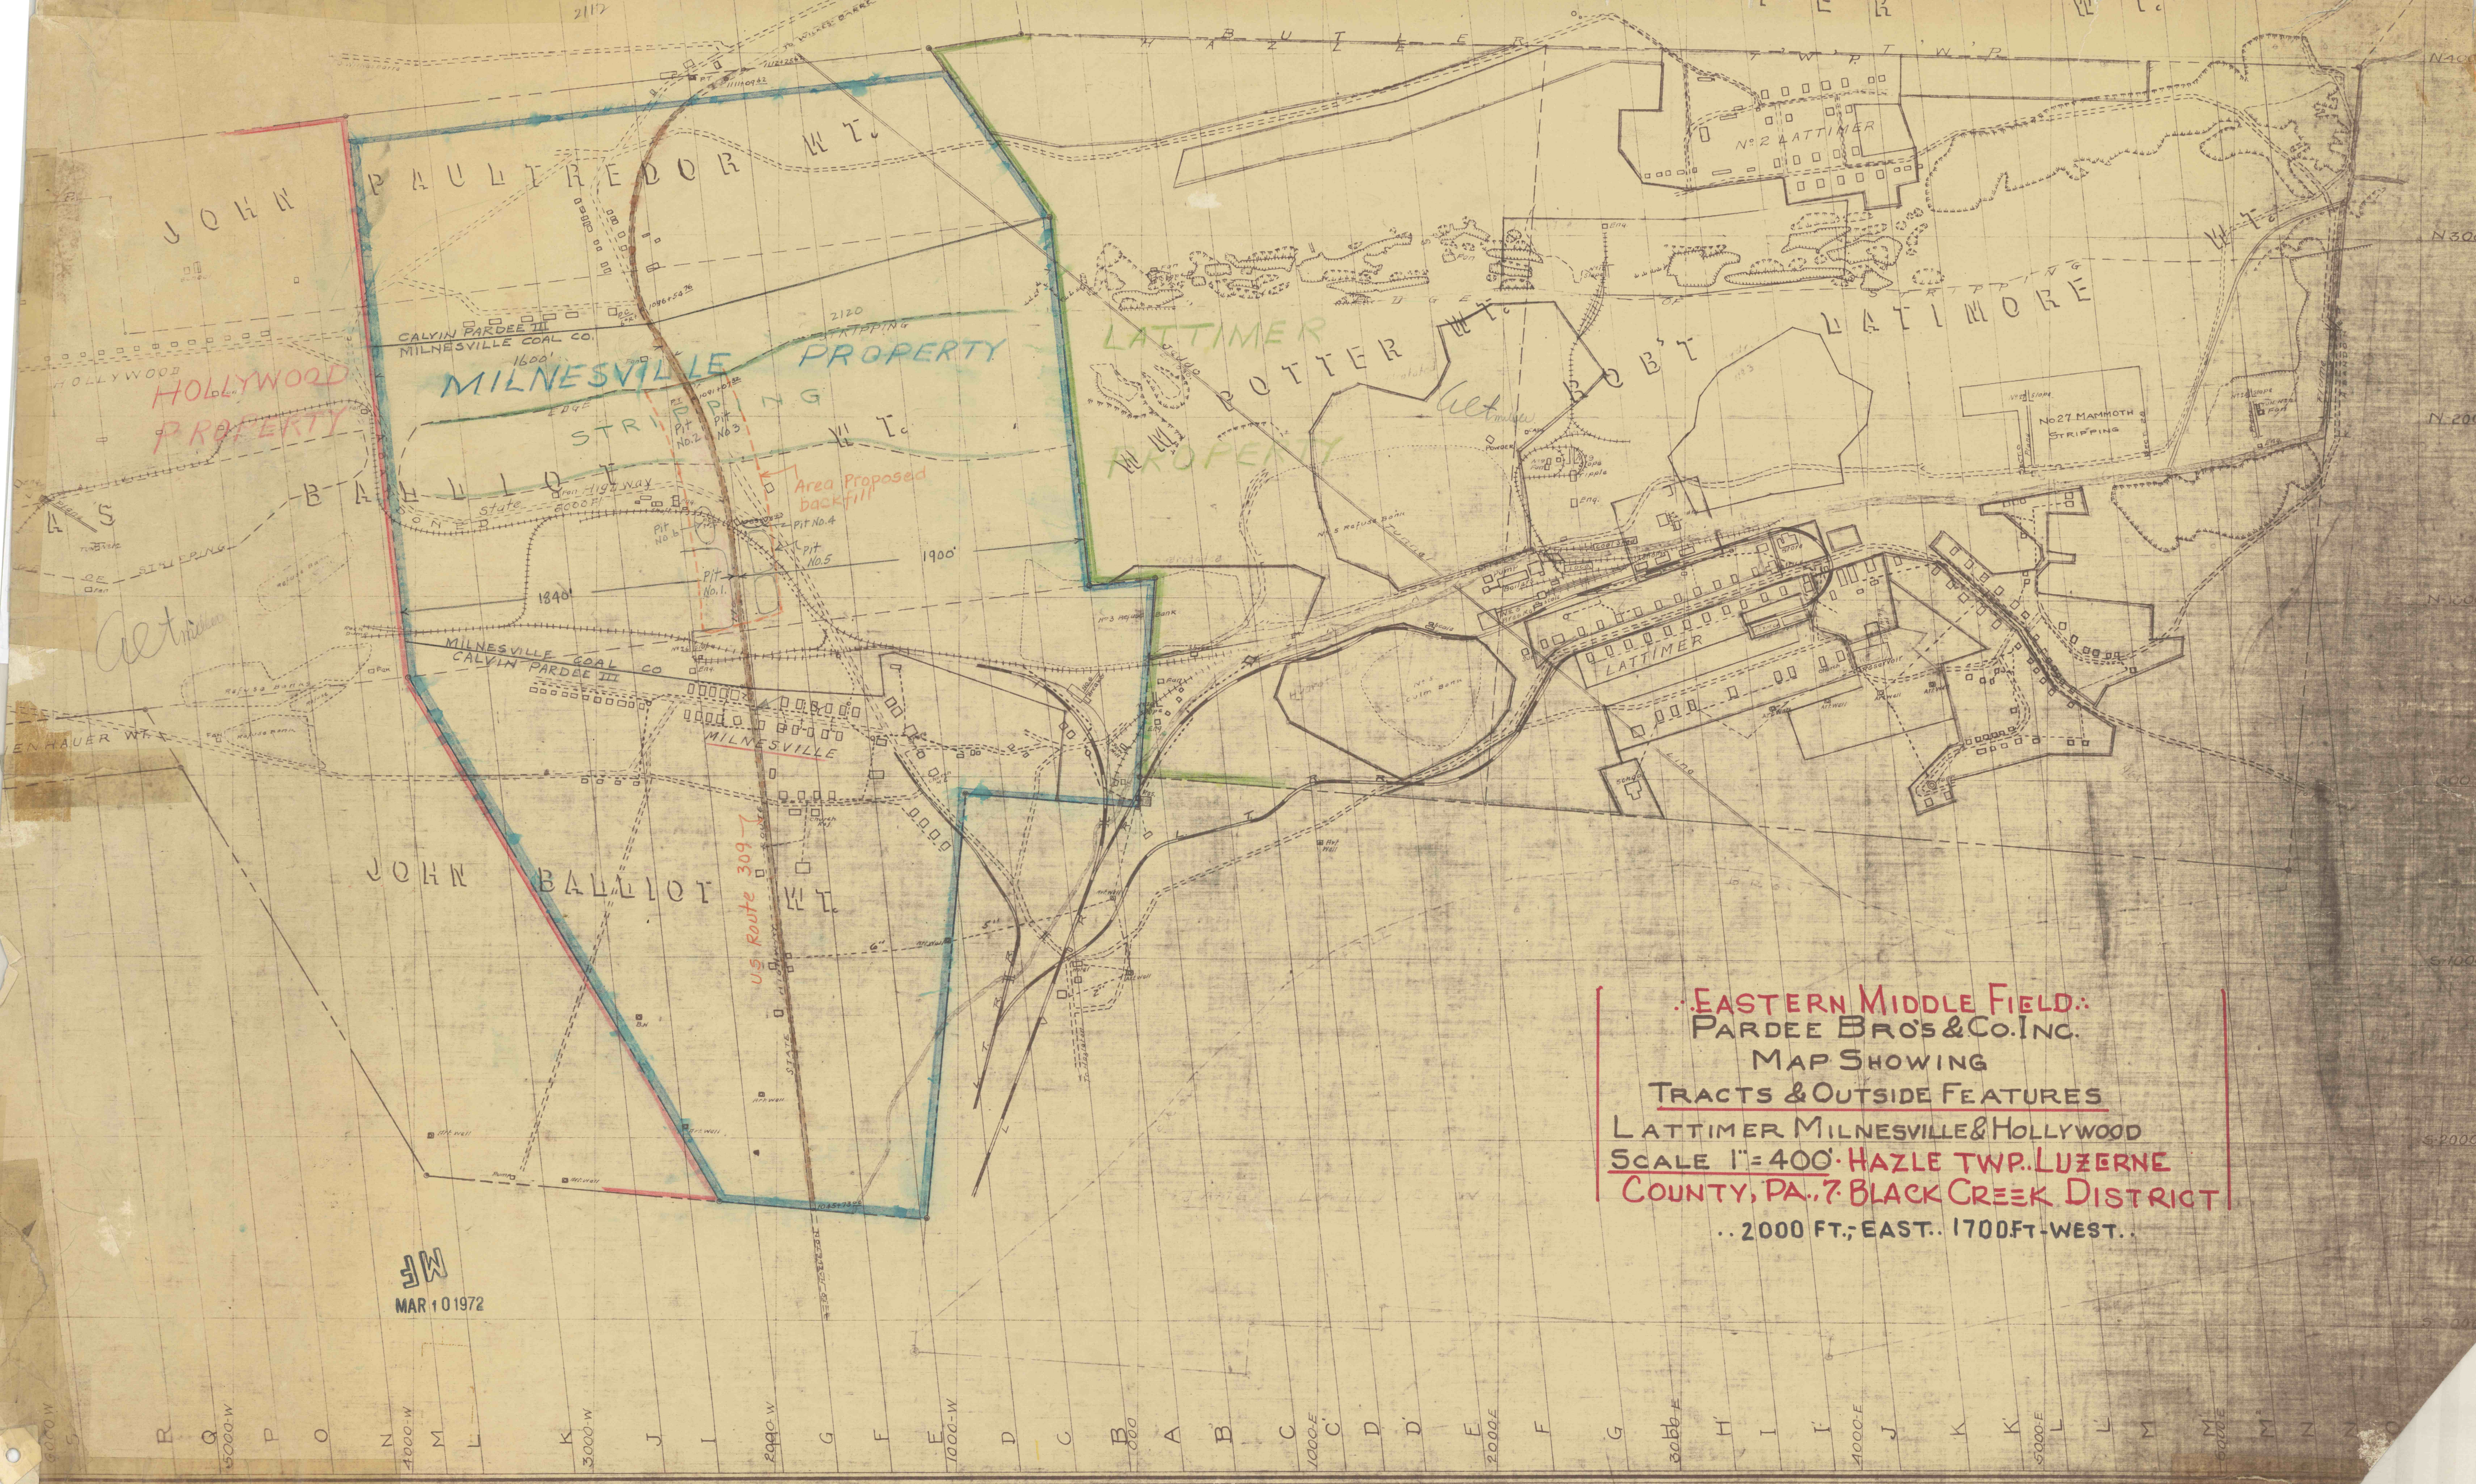

EASTERN MIDDLE FIELD:
PARDEE BROS & CO. INC.
MAP SHOWING
TRACTS & OUTSIDE FEATURES
LATTIMER MILNESVILLE & HOLLYWOOD
SCALE 1"=400'
HAZLE TWP. LUZERNE
COUNTY, PA. 7 BLACK CREEK DISTRICT
2000 FT. EAST. 1700 FT. WEST.

W
MAR 10 1972