


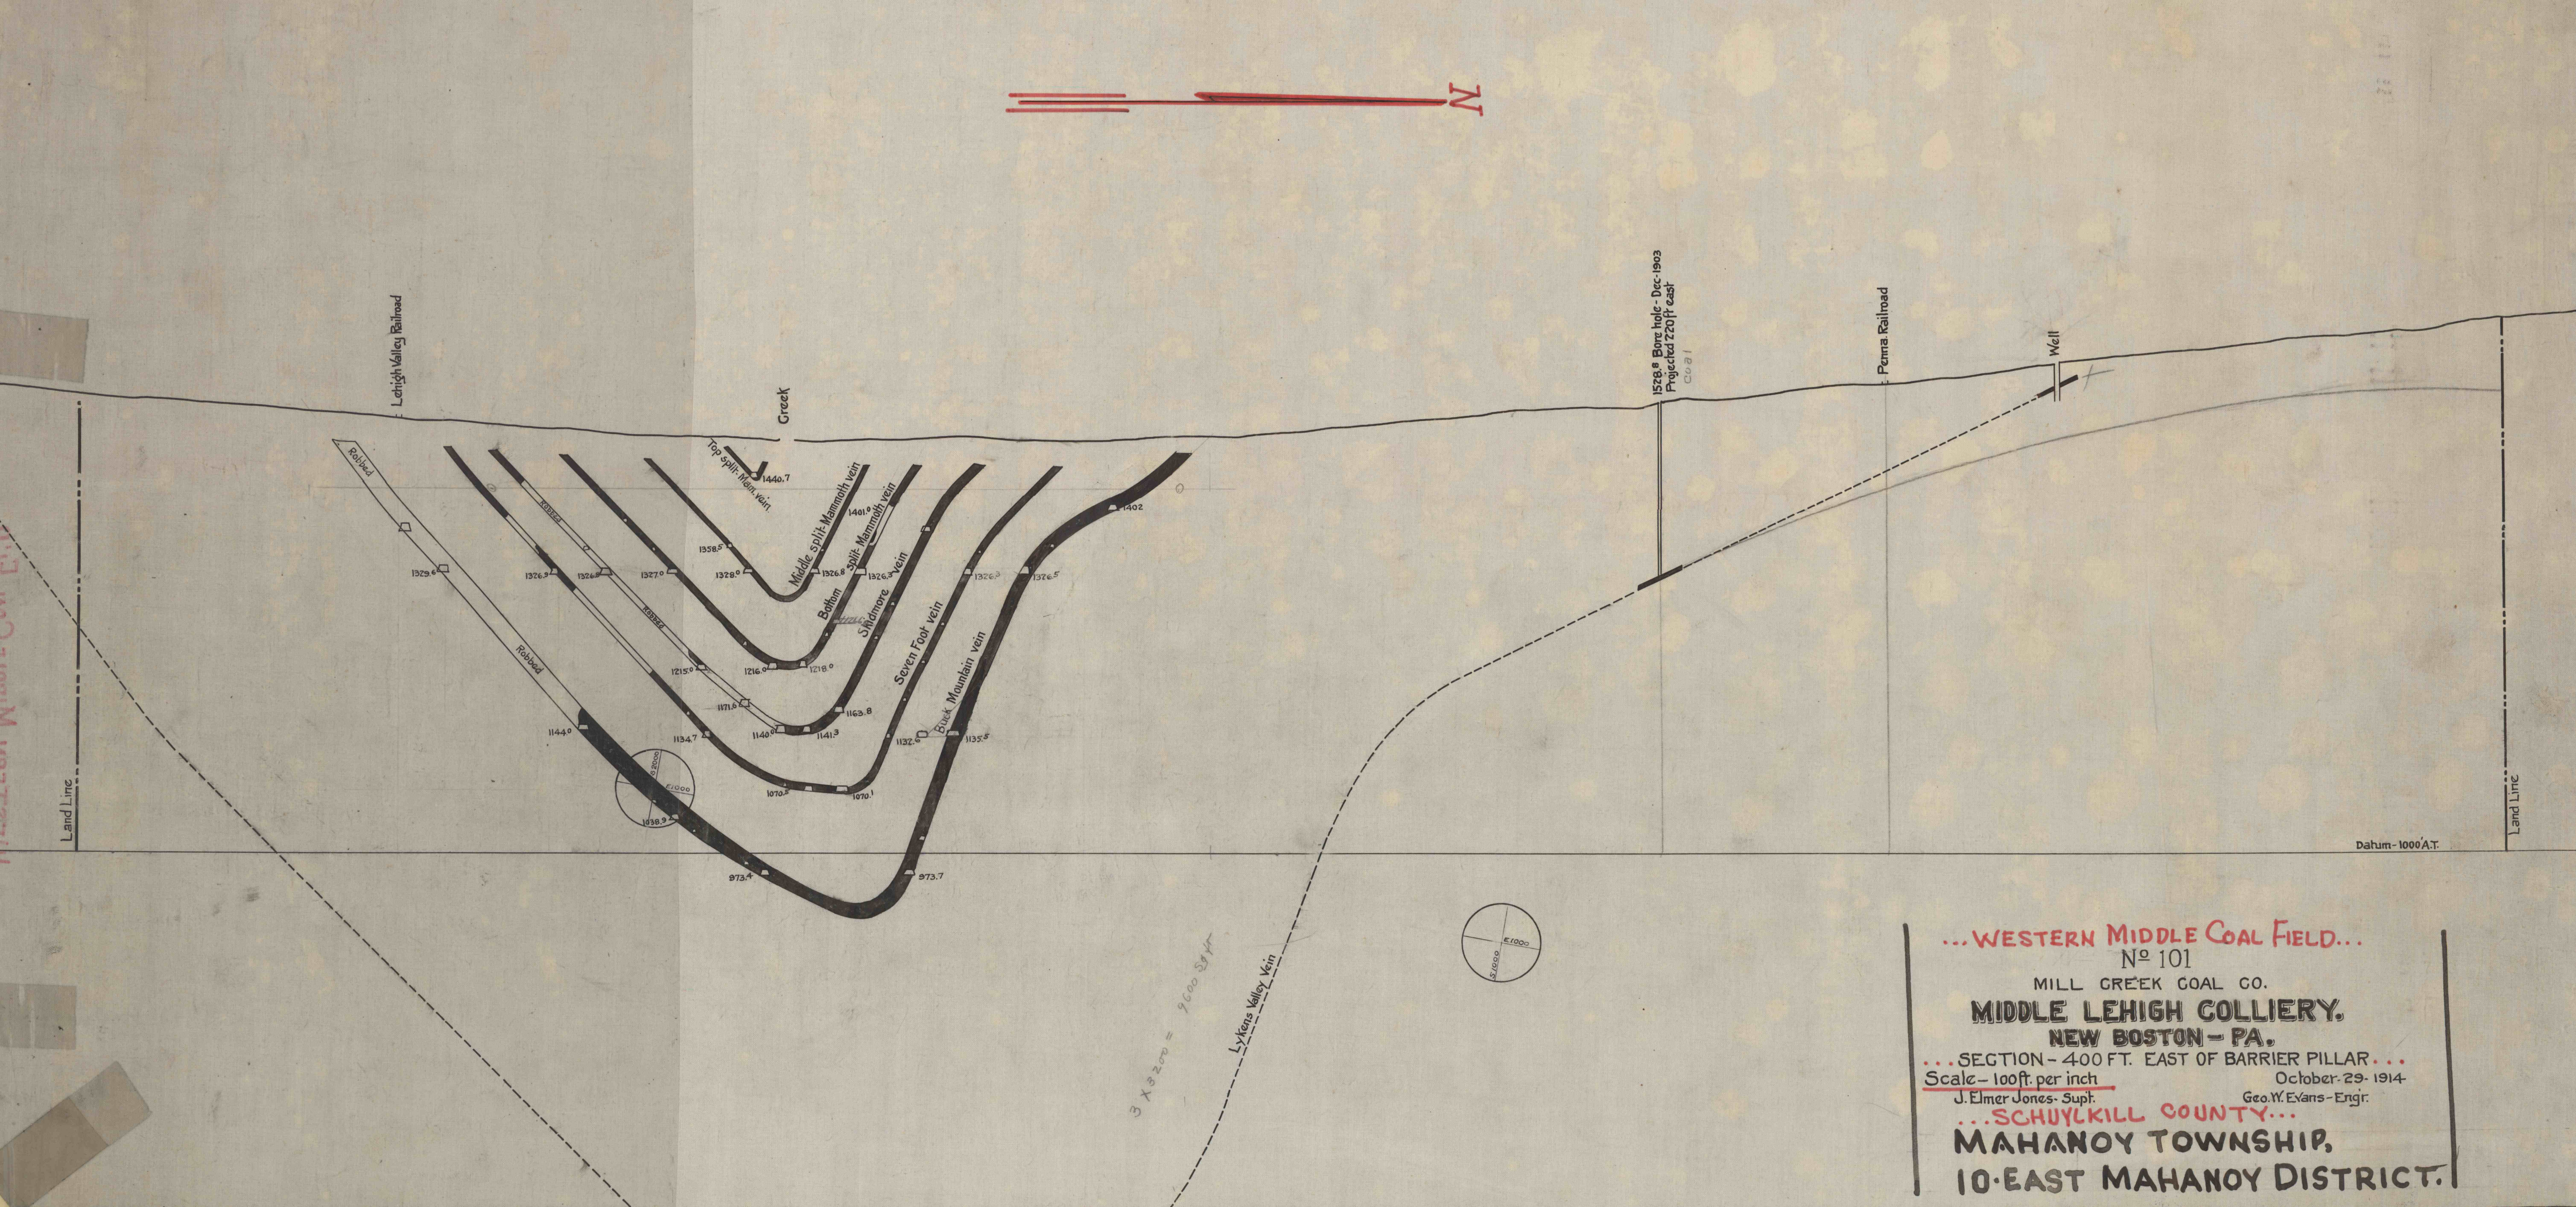

...WESTERN MIDDLE COAL FIELD...
No 101
MILL CREEK COAL CO.
MIDDLE LEHIGH COLLIERY.
NEW BOSTON - PA.
...SECTION - 400 FT. EAST OF BARRIER PILLAR...
Scale - 100 ft. per inch
J. Elmer Jones - Supt. Geo. W. Evans - Engr.
October 29, 1914
...SCHUYLKILL COUNTY...
MAHANOT TOWNSHIP.
10-EAST MAHANOT DISTRICT.