


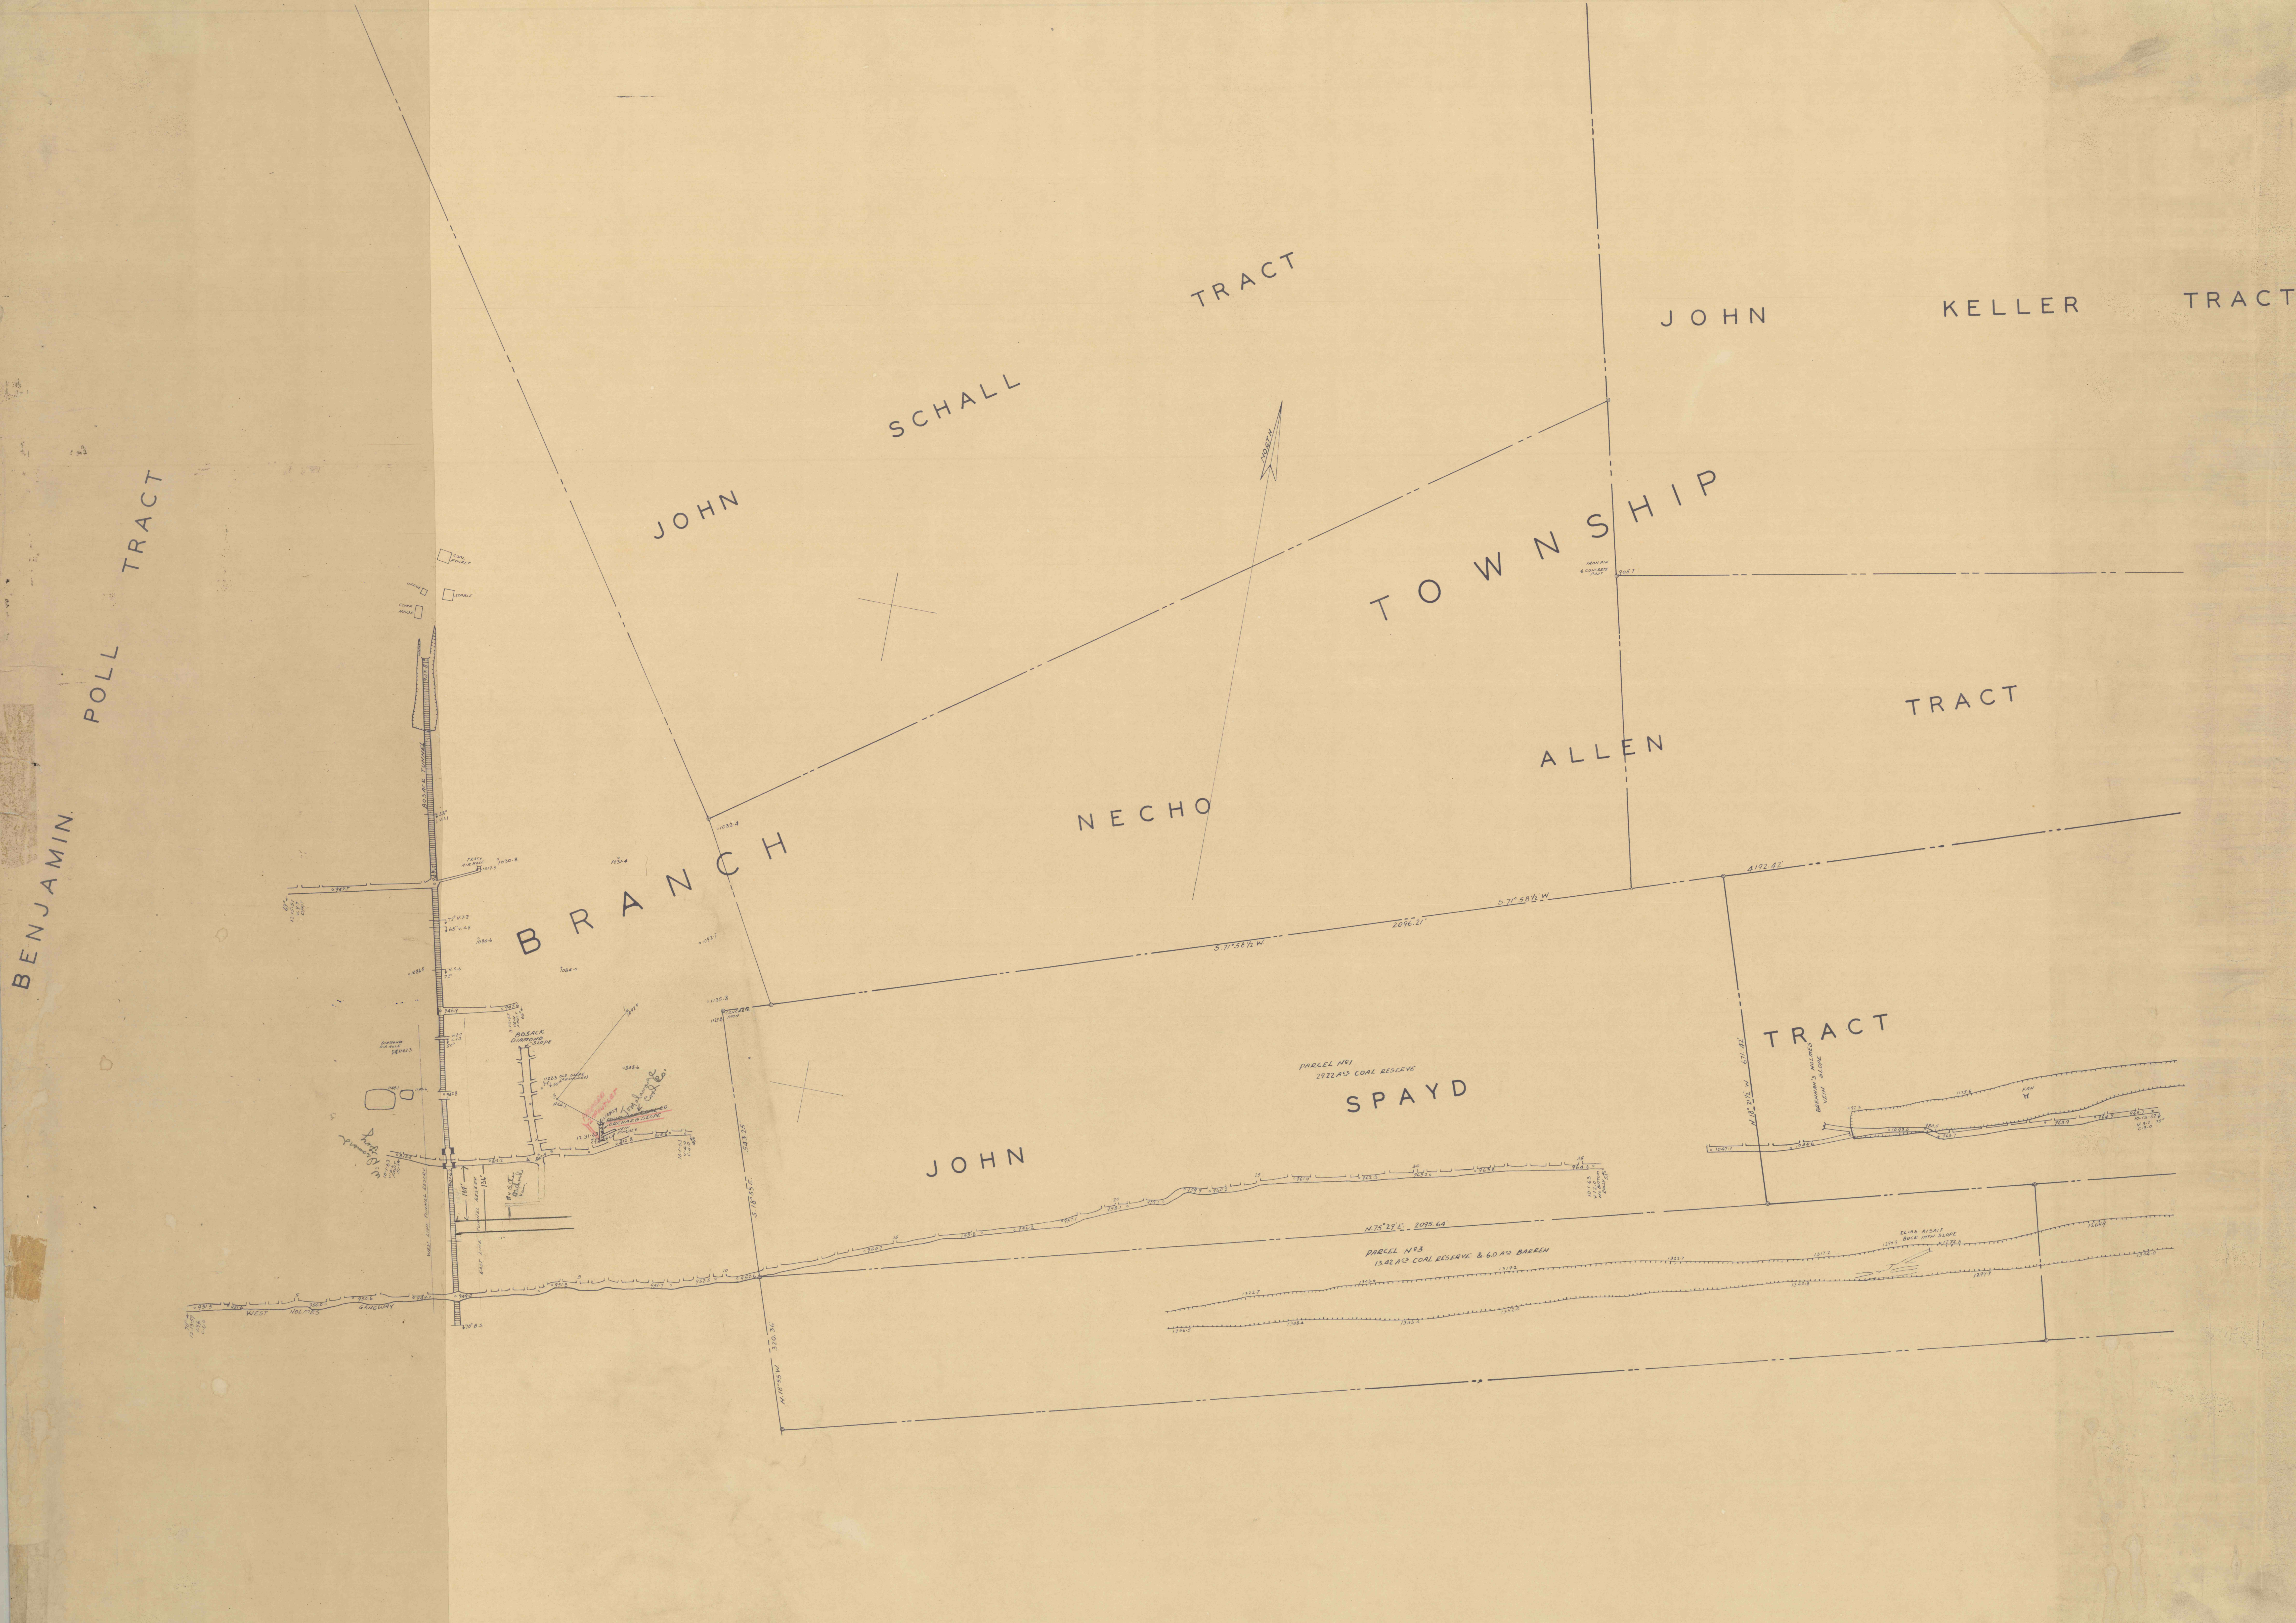

MAP SHOWING MINE WORKINGS ON
SHARP MOUNTAIN IN BRANCH TOWNSHIP,
SCHUYLKILL COUNTY, PENNA.
SCALE 1"=100' DEC. 31, 1963. JOHN C. BRIEL JR.
REG. SURV. NO. 6307-E.