


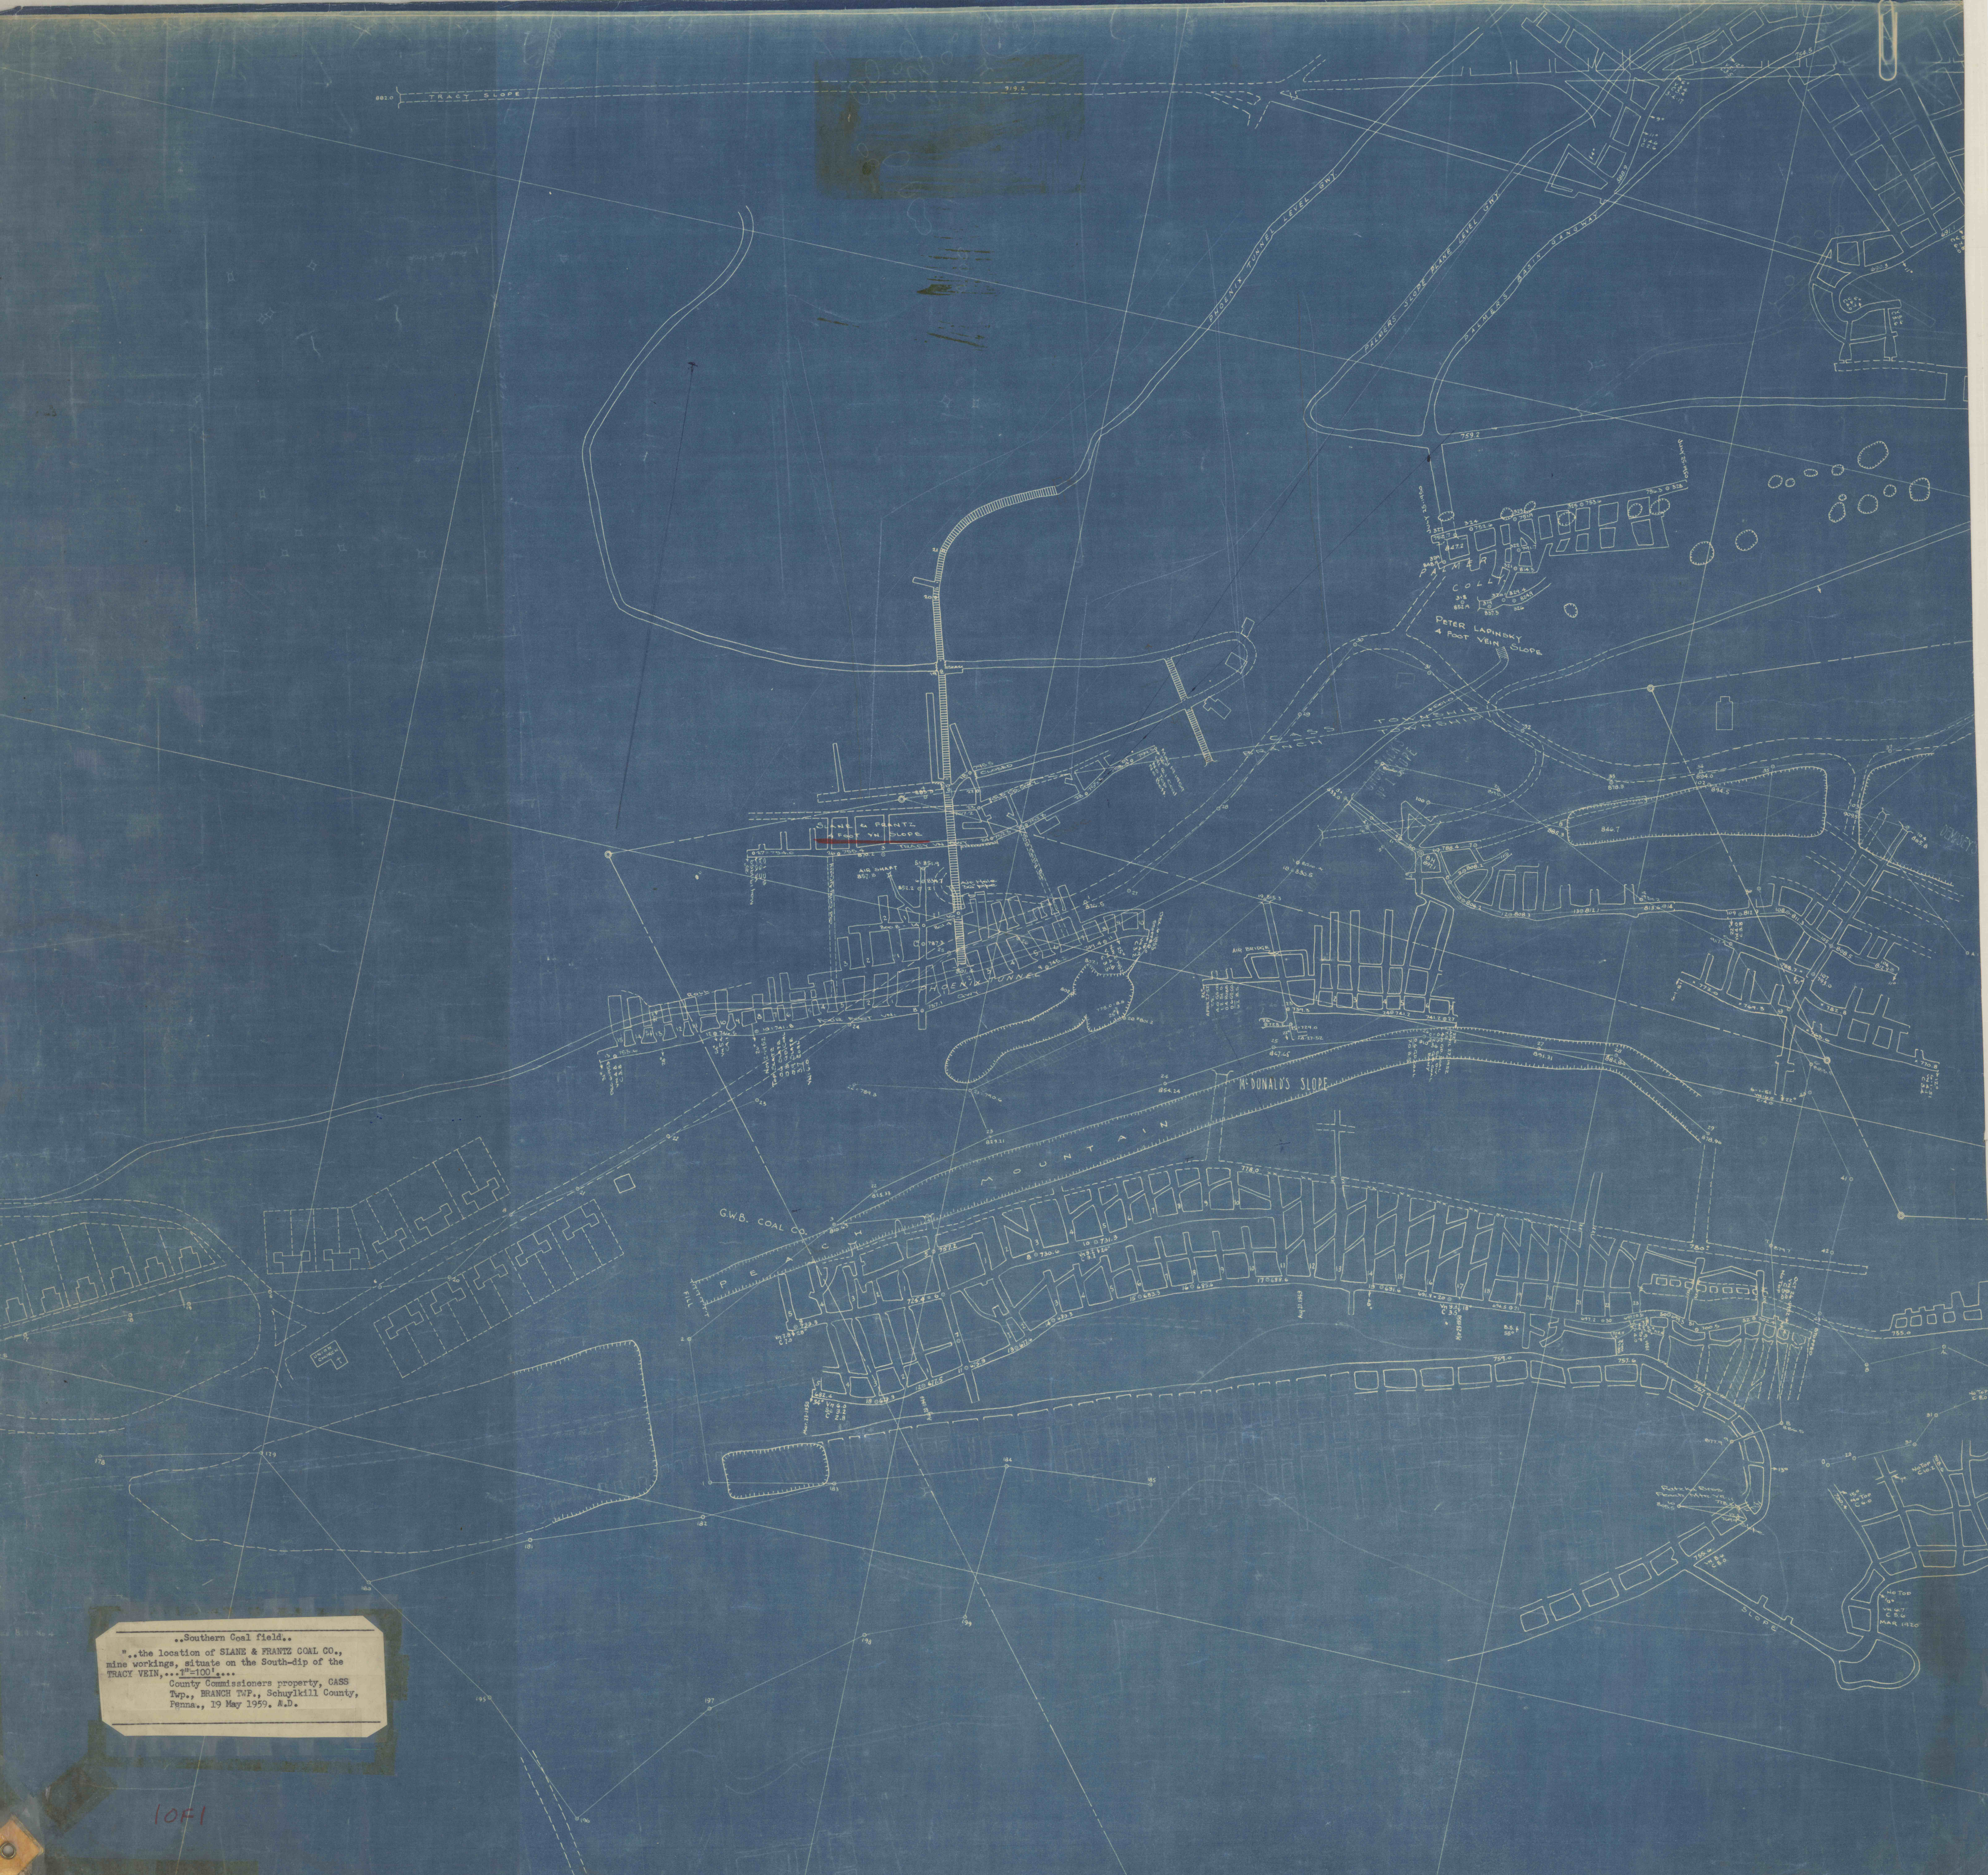

..Southern Coal field..
"..the location of SLANE & FRANTZ COAL CO.,
mine workings, situate on the South-dip of the
TRACY VEIN, ...1"=100'...
County Commissioners property, CASS
Twp., BRANCH TWP., Schuylkill County,
Penn., 19 May 1959. N.D.