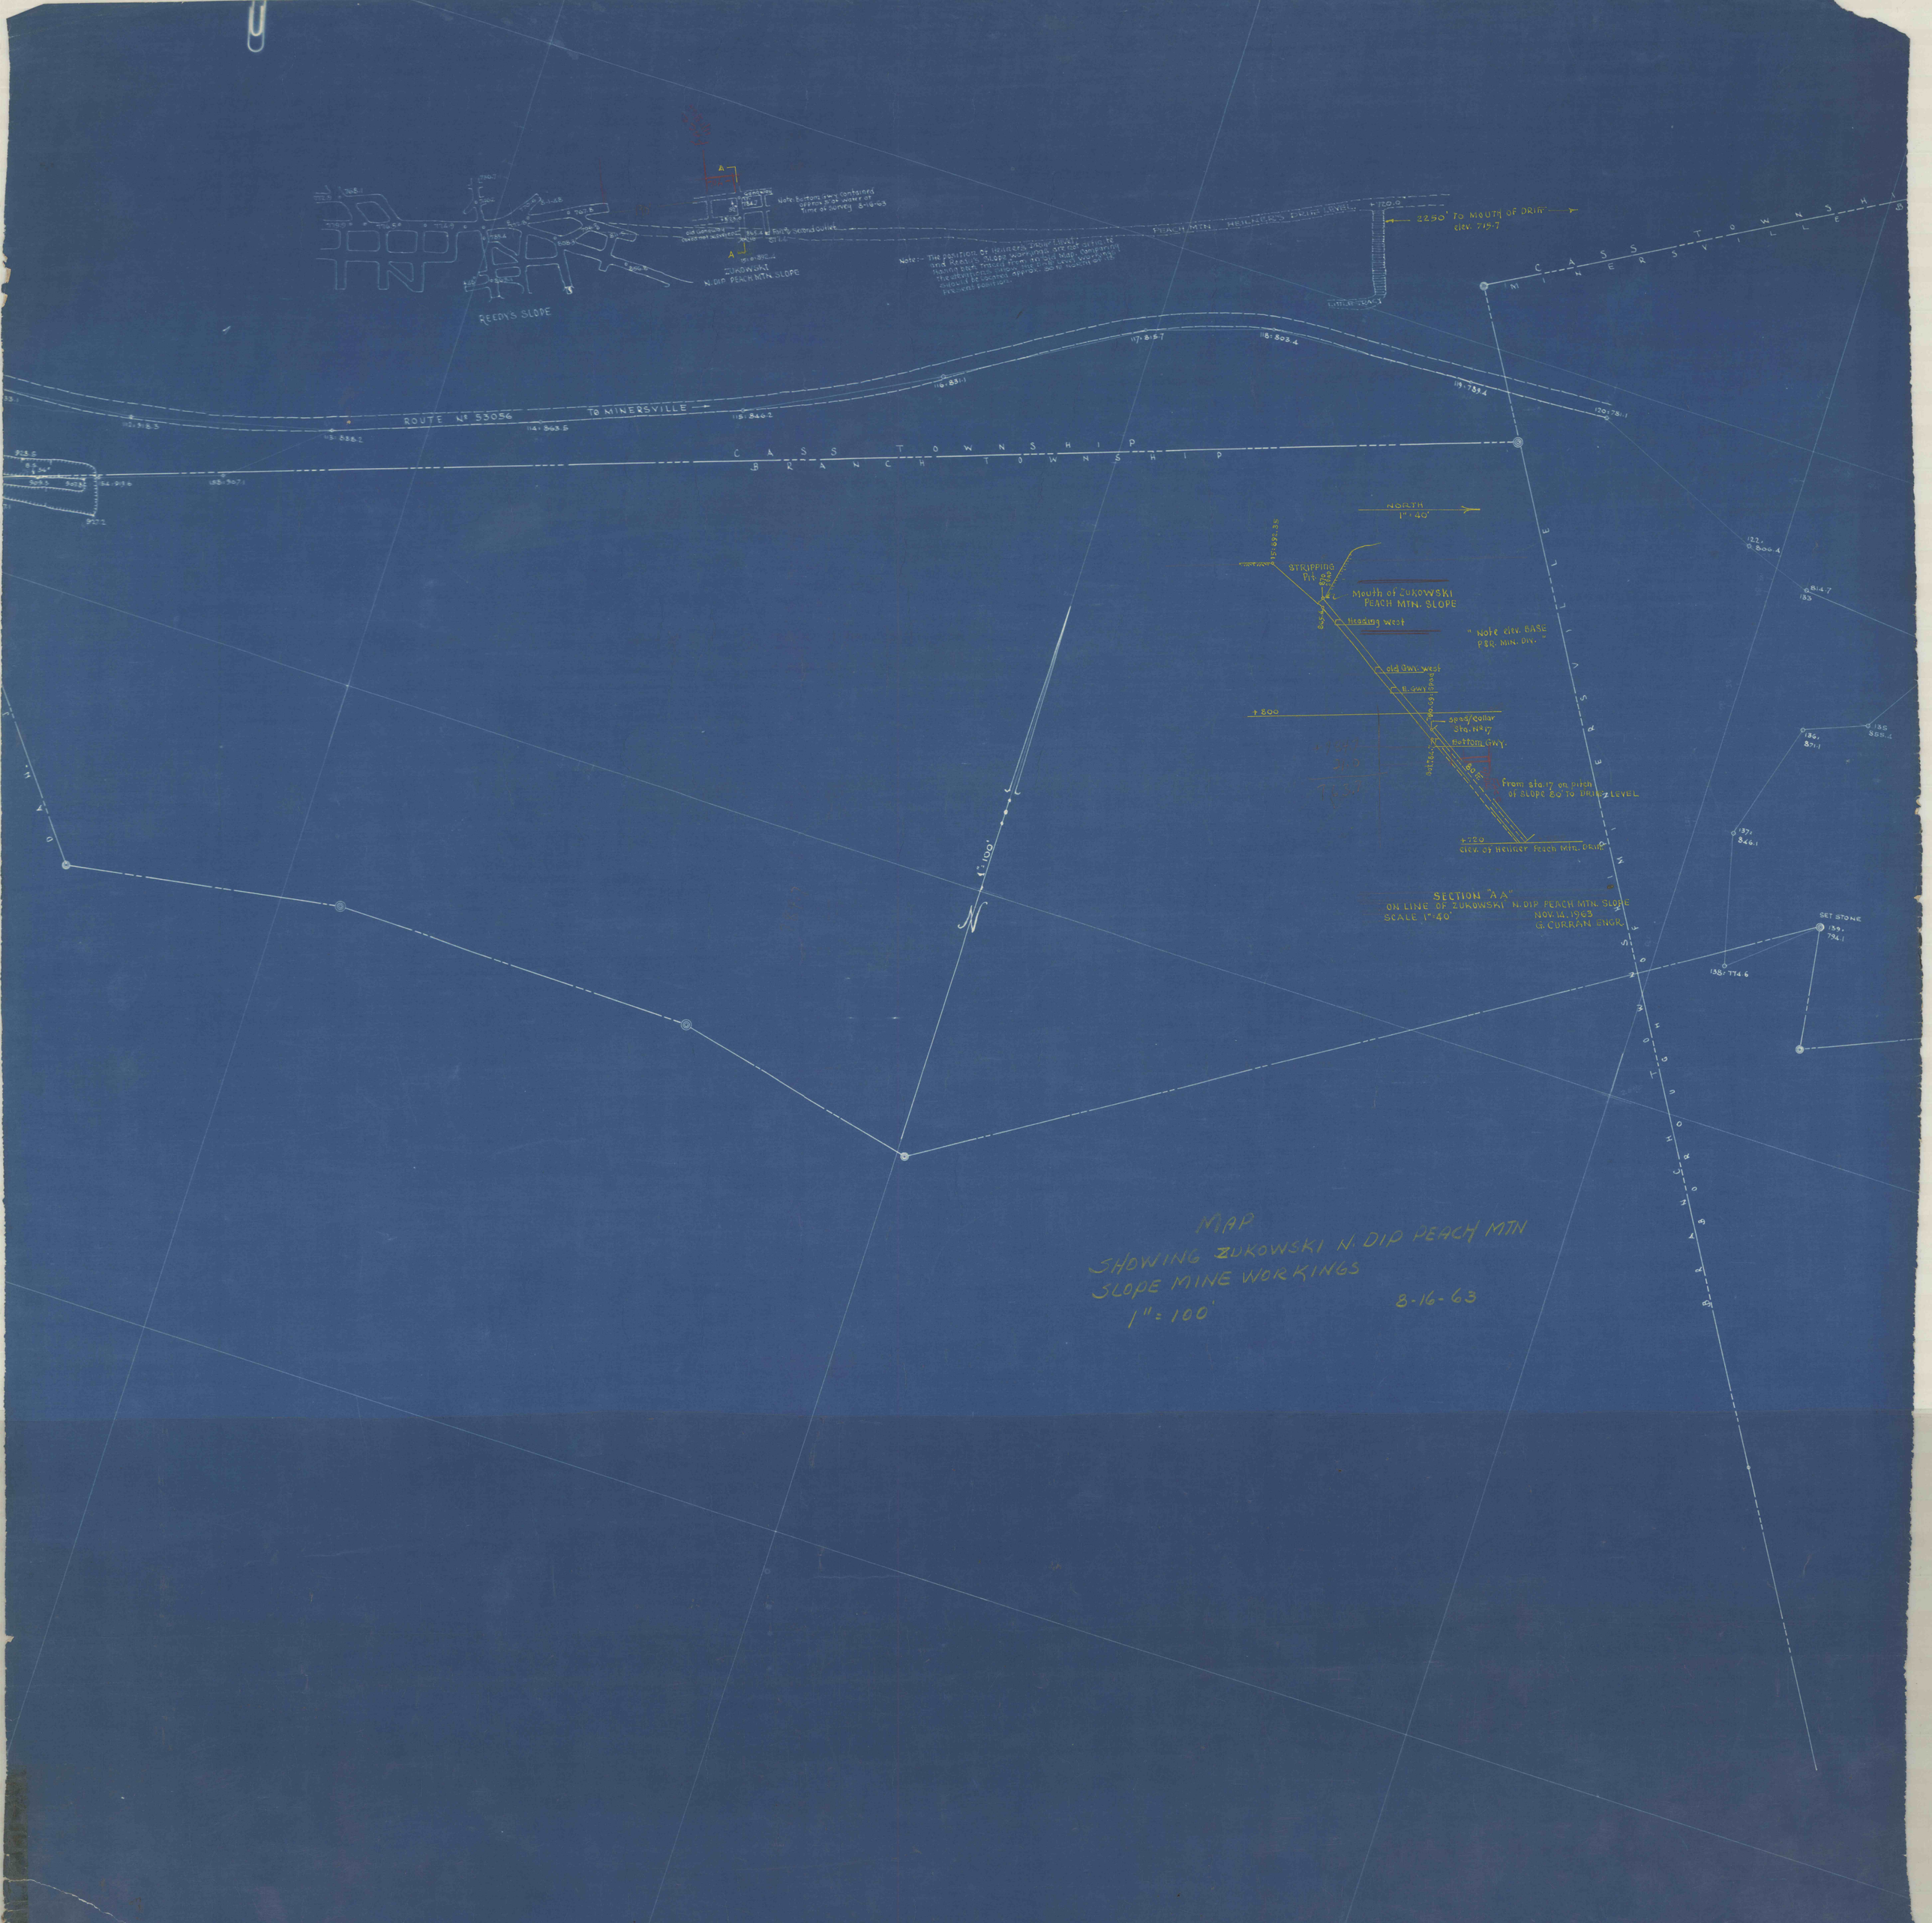
REEDY'S SLOPE
ZUKOWSKI
N. DIP PEACH MTN. SLOPE
Note: Bottom gwy contained approx. 8' of water at time of survey 8-16-63
Note:- The position of Heinger's drift and Reedy's slope workings are as given in hand book issued from the Gold Map, comparing the above plan, the mouth of Gold Map workings would be located approx. 50' to north of its present position.
PEACH MTN. HEINGER'S DRIFT LEVEL
+720.0
2250' TO MOUTH OF DRIFT
elev. 719.7
ROUTE No 53056
TO MINERSVILLE
C A S S T O W N S H I P
B R A N C H T O W N S H I P
C A S S V I L L E
NORTH
1" = 40'
STRIPPING
Mouth of ZUKOWSKI
PEACH MTN. SLOPE
Heading West
" Note elev. BASE P&R. MIN. DIV. "
old Gwy. west
E. Gwy.
+800
spad/collar
Sta. No 17
Bottom Gwy.
From sta. 17 on pitch of SLOPE 80' TO DRIFT LEVEL
+720
elev. of Heinger Peach Mtn. Drift
SECTION "A A"
ON LINE OF ZUKOWSKI N. DIP PEACH MTN. SLOPE
SCALE 1" = 40'
NOV. 14. 1963
G. CURRAN ENGR.
1" = 100'
SET STONE
139, 794.1
138, 774.6
MAP
SHOWING ZUKOWSKI N. DIP PEACH MTN
SLOPE MINE WORKINGS
1" = 100'
8-16-63