


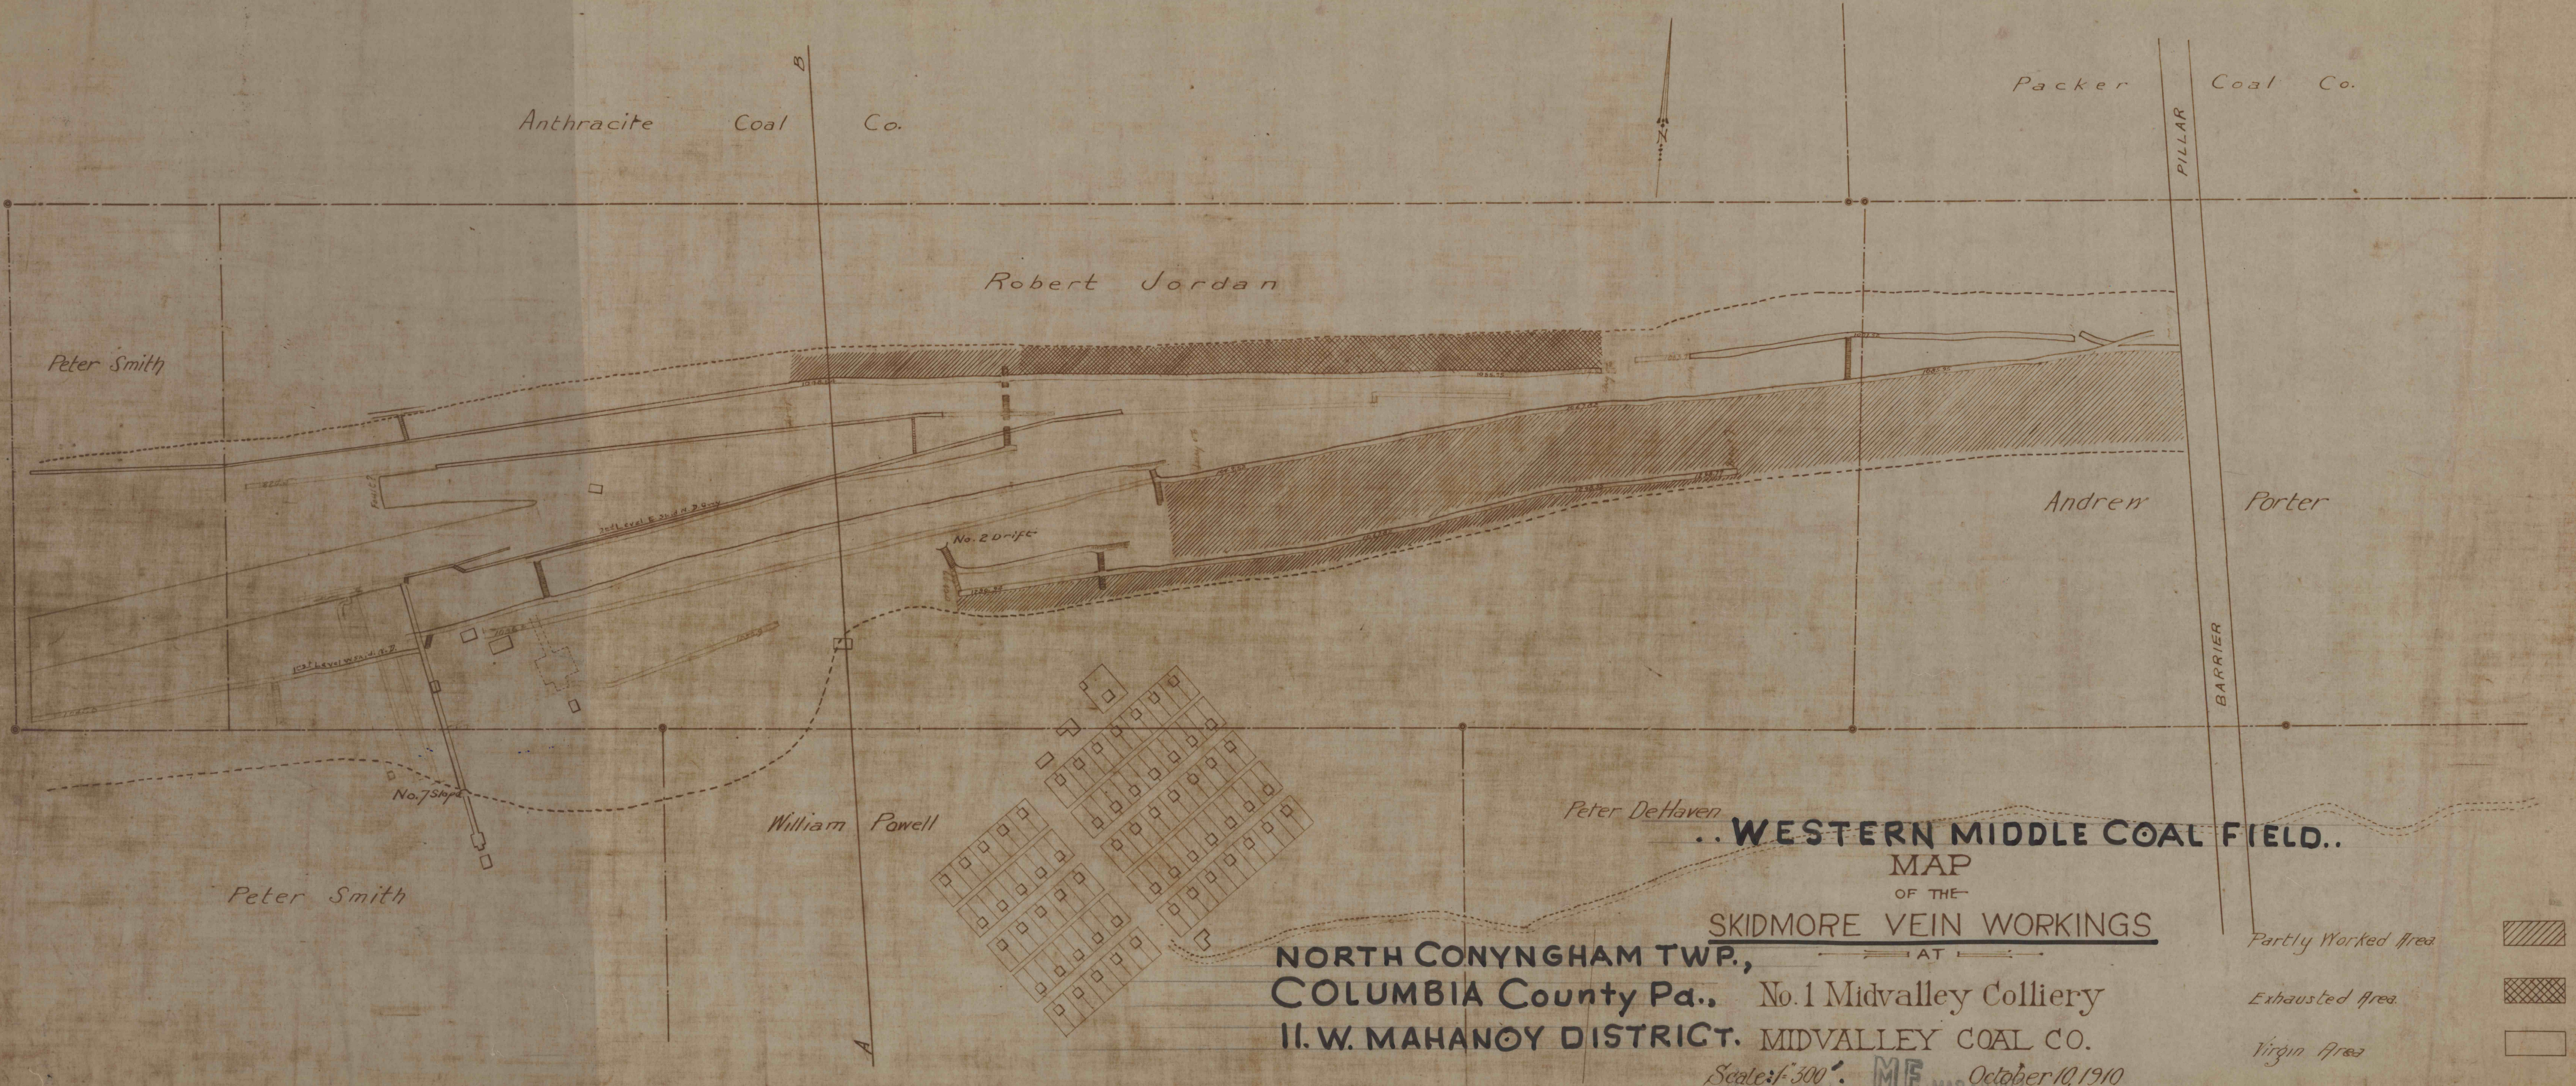

Anthracite Coal Co.

Packer Coal Co.

Robert Jordan

Peter Smith

Andrew Porter

No. 2 Drift

No. 7 Slope

William Powell

Peter De Haven

Peter Smith

.. WESTERN MIDDLE COAL FIELD..

MAP
OF THE

SKIDMORE VEIN WORKINGS

AT

NORTH CONYNGHAM TWP.,
COLUMBIA County Pa.,

No. 1 Midvalley Colliery

II. W. MAHAN OY DISTRICT.

MIDVALLEY COAL CO.

Scale: 1" = 300'

MF

October 10, 1910

Partly Worked Area

Exhausted Area

Virgin Area

