

Anthracite Coal Co.

Robert Jordan

Peter Smith

Andrew Porter

Wm. Powell

Peter Smith

..WESTERN MIDDLE COAL FIELD..

Map of the

SKIDMORE VEIN WORKINGS..NORTH CONYNGHAM TWP.,
COLUMBIA COUNTY PA.,
Midvalley Colliery

Scale 1"= 300'

Nov. 3, 1910

II. W. MAHANAY DISTRICT.
HAZLEBROOK COAL CO..


NF

MAR 10 1972

MAR 10 1972

PILLAR

BARRIER

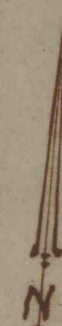

1st L. W. S. D. Skidmore Gwy
No. 4 Drift

2nd L. W. S. D. Skidmore In Gwy

2nd L. E. S. D. Skid. Gwy

No. 2 Drift

No. 7 Slope

