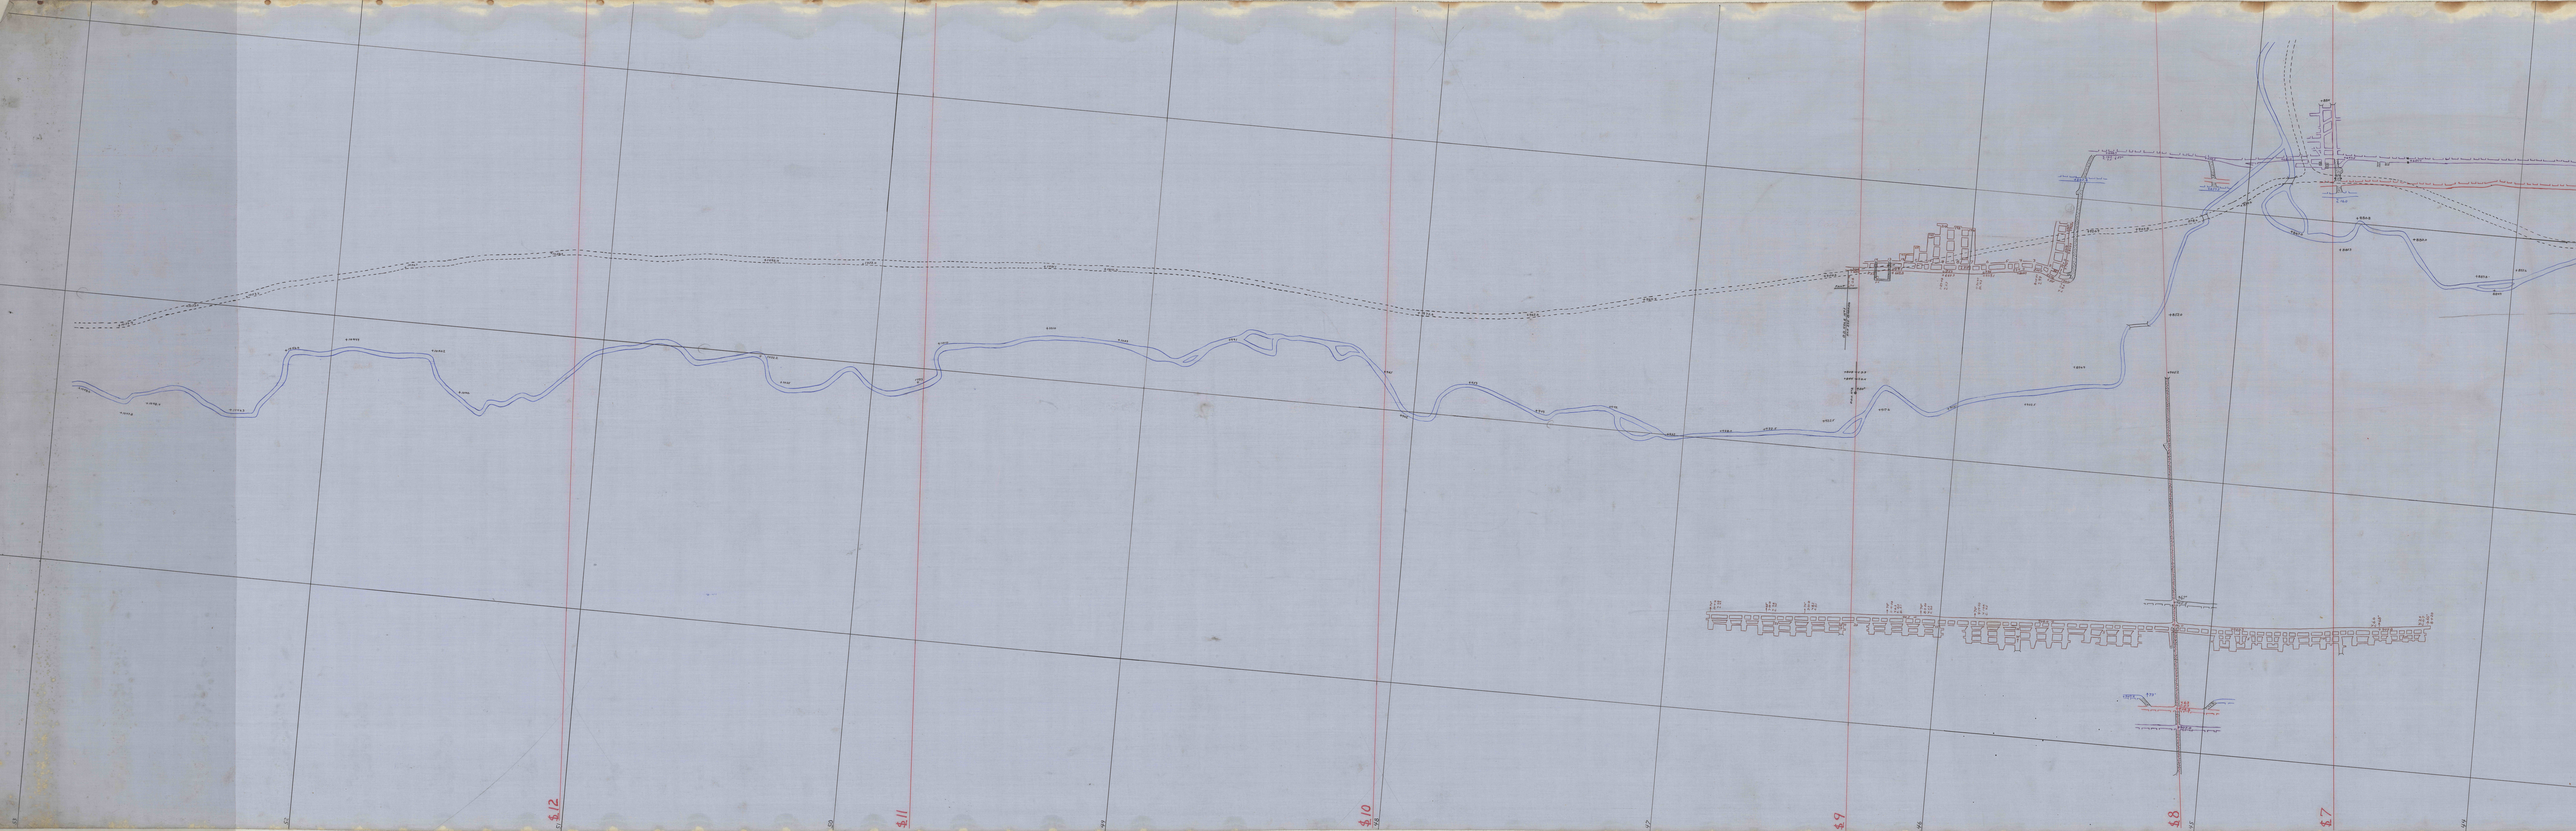
S12
S11
S10
S9
S8
S7