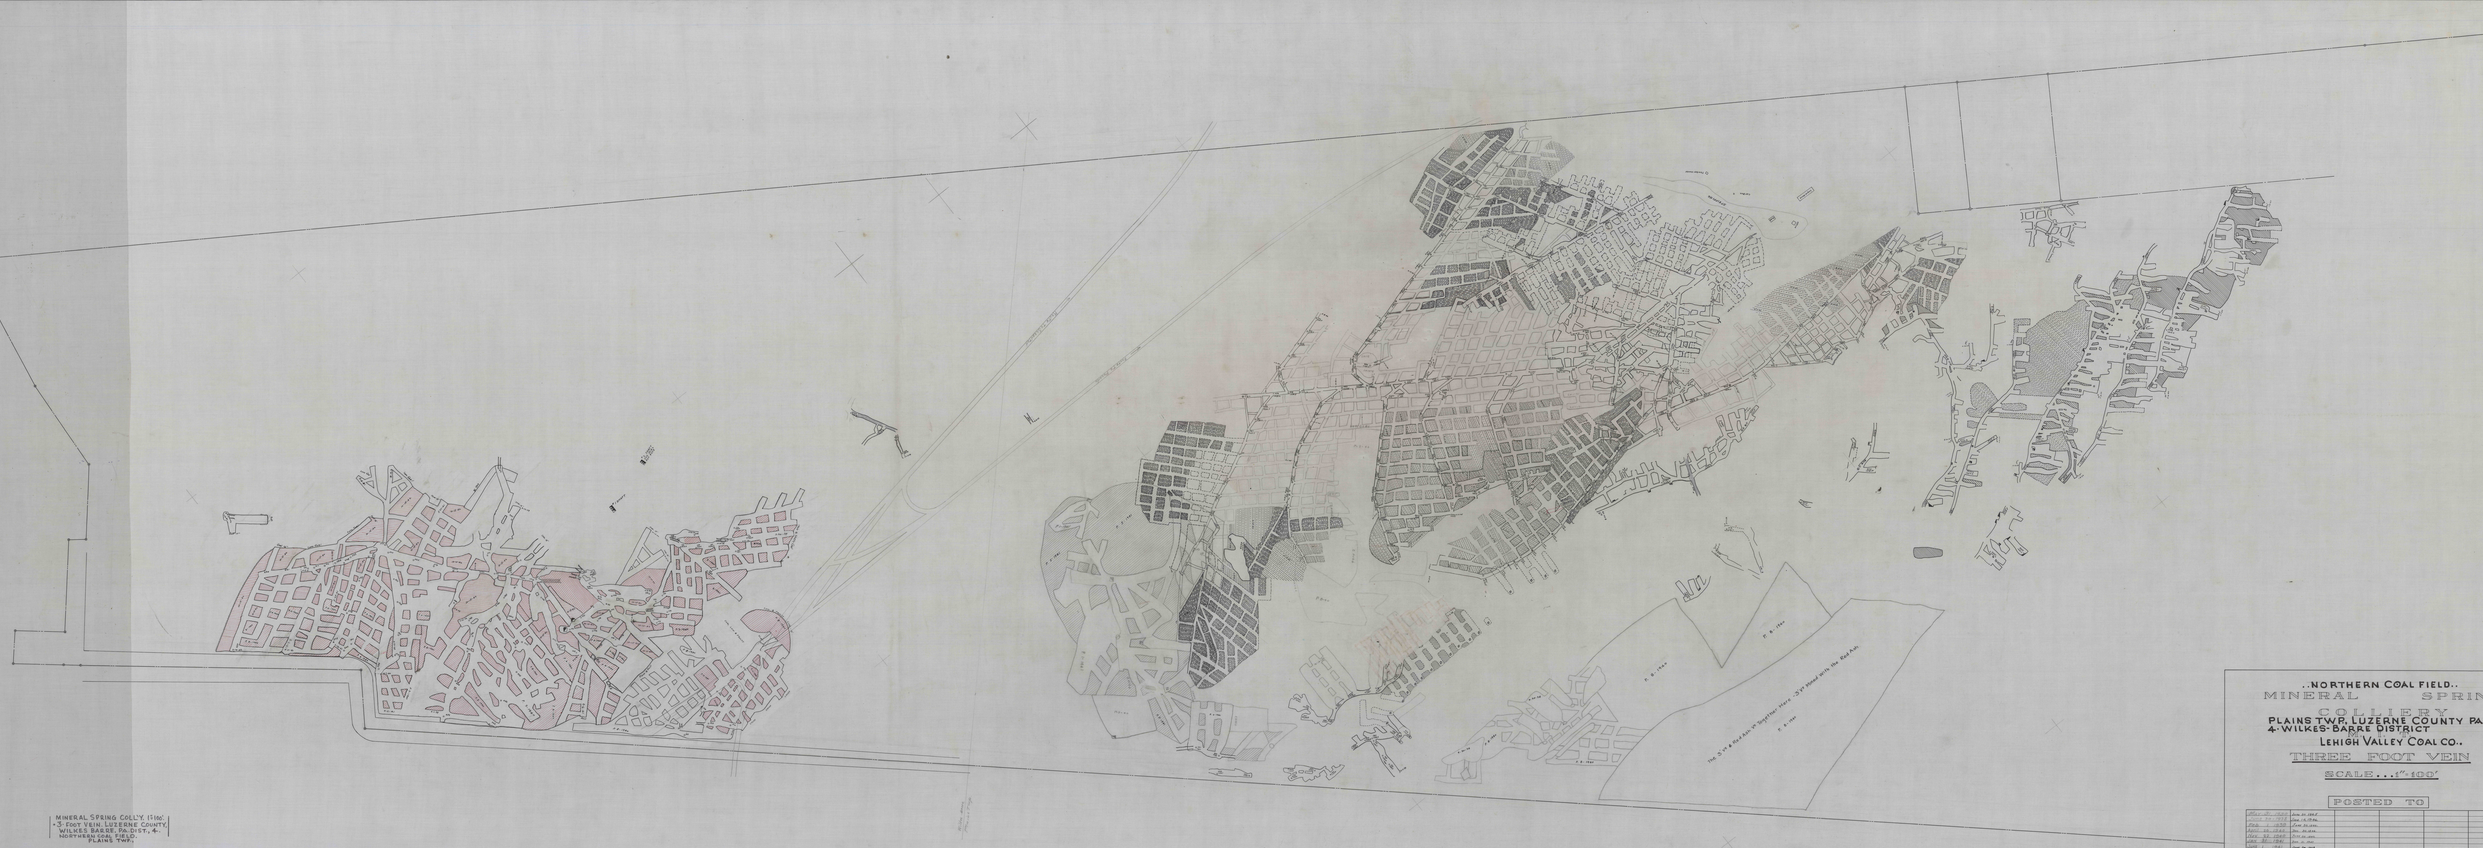


MINERAL SPRING COLL'Y. 1166'
-3- FOOT VEIN. LUZERNE COUNTY.
WILKES BARRE, PA. DIST., 4-
NORTHERN COAL FIELD.
PLAINS TWP.

..NORTHERN COAL FIELD..

MINERAL SPRING COLLIERY

PLAINS TWP. LUZERNE COUNTY PA.,
4-WILKES-BARRE DISTRICT
LEHIGH VALLEY COAL CO.,

THREE FOOT VEIN

SCALE...1" = 100'

POSTED TO

FEB 1 1937	Rev. to 1937					
FEB. 1 1938	Rev. to 1938					
FEB. 10 1939	Rev. to 1939					
FEB. 27 1940	Rev. to 1940					
JAN 30 1941	Rev. to 1941					
JAN. 1 1942	Rev. to 1942					
JAN. 1 1943						
JAN. 1 1944						
JAN. 1 1945						
JAN. 1 1946						
JAN. 1 1947						