


SECTION 10+00

3+00 3+50 4+00 4+50 5+00 5+50

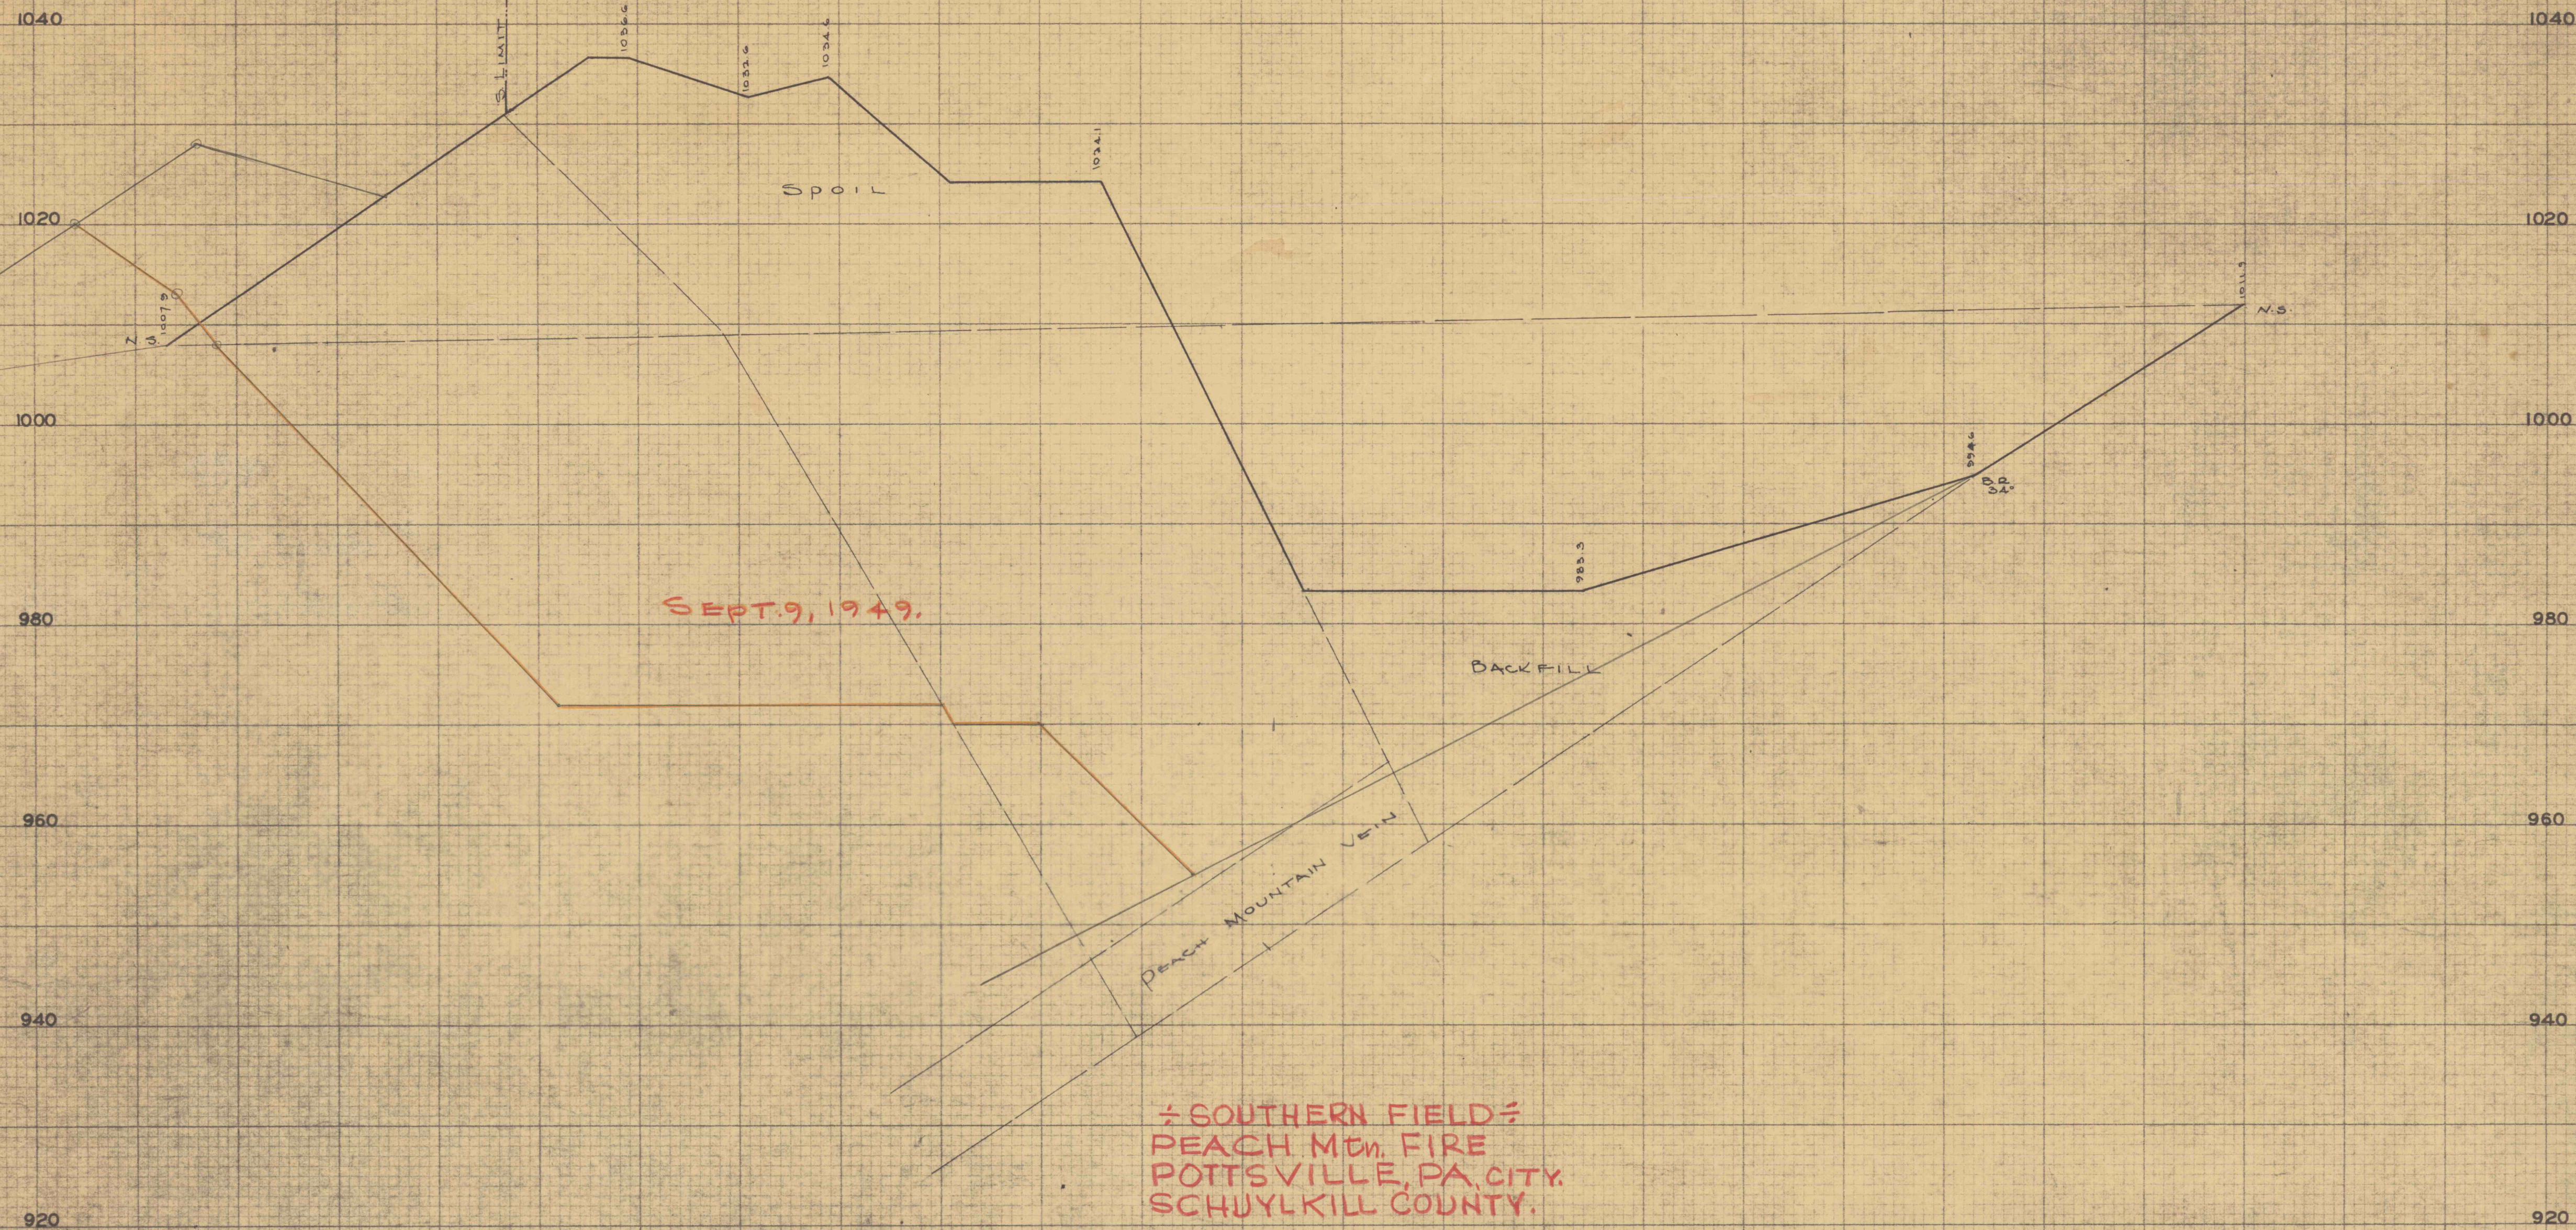

PENNA HWY
#58022

± SOUTHERN FIELD ±
PEACH Mtn. FIRE
POTTSVILLE, PA. CITY
SCHUYLKILL COUNTY.