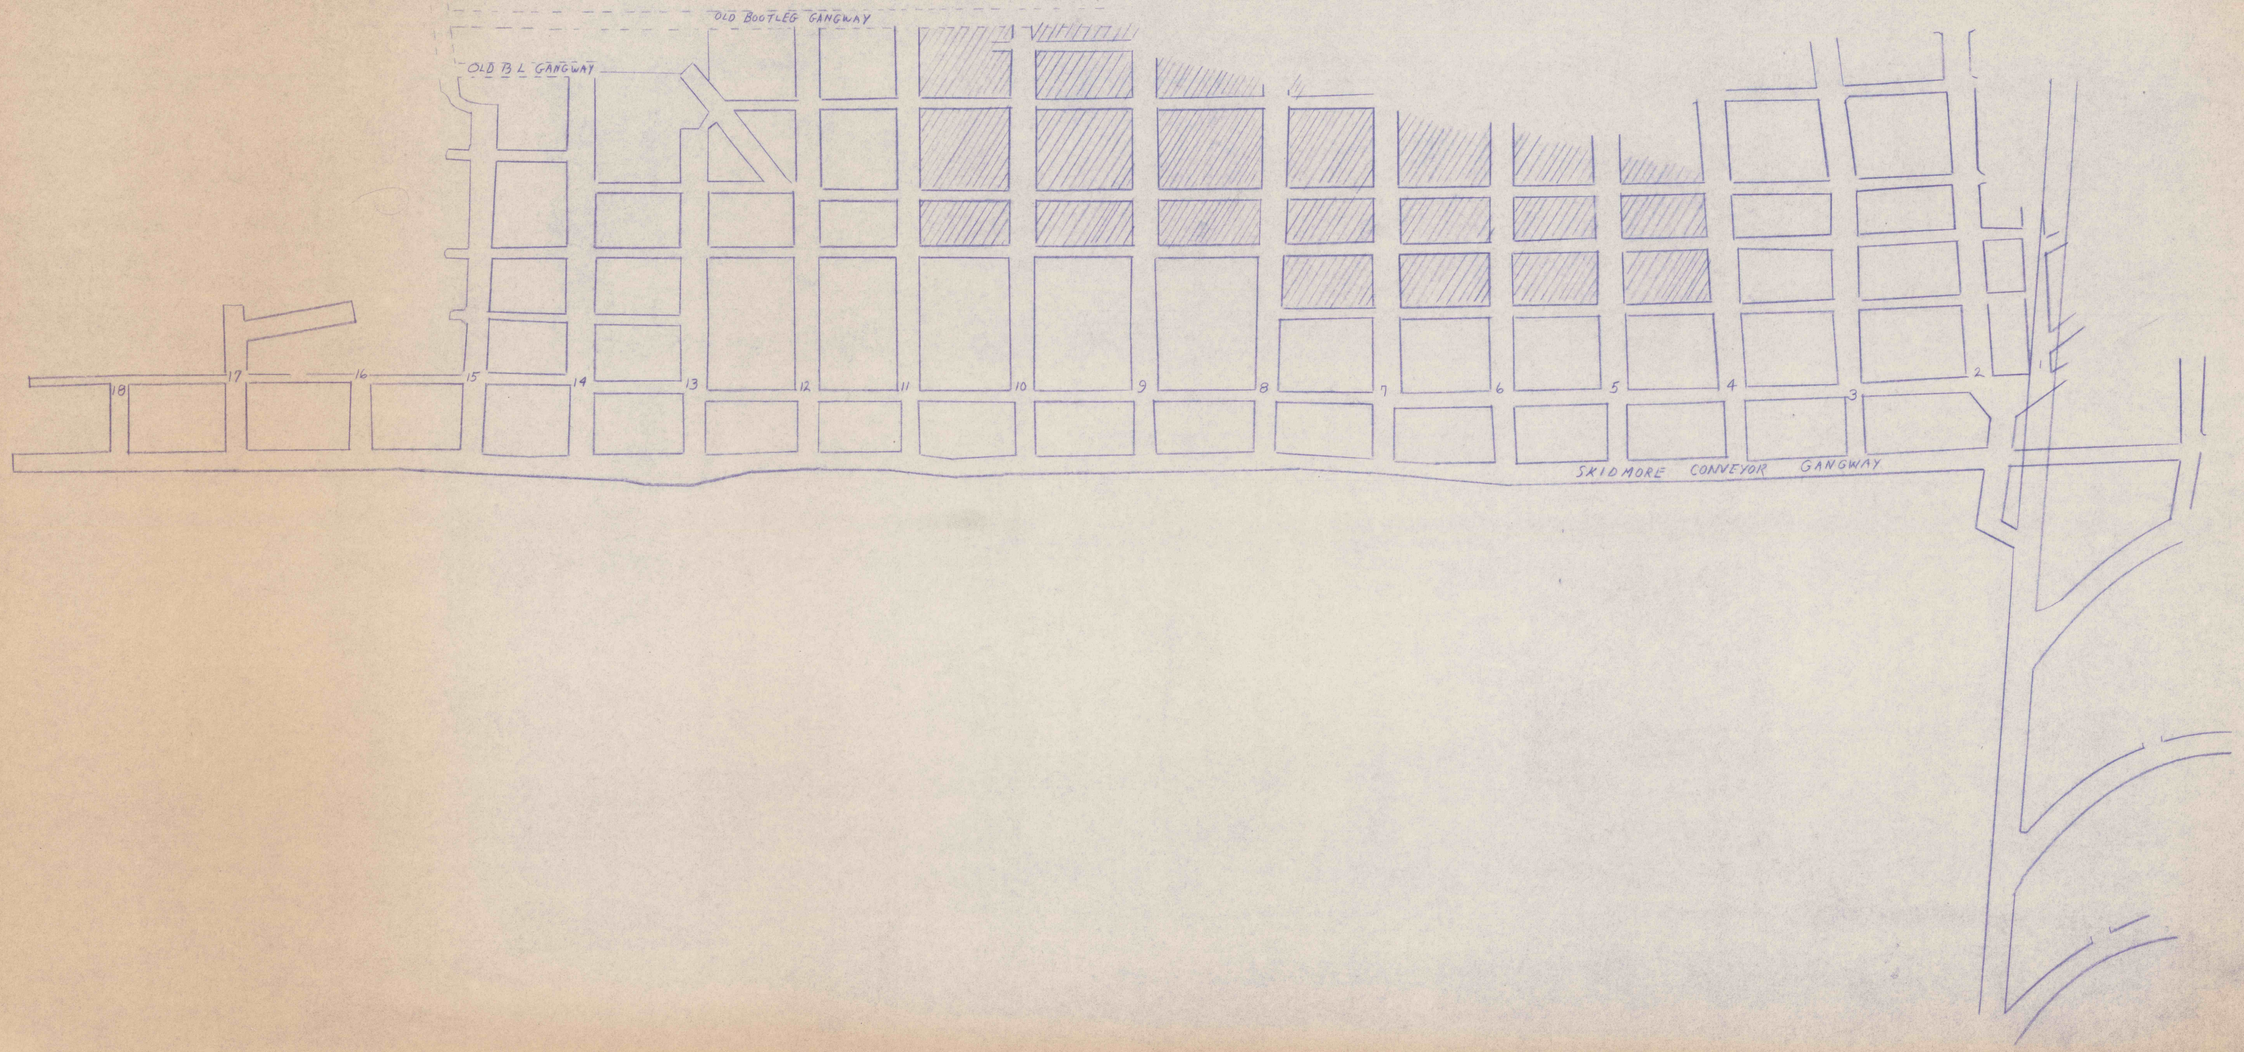
OLD BOOTLEG GANGWAY
OLD B L GANGWAY
18
17
16
15
14
13
12
11
10
9
8
7
6
5
4
3
2
1
SKIDMORE CONVEYOR GANGWAY