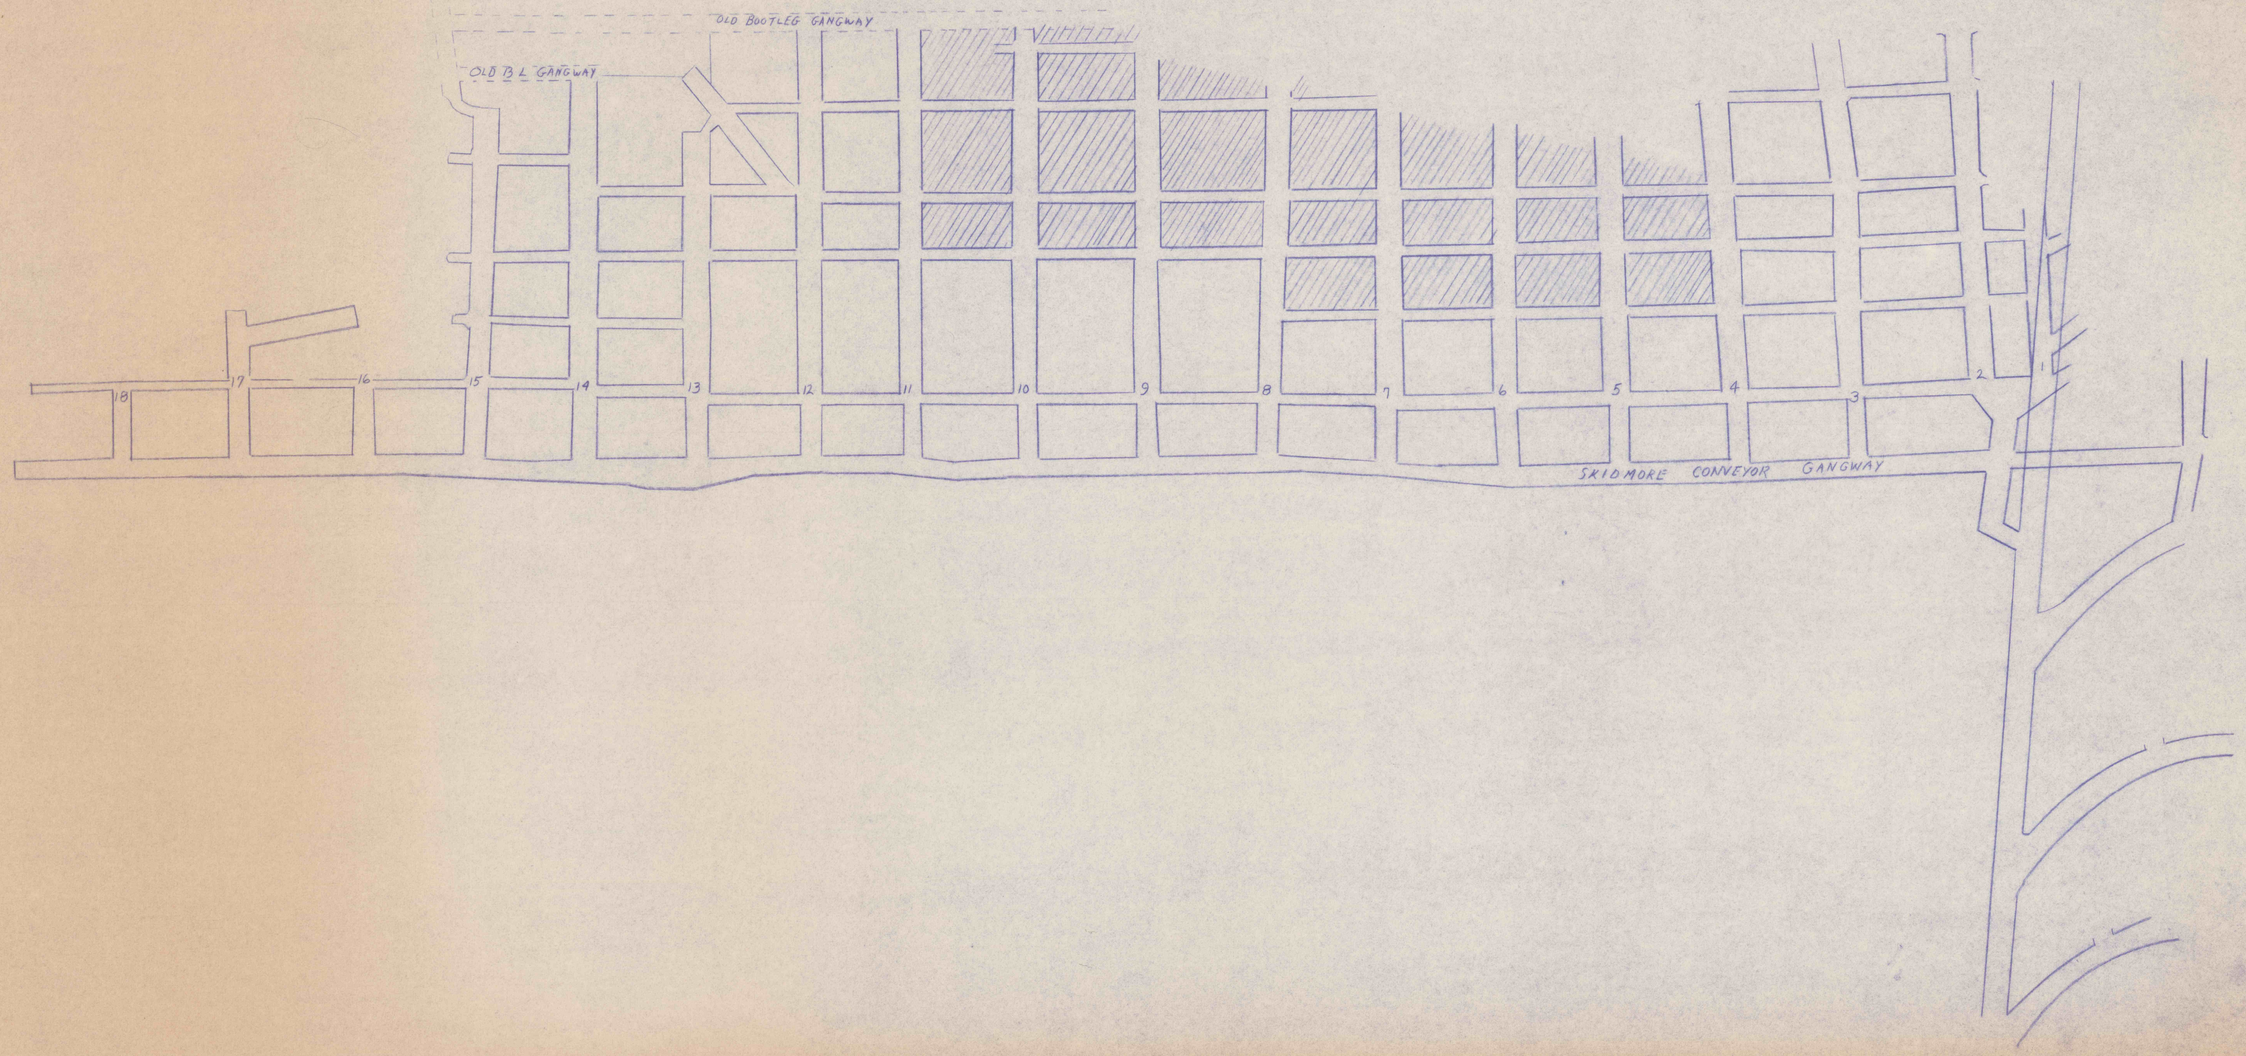
OLD BOOTLEG GANGWAY
OLD B L GANGWAY
SKIDMORE CONVEYOR GANGWAY
1
2
3
4
5
6
7
8
9
10
11
12
13
14
15
16
17
18