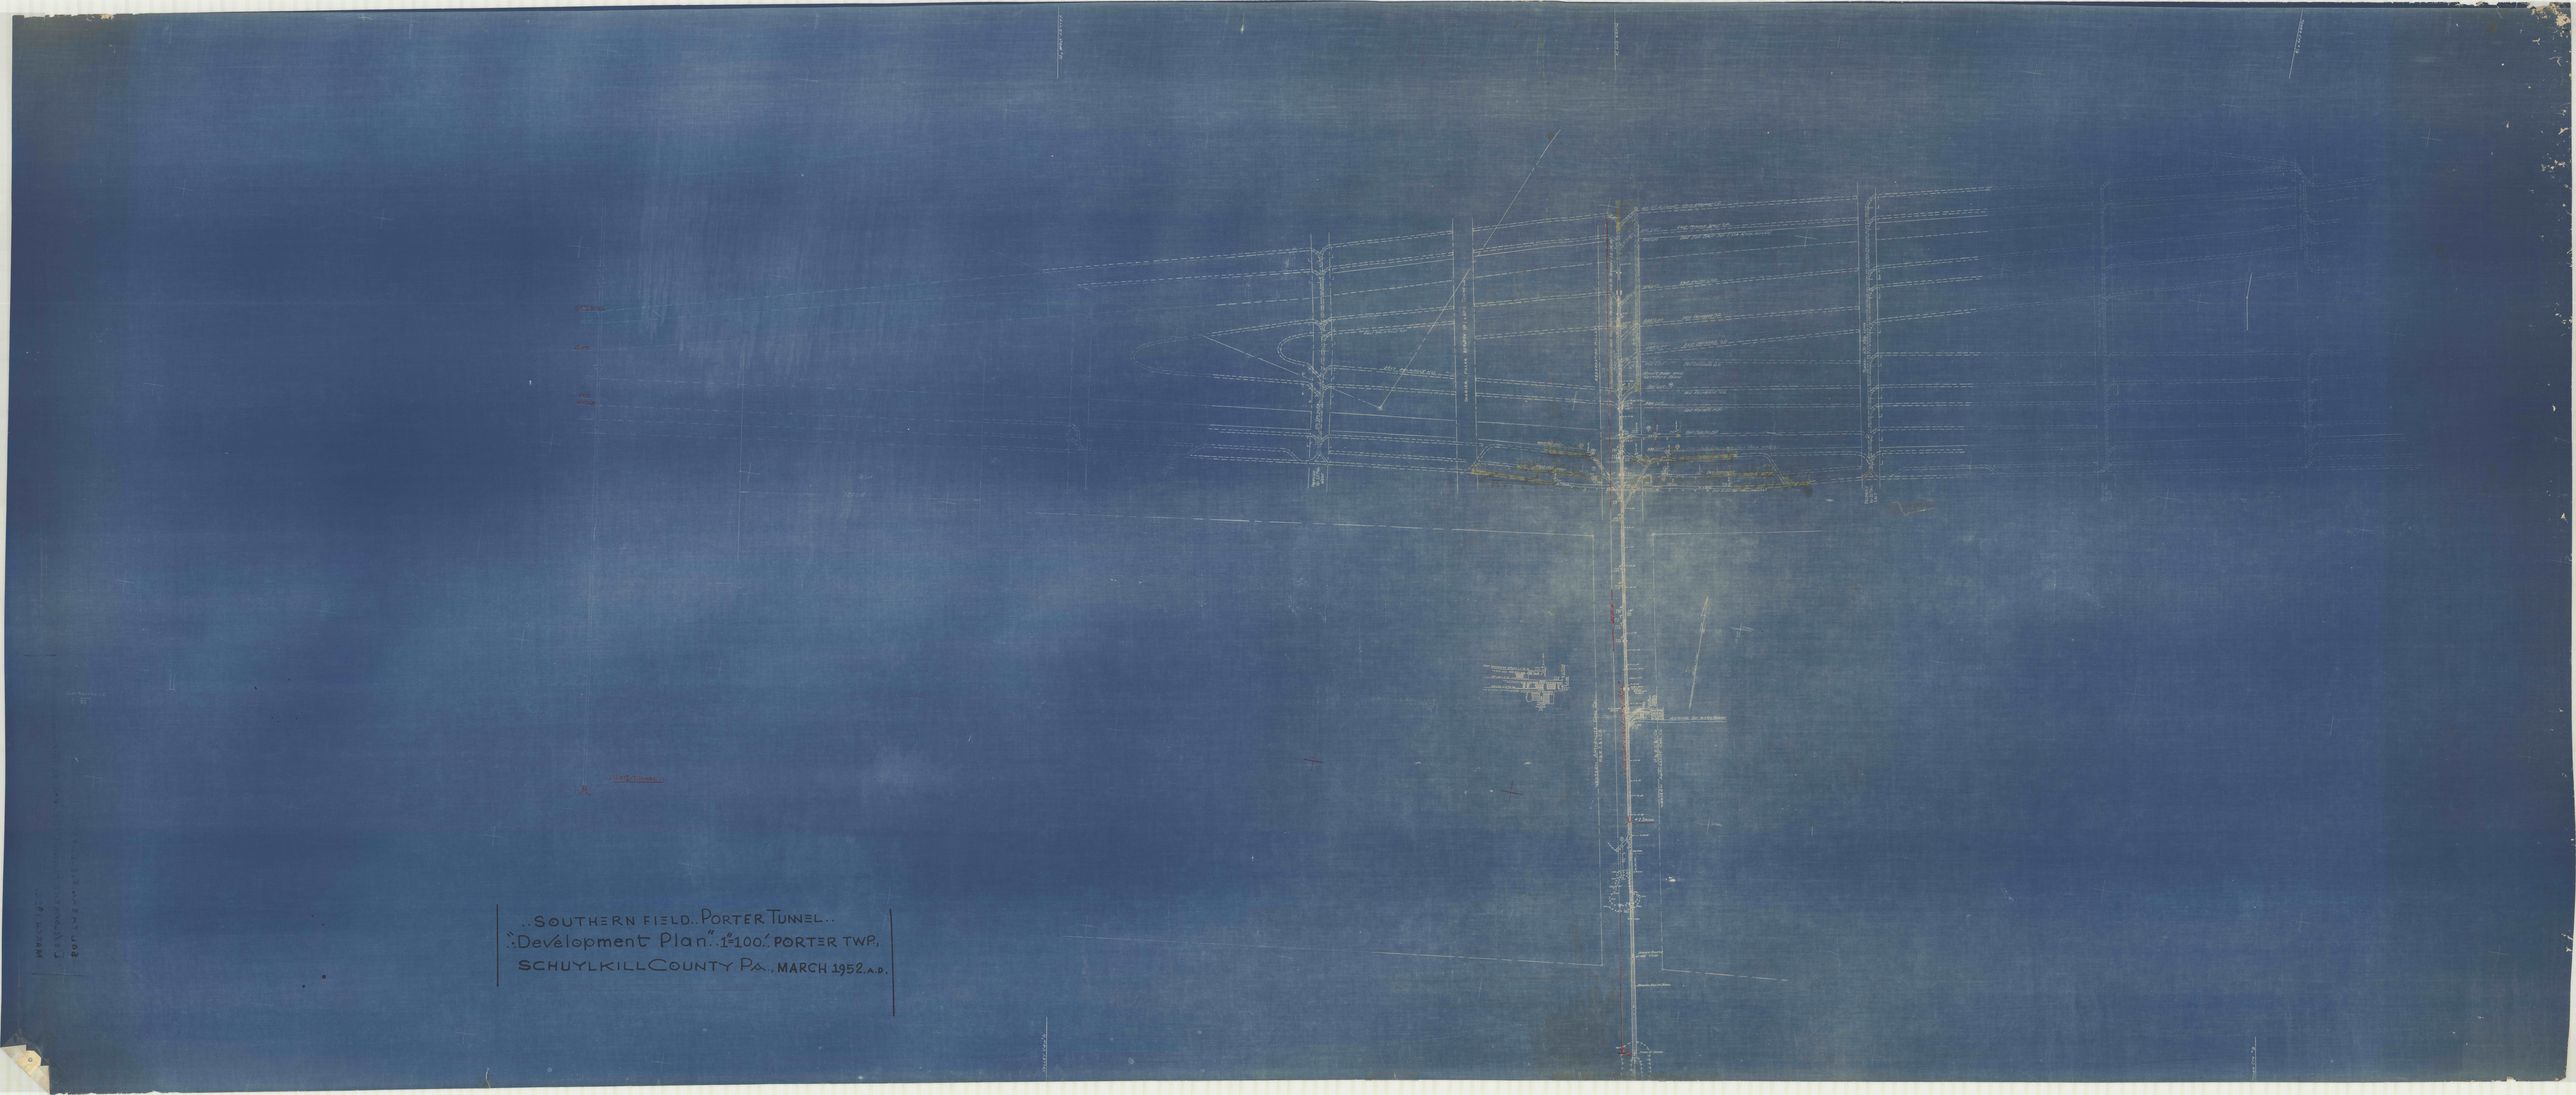

..SOUTHERN FIELD..PORTER TUNNEL..
"..Development Plan"..1"=100'..PORTER TWP,
SCHUYLKILL COUNTY PA.,MARCH 1952.A.D.