


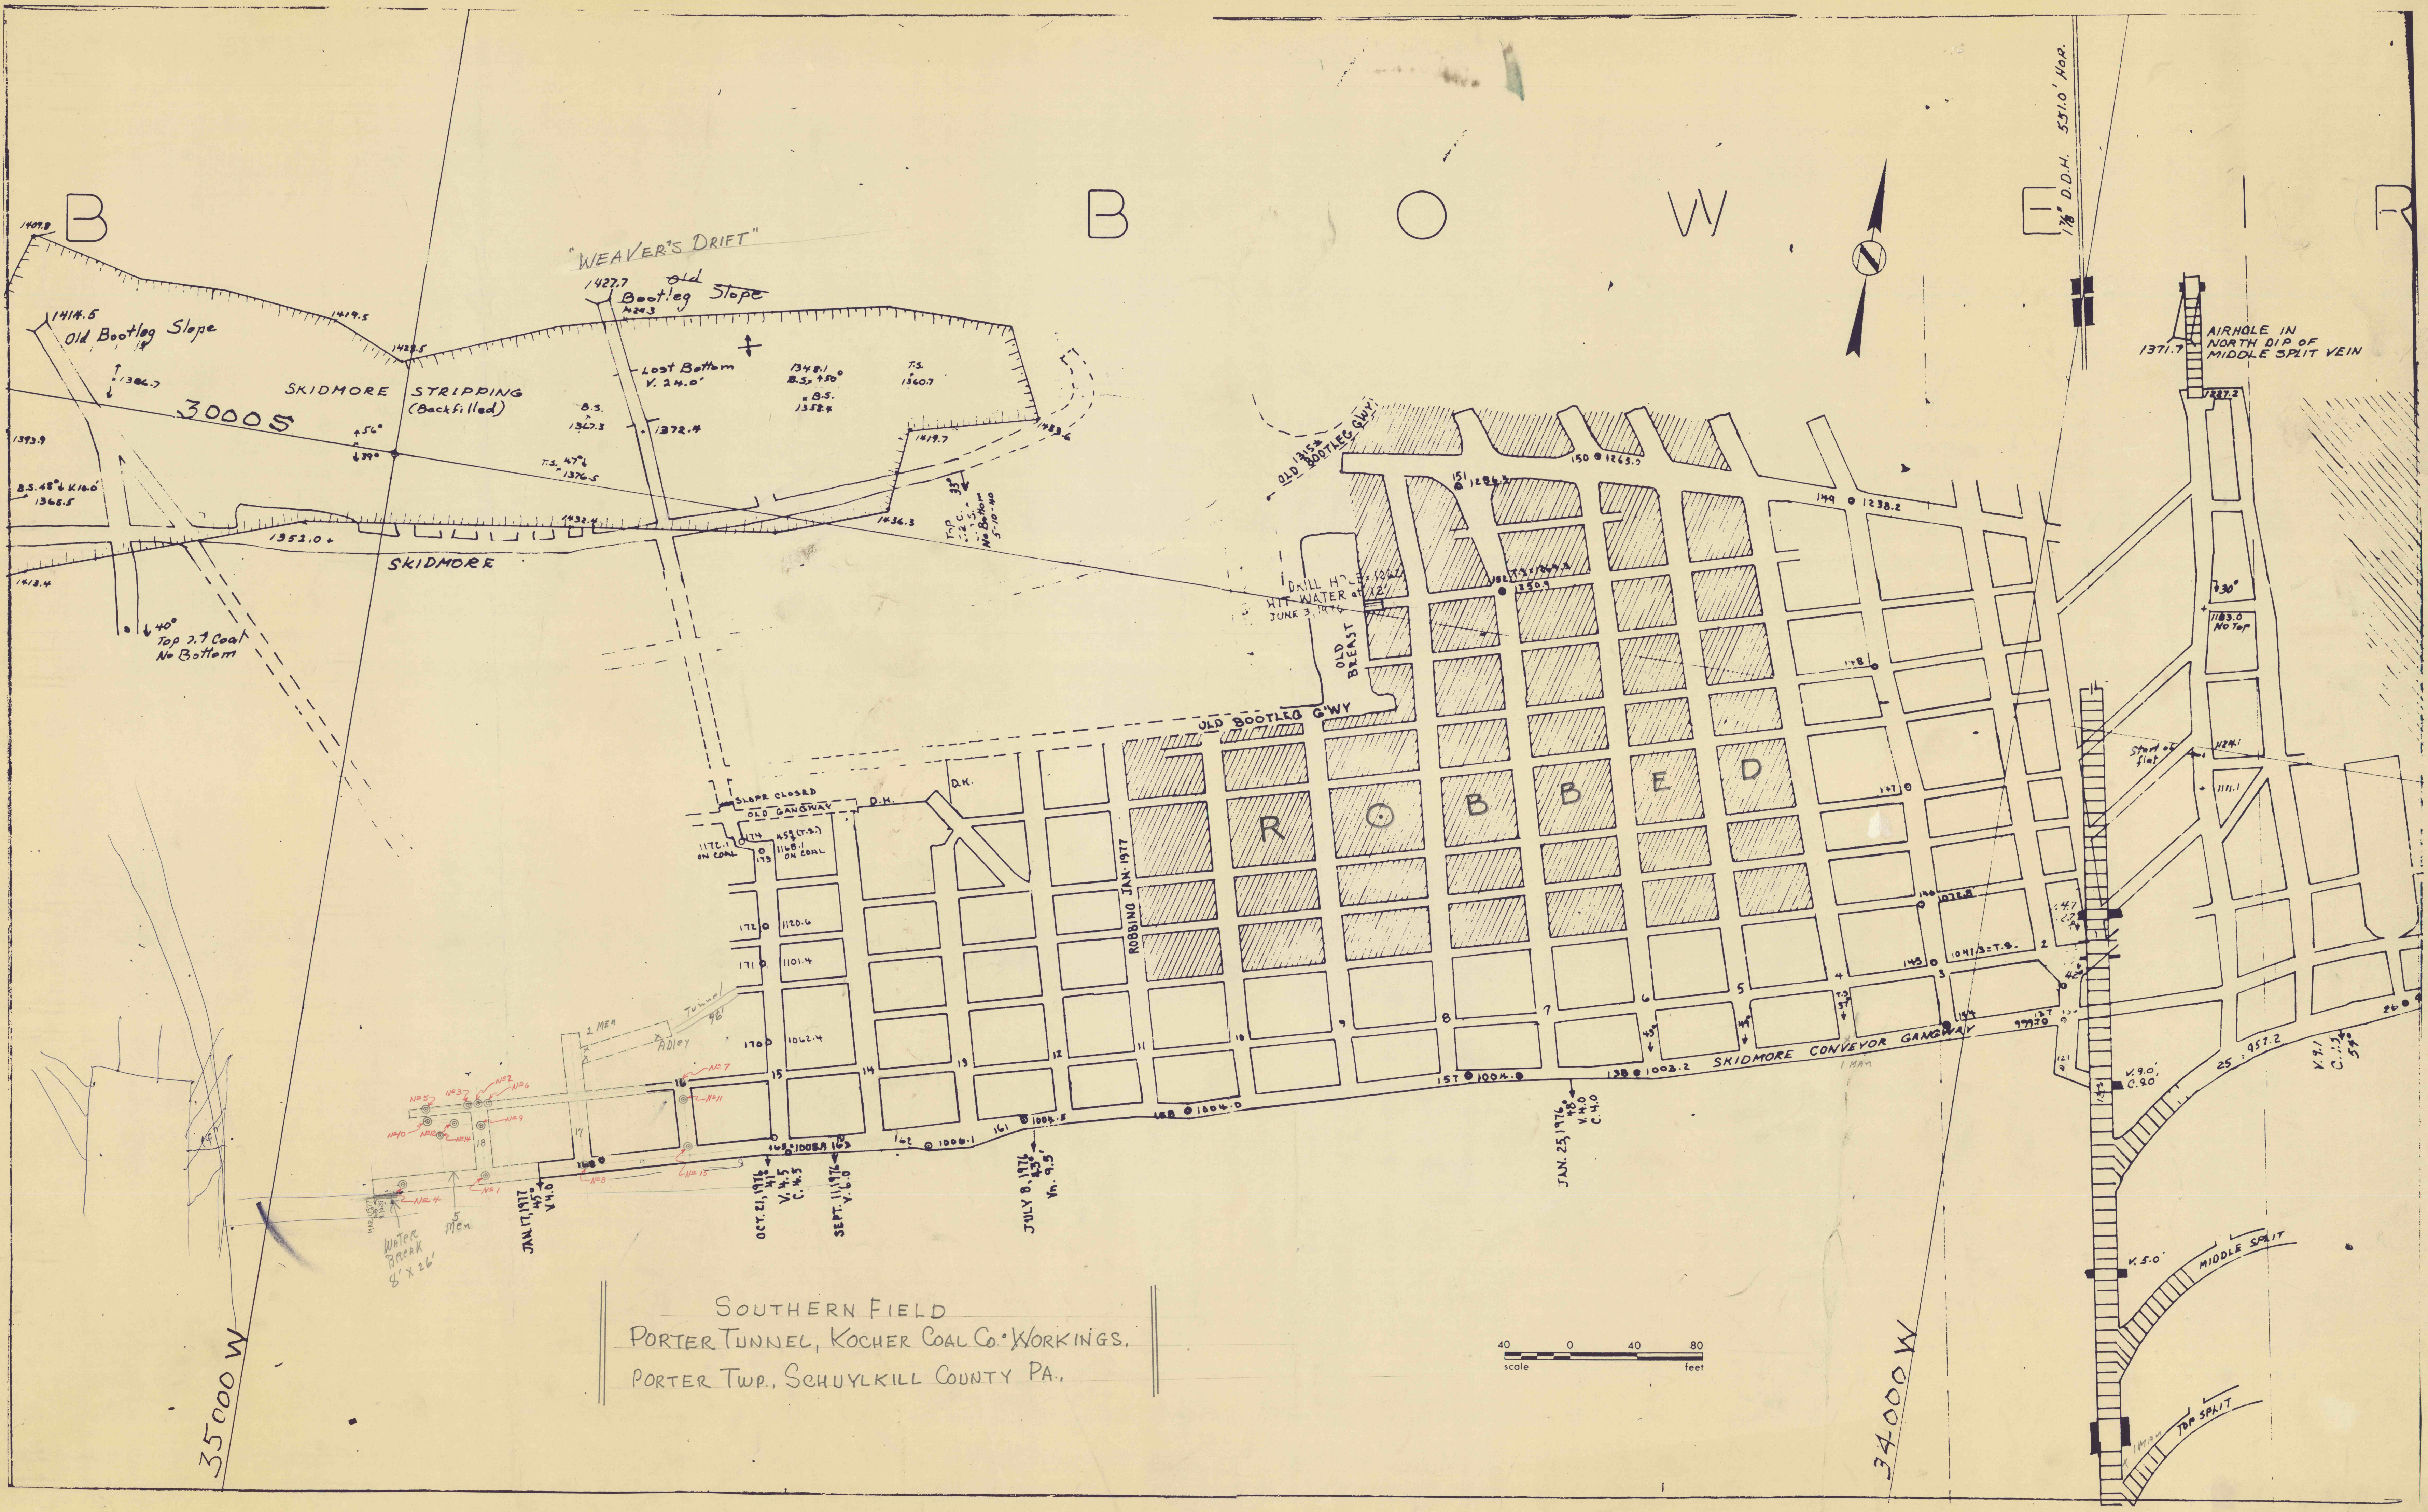

SOUTHERN FIELD
PORTER TUNNEL, KOCHER COAL CO. WORKINGS,
PORTER TWP., SCHUYLKILL COUNTY PA.

