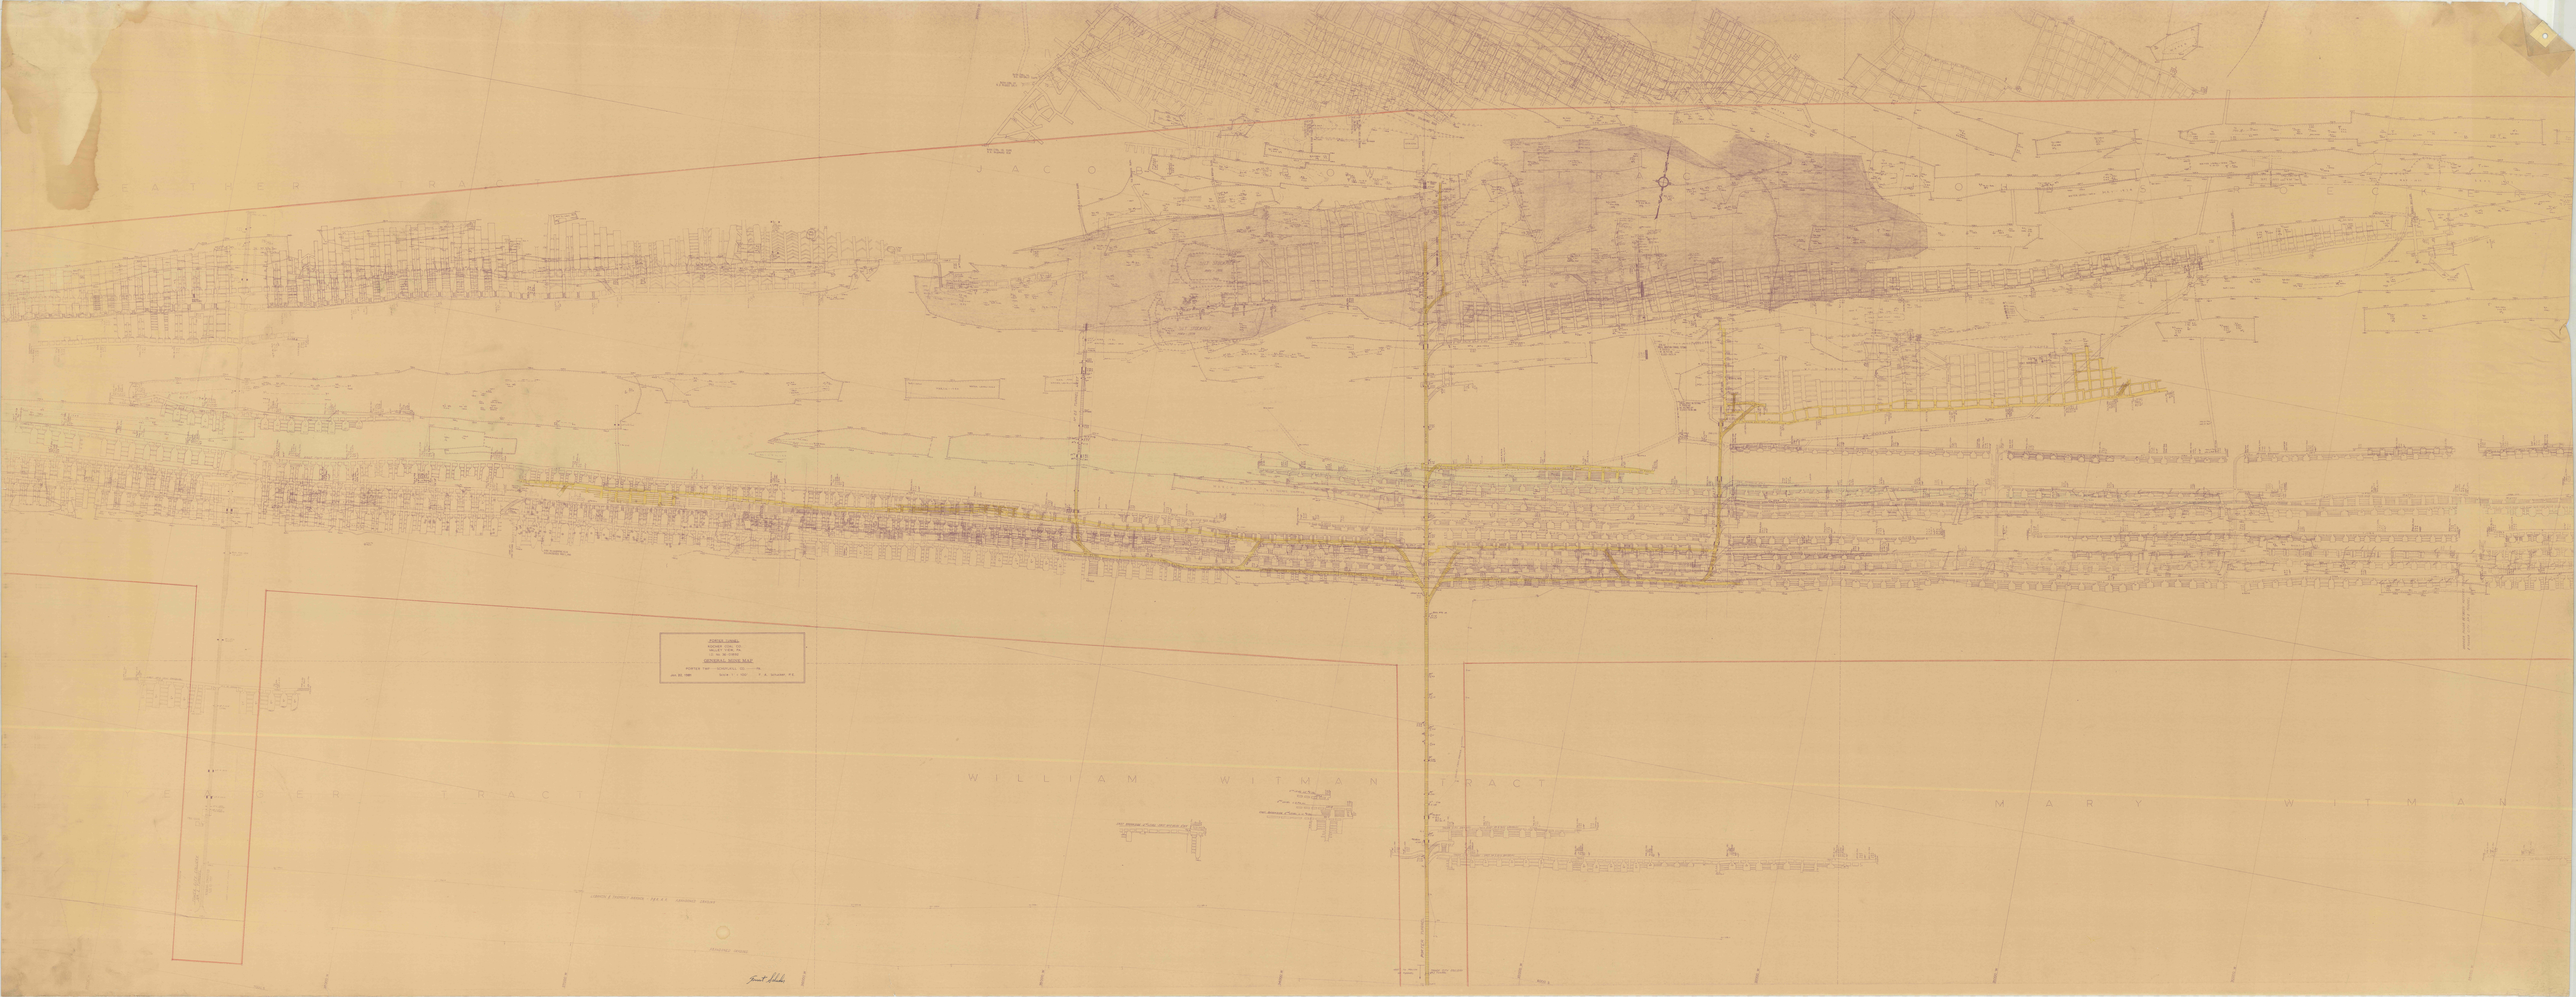
GENERAL MAP
WILLIAM WITMAN TRACT
MARY WITMAN