



QUARRY BASE

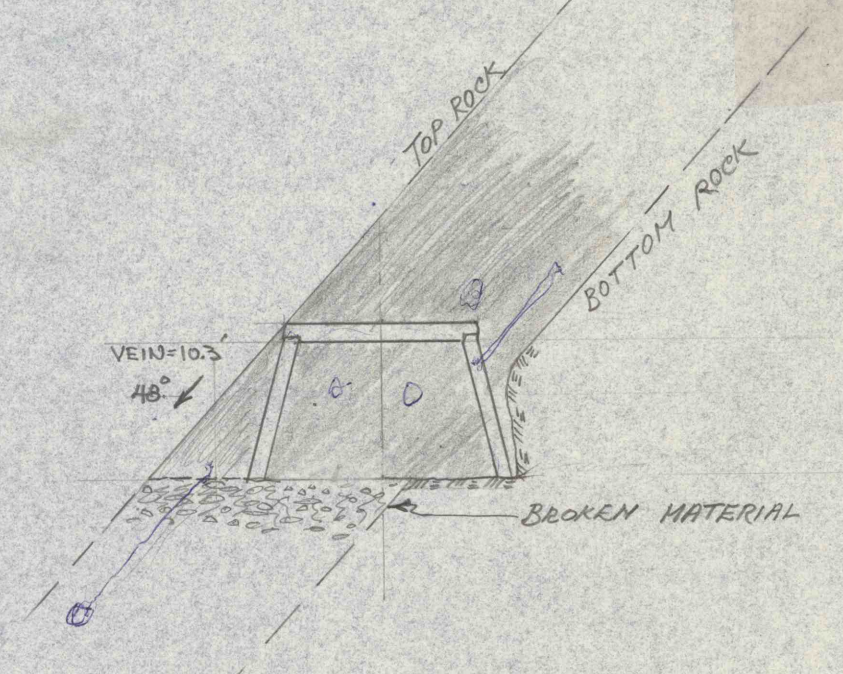

CROSS-SECTION AT FACE OF GANGWAY
Looking West MAR. 30, 1977

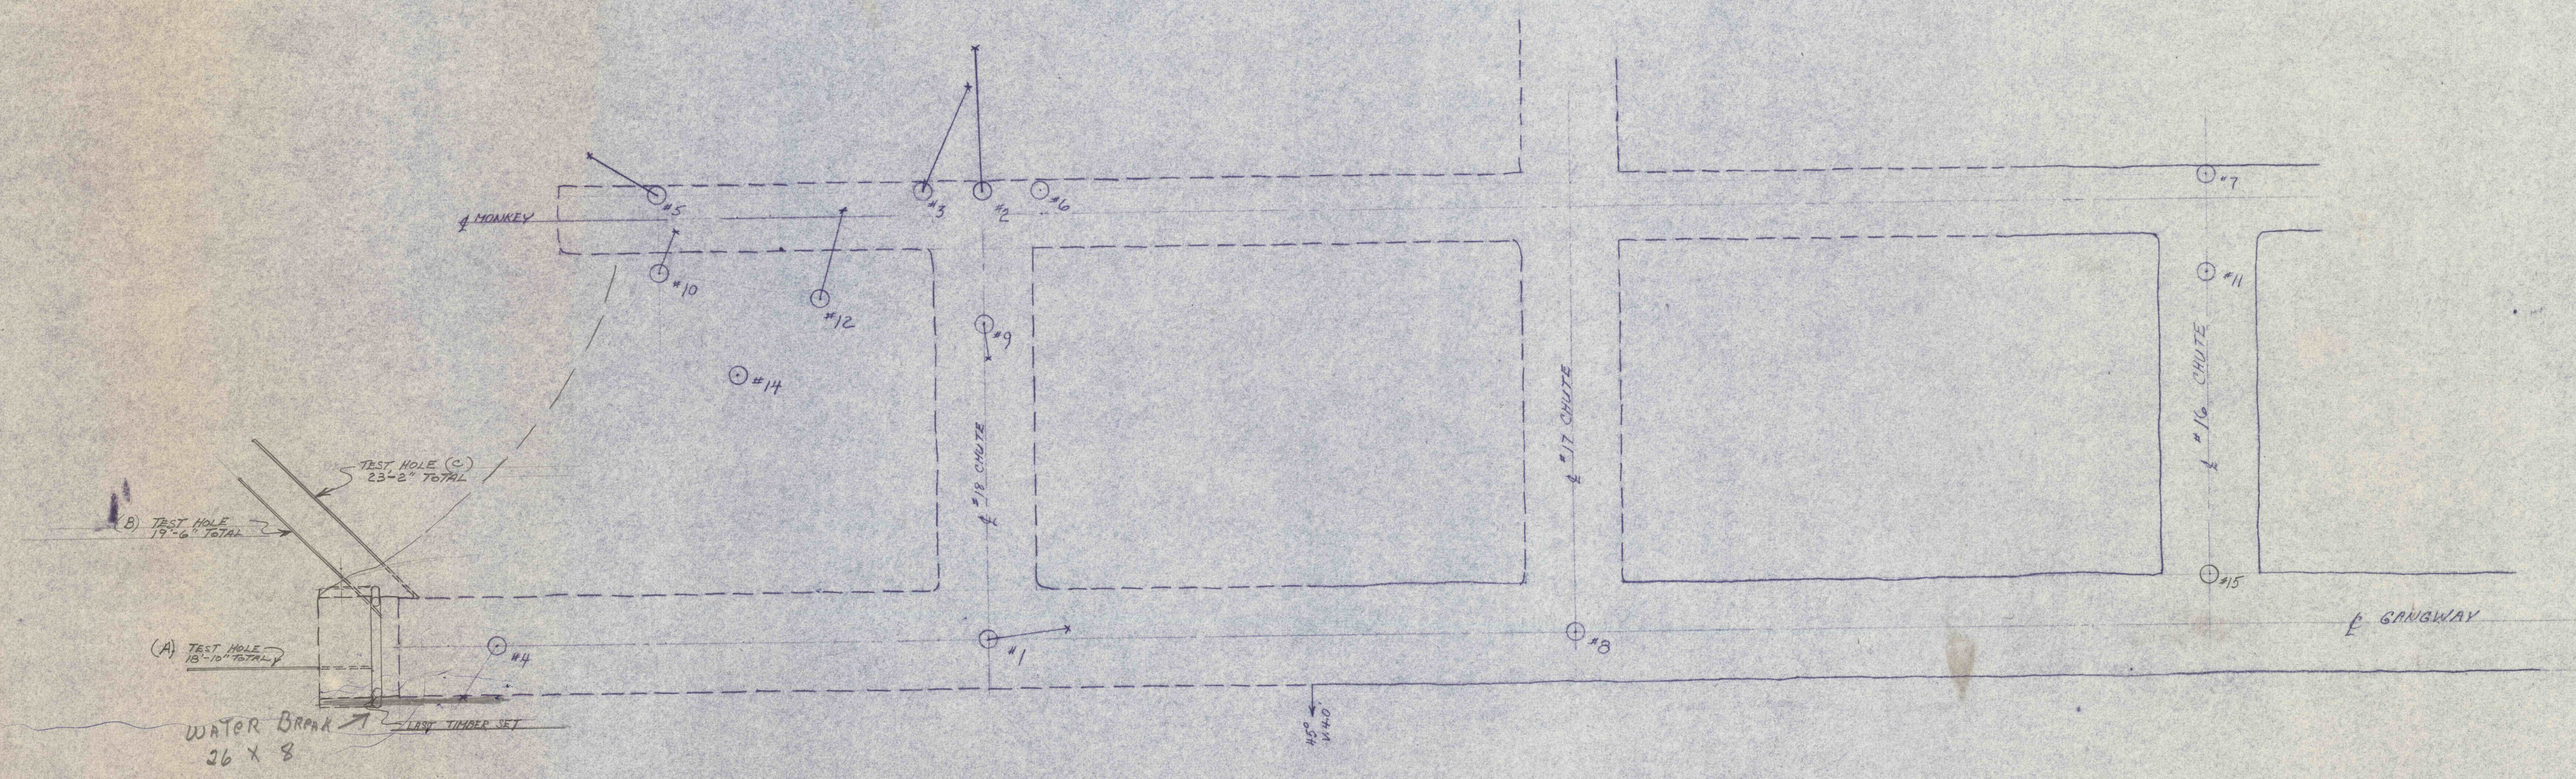

○ TOP OF HOLE
 X BOTTOM OF HOLE
 SCALE 1" = 10'
 MAR. 15, 1977
 MAR. 20, 1977