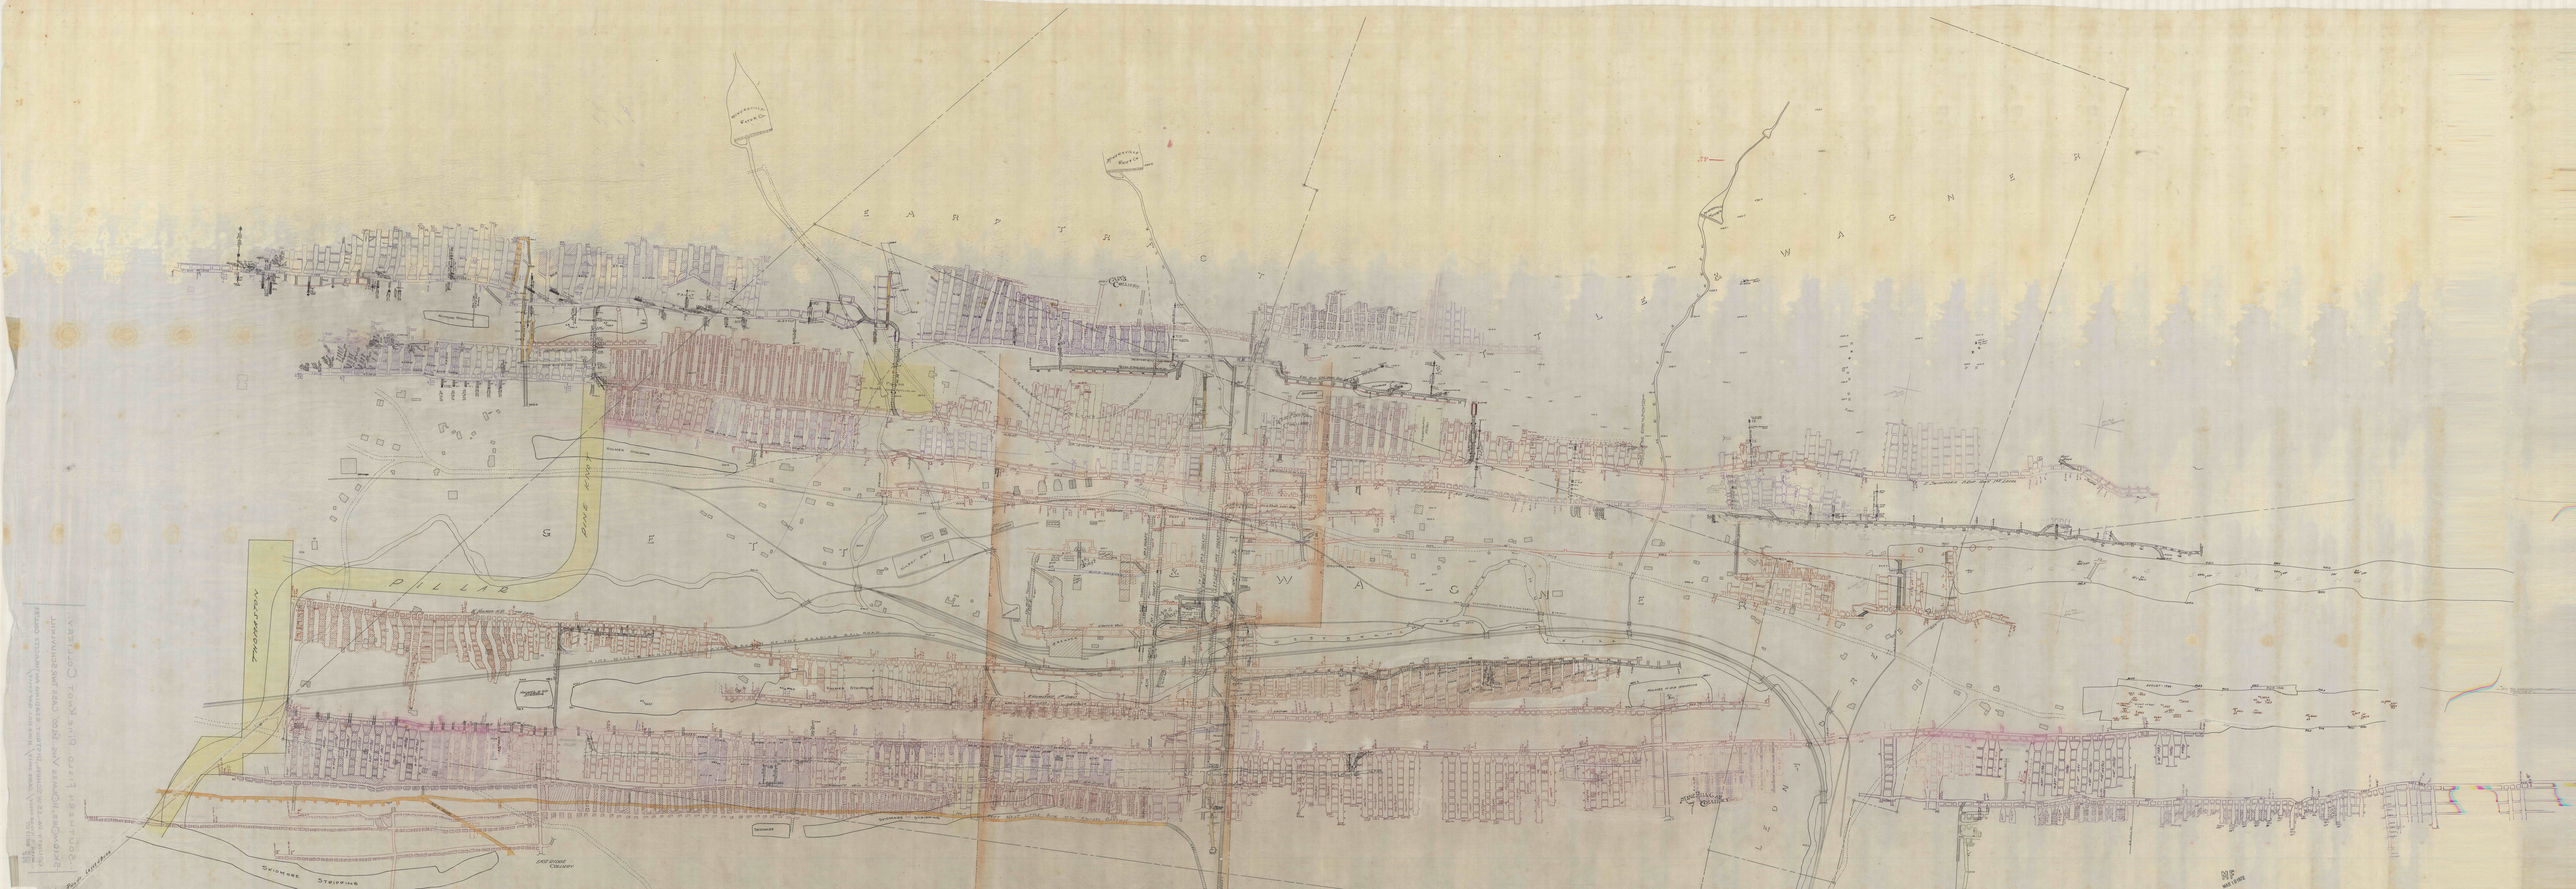

EARP TRACT
TOWER WAGNER
PILLAR
WALTHEOW
GET
Stripping
Stripping
