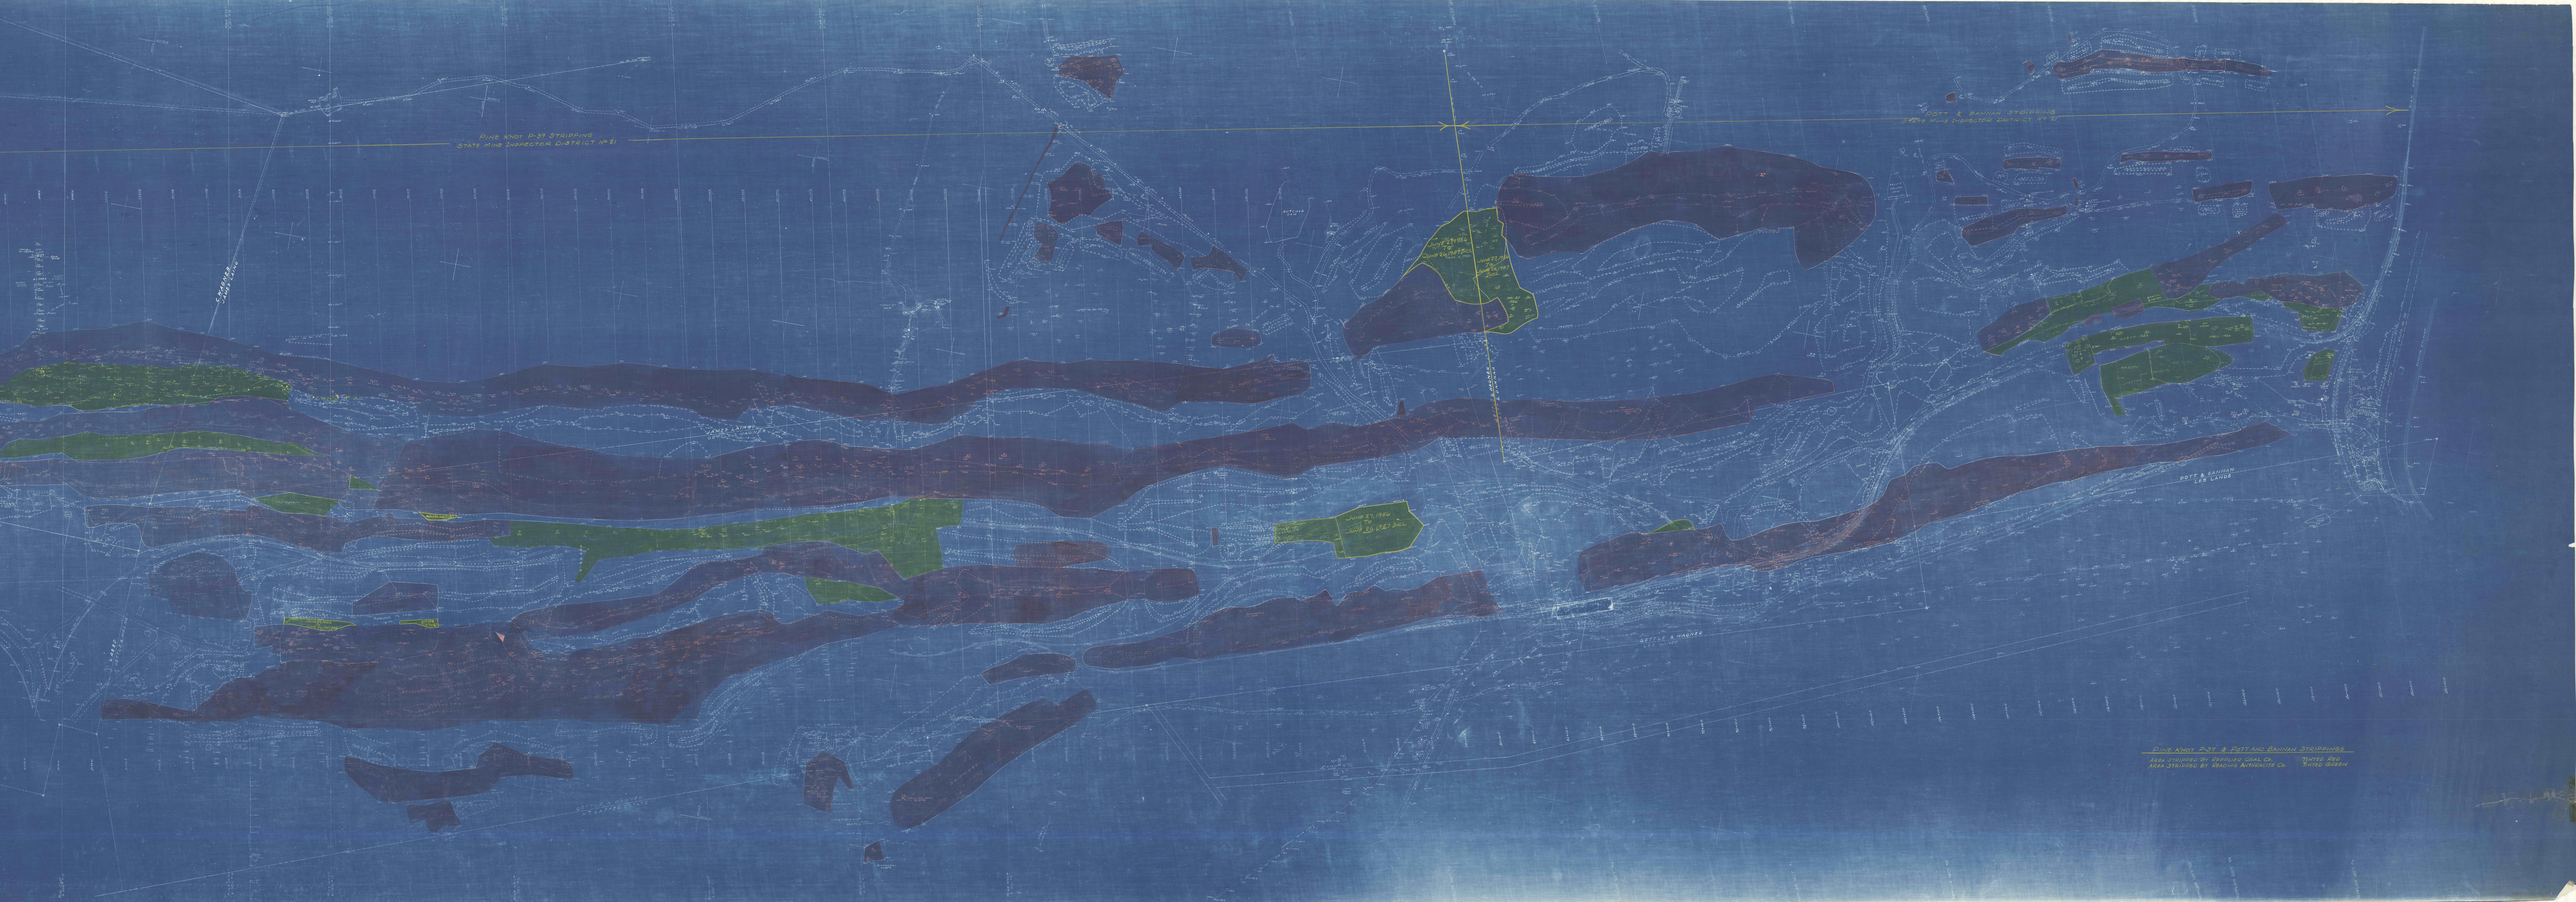
PINE KNOT P-39 STRIPPING
STATE MINE INSPECTOR DISTRICT NO 21
STATE MINE INSPECTOR DISTRICT NO 21
P-39 LEASE
GETTLE & HARLESS
