


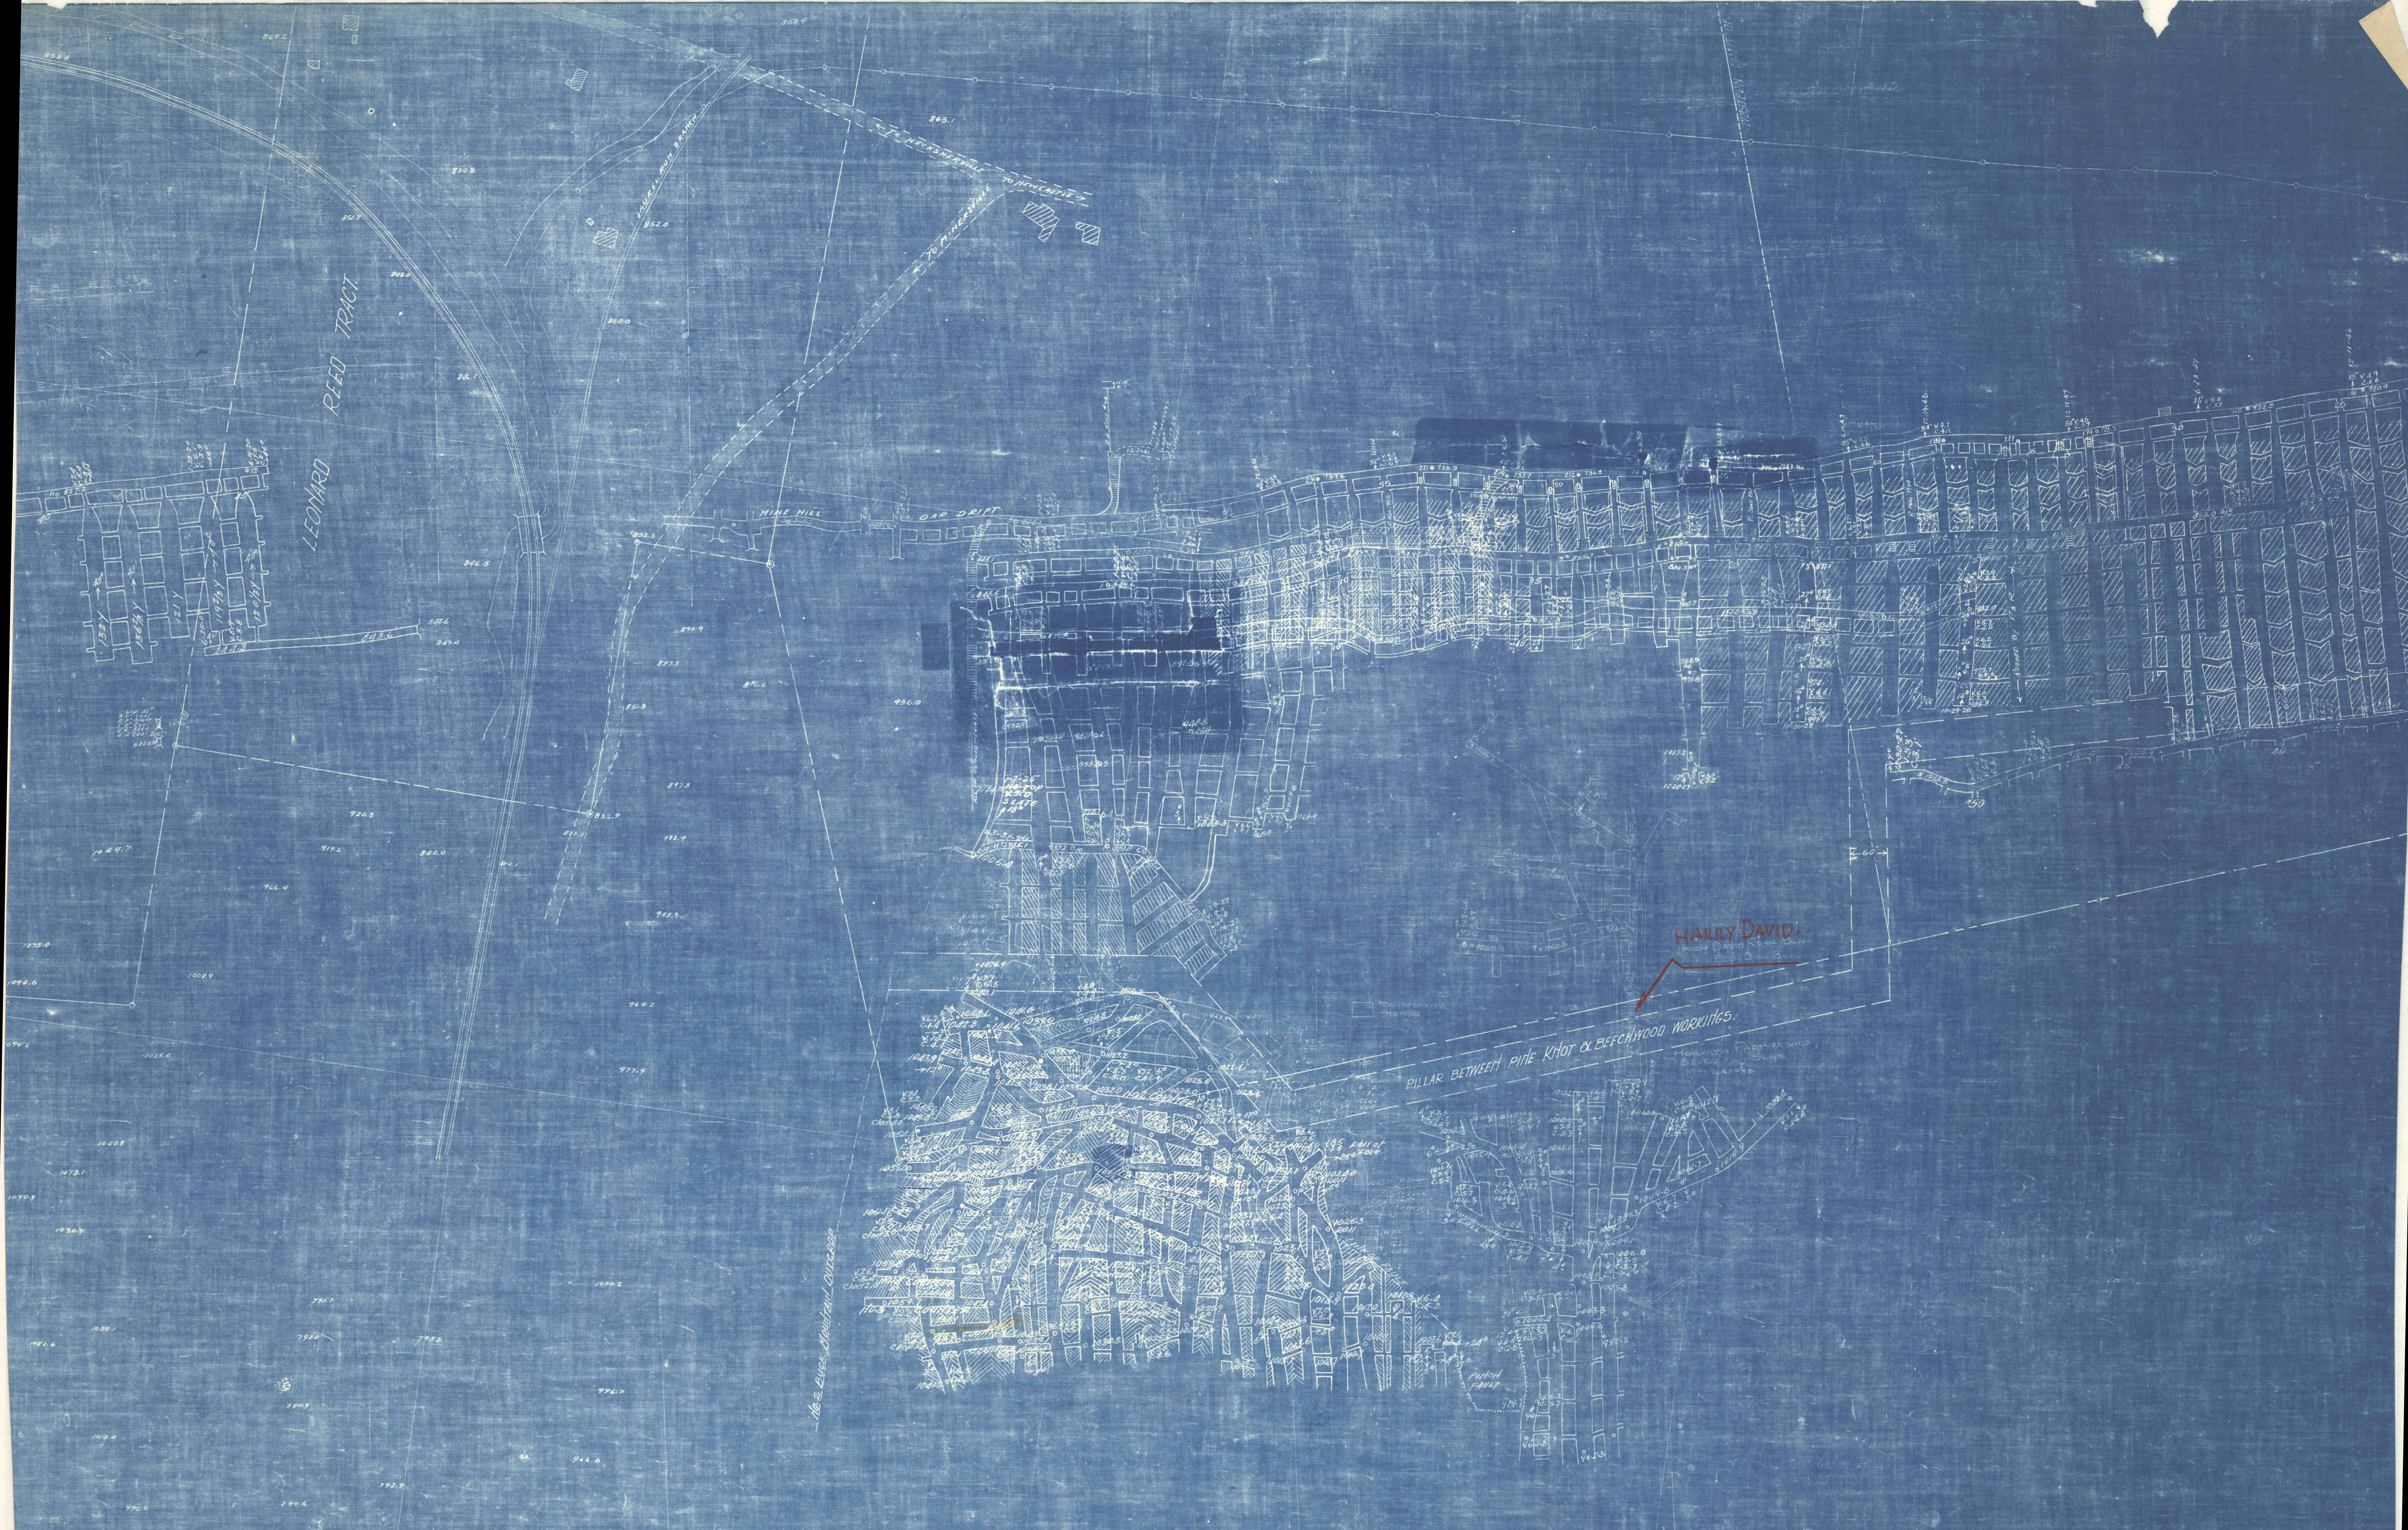

SOUTHERN FIELD. PINE KNOT Colliery. 1"=100'.
WORKINGS..WITH BEECHWOOD Colly. CASS TWP.
SCHUYLKILL COUNTY, PA. WEST SCHUY. DISTRICT. 15.
..READING ANTHRACITE COLLIERIES..
..SHEET: 1 OF 3..