


PINE K
5
SECTION 56
SECT

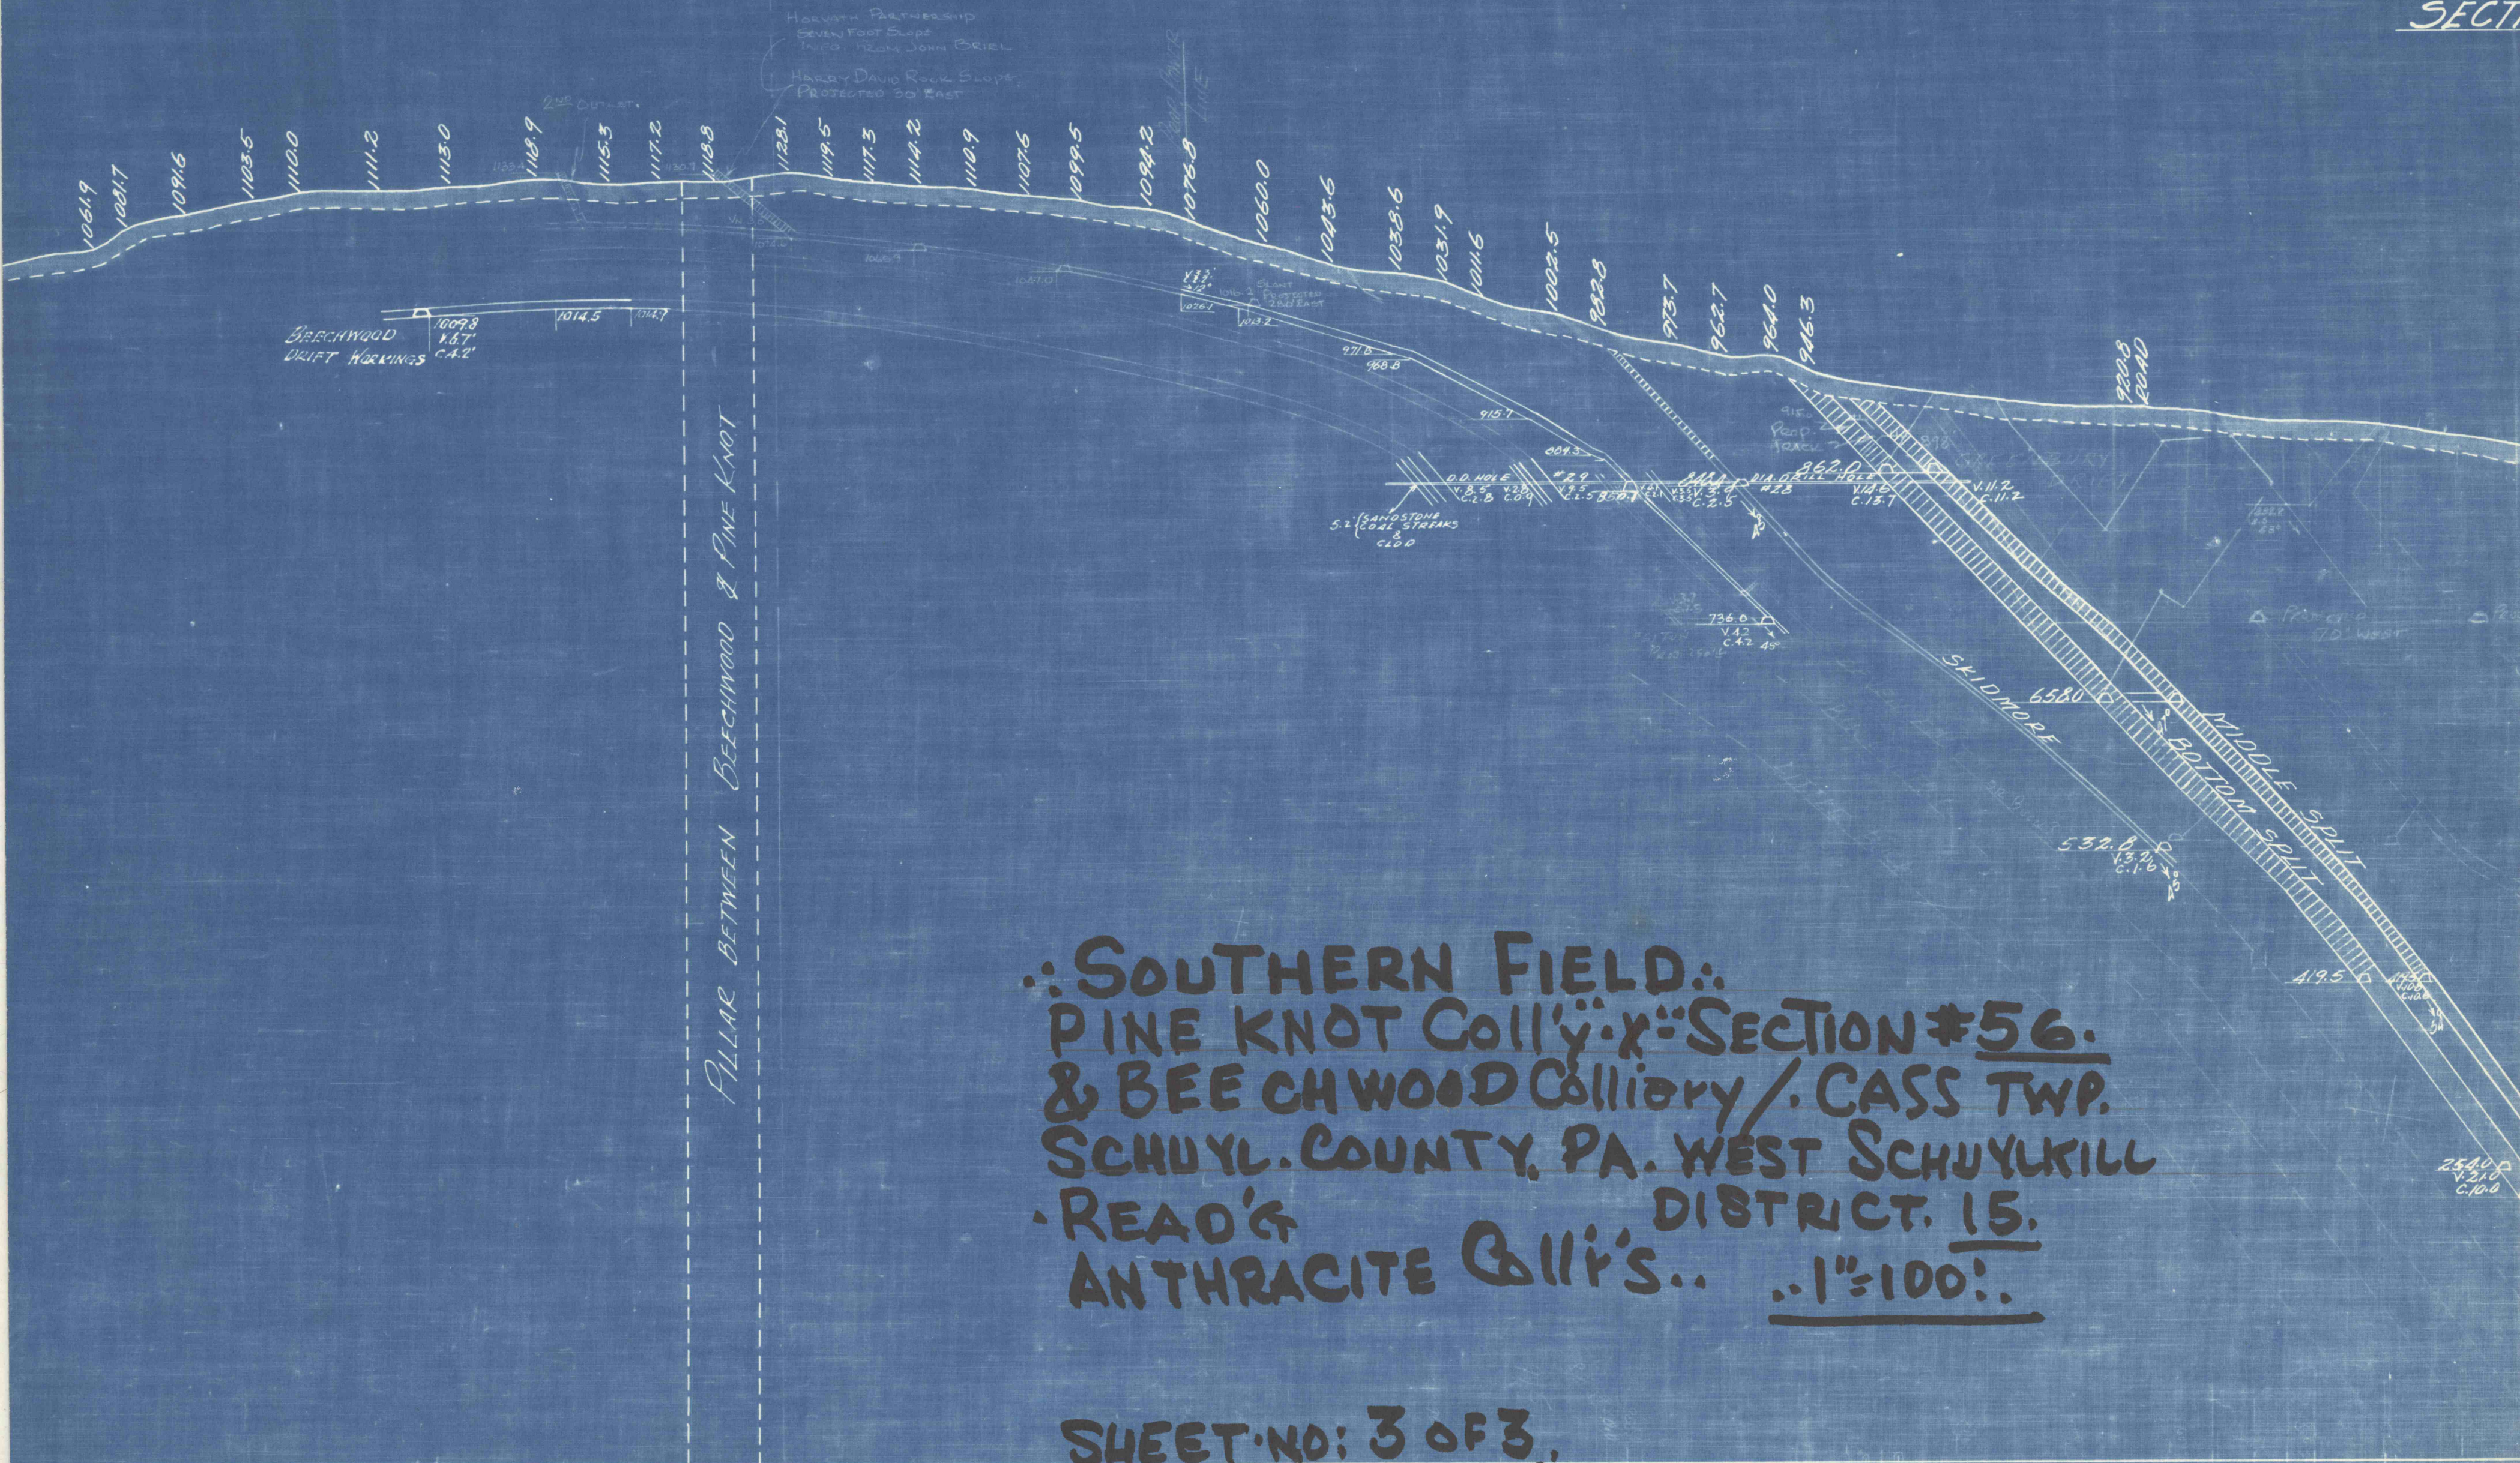

∴ SOUTHERN FIELD ∴
PINE KNOT Coll'y. x SECTION #56.
& BEECHWOOD Colliery / CASS TWP.
SCHUYL. COUNTY, PA. WEST SCHUYLKILL
READ'S DISTRICT. 15.
ANTHRACITE Coll'y's.. ∴ 1"=100' ∴