


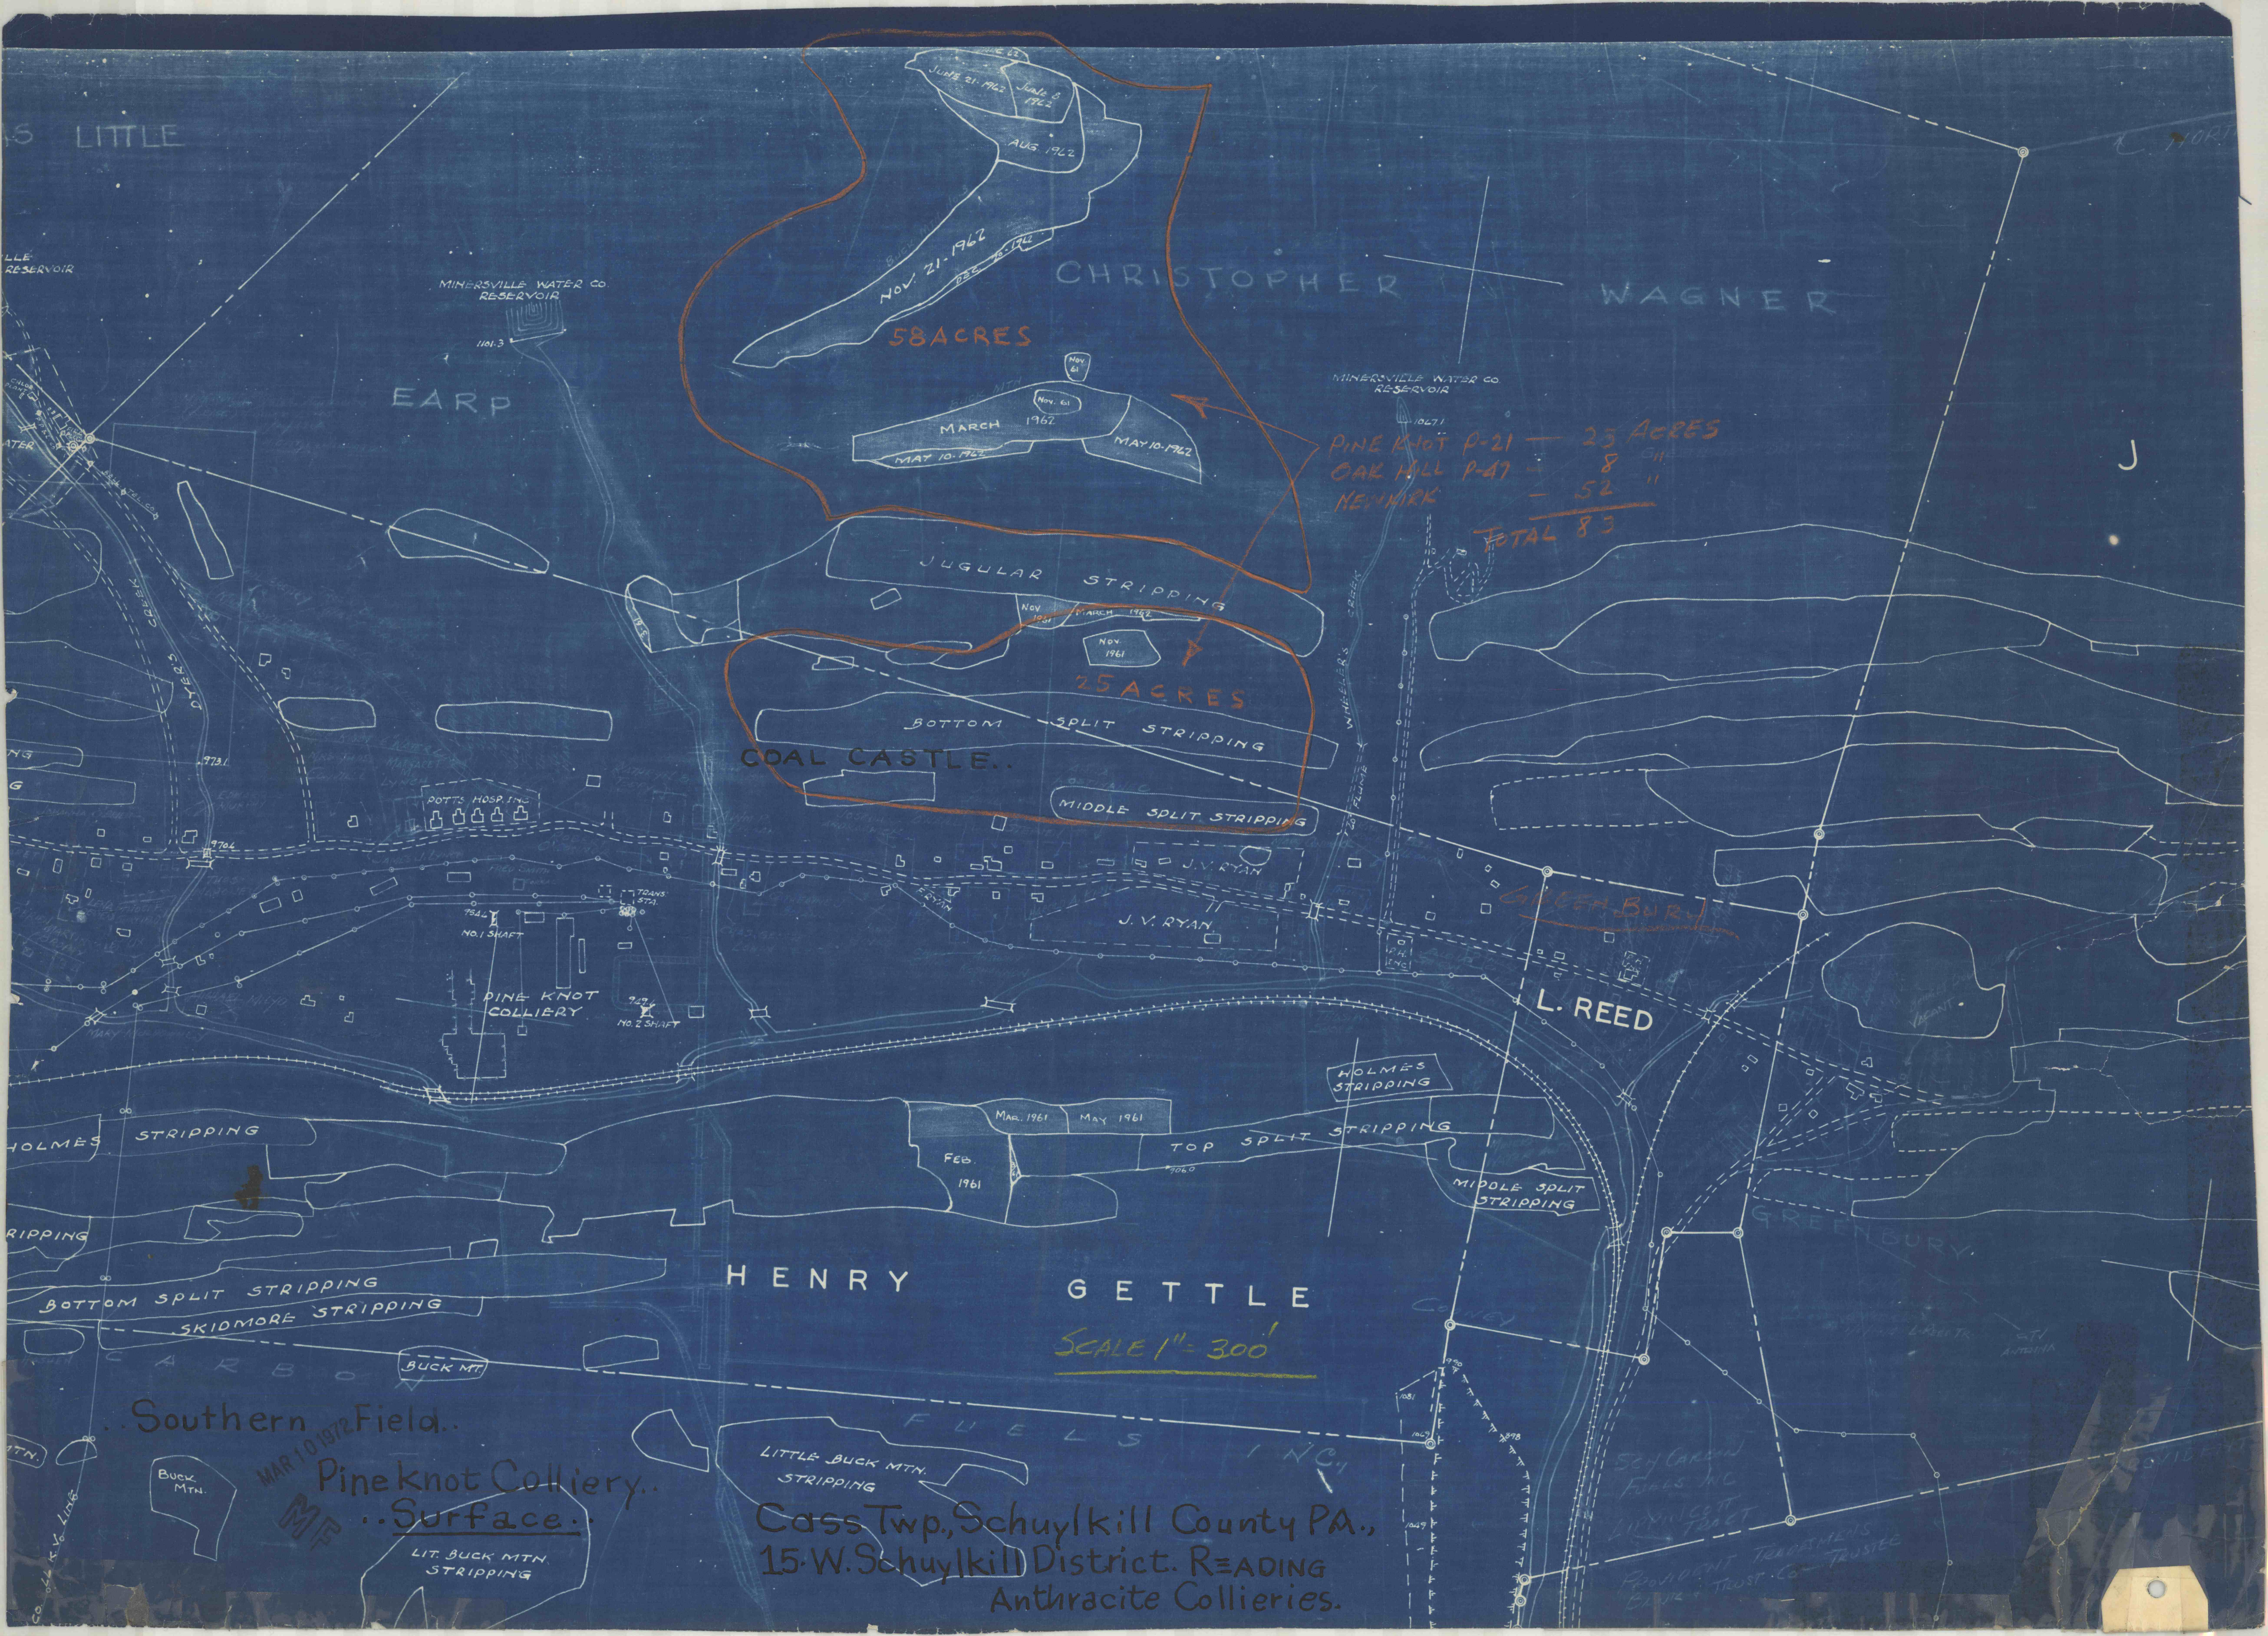

5 LITTLE

LLLE
RESERVOIR

MINERSVILLE WATER CO.
RESERVOIR

EARP

CHRISTOPHER

WAGNER

58 ACRES

MINERSVILLE WATER CO.
RESERVOIR

PINE KNOT P-21 — 23 ACRES
OAK HILL P-47 — 8 " "
NEWKIRK — 52 " "
TOTAL 83

JUGULAR STRIPPING

25 ACRES

BOTTOM SPLIT STRIPPING
COAL CASTLE..

MIDDLE SPLIT STRIPPING

POTTS HOSP. INC.

J. V. RYAN

J. V. RYAN

GREENBURY

L. REED

HOLMES STRIPPING

HOLMES STRIPPING

TOP SPLIT STRIPPING

MIDDLE SPLIT STRIPPING

BOTTOM SPLIT STRIPPING
SKIDMORE STRIPPING

HENRY

GETTLE

SCALE 1" = 300'

Southern Field..

Pine Knot Colliery..
Surface..

LITTLE BUCK MTN.
STRIPPING

Cass Twp., Schuylkill County PA.,
15 W. Schuylkill District. READING
Anthracite Collieries.

LIT. BUCK MTN.
STRIPPING

SCH. CARROLL
FUELS INC.
LIVINGSTON
TRUST

PRINCIPAL TRUSTEES
BANK & TRUST CO. TRUSTEE