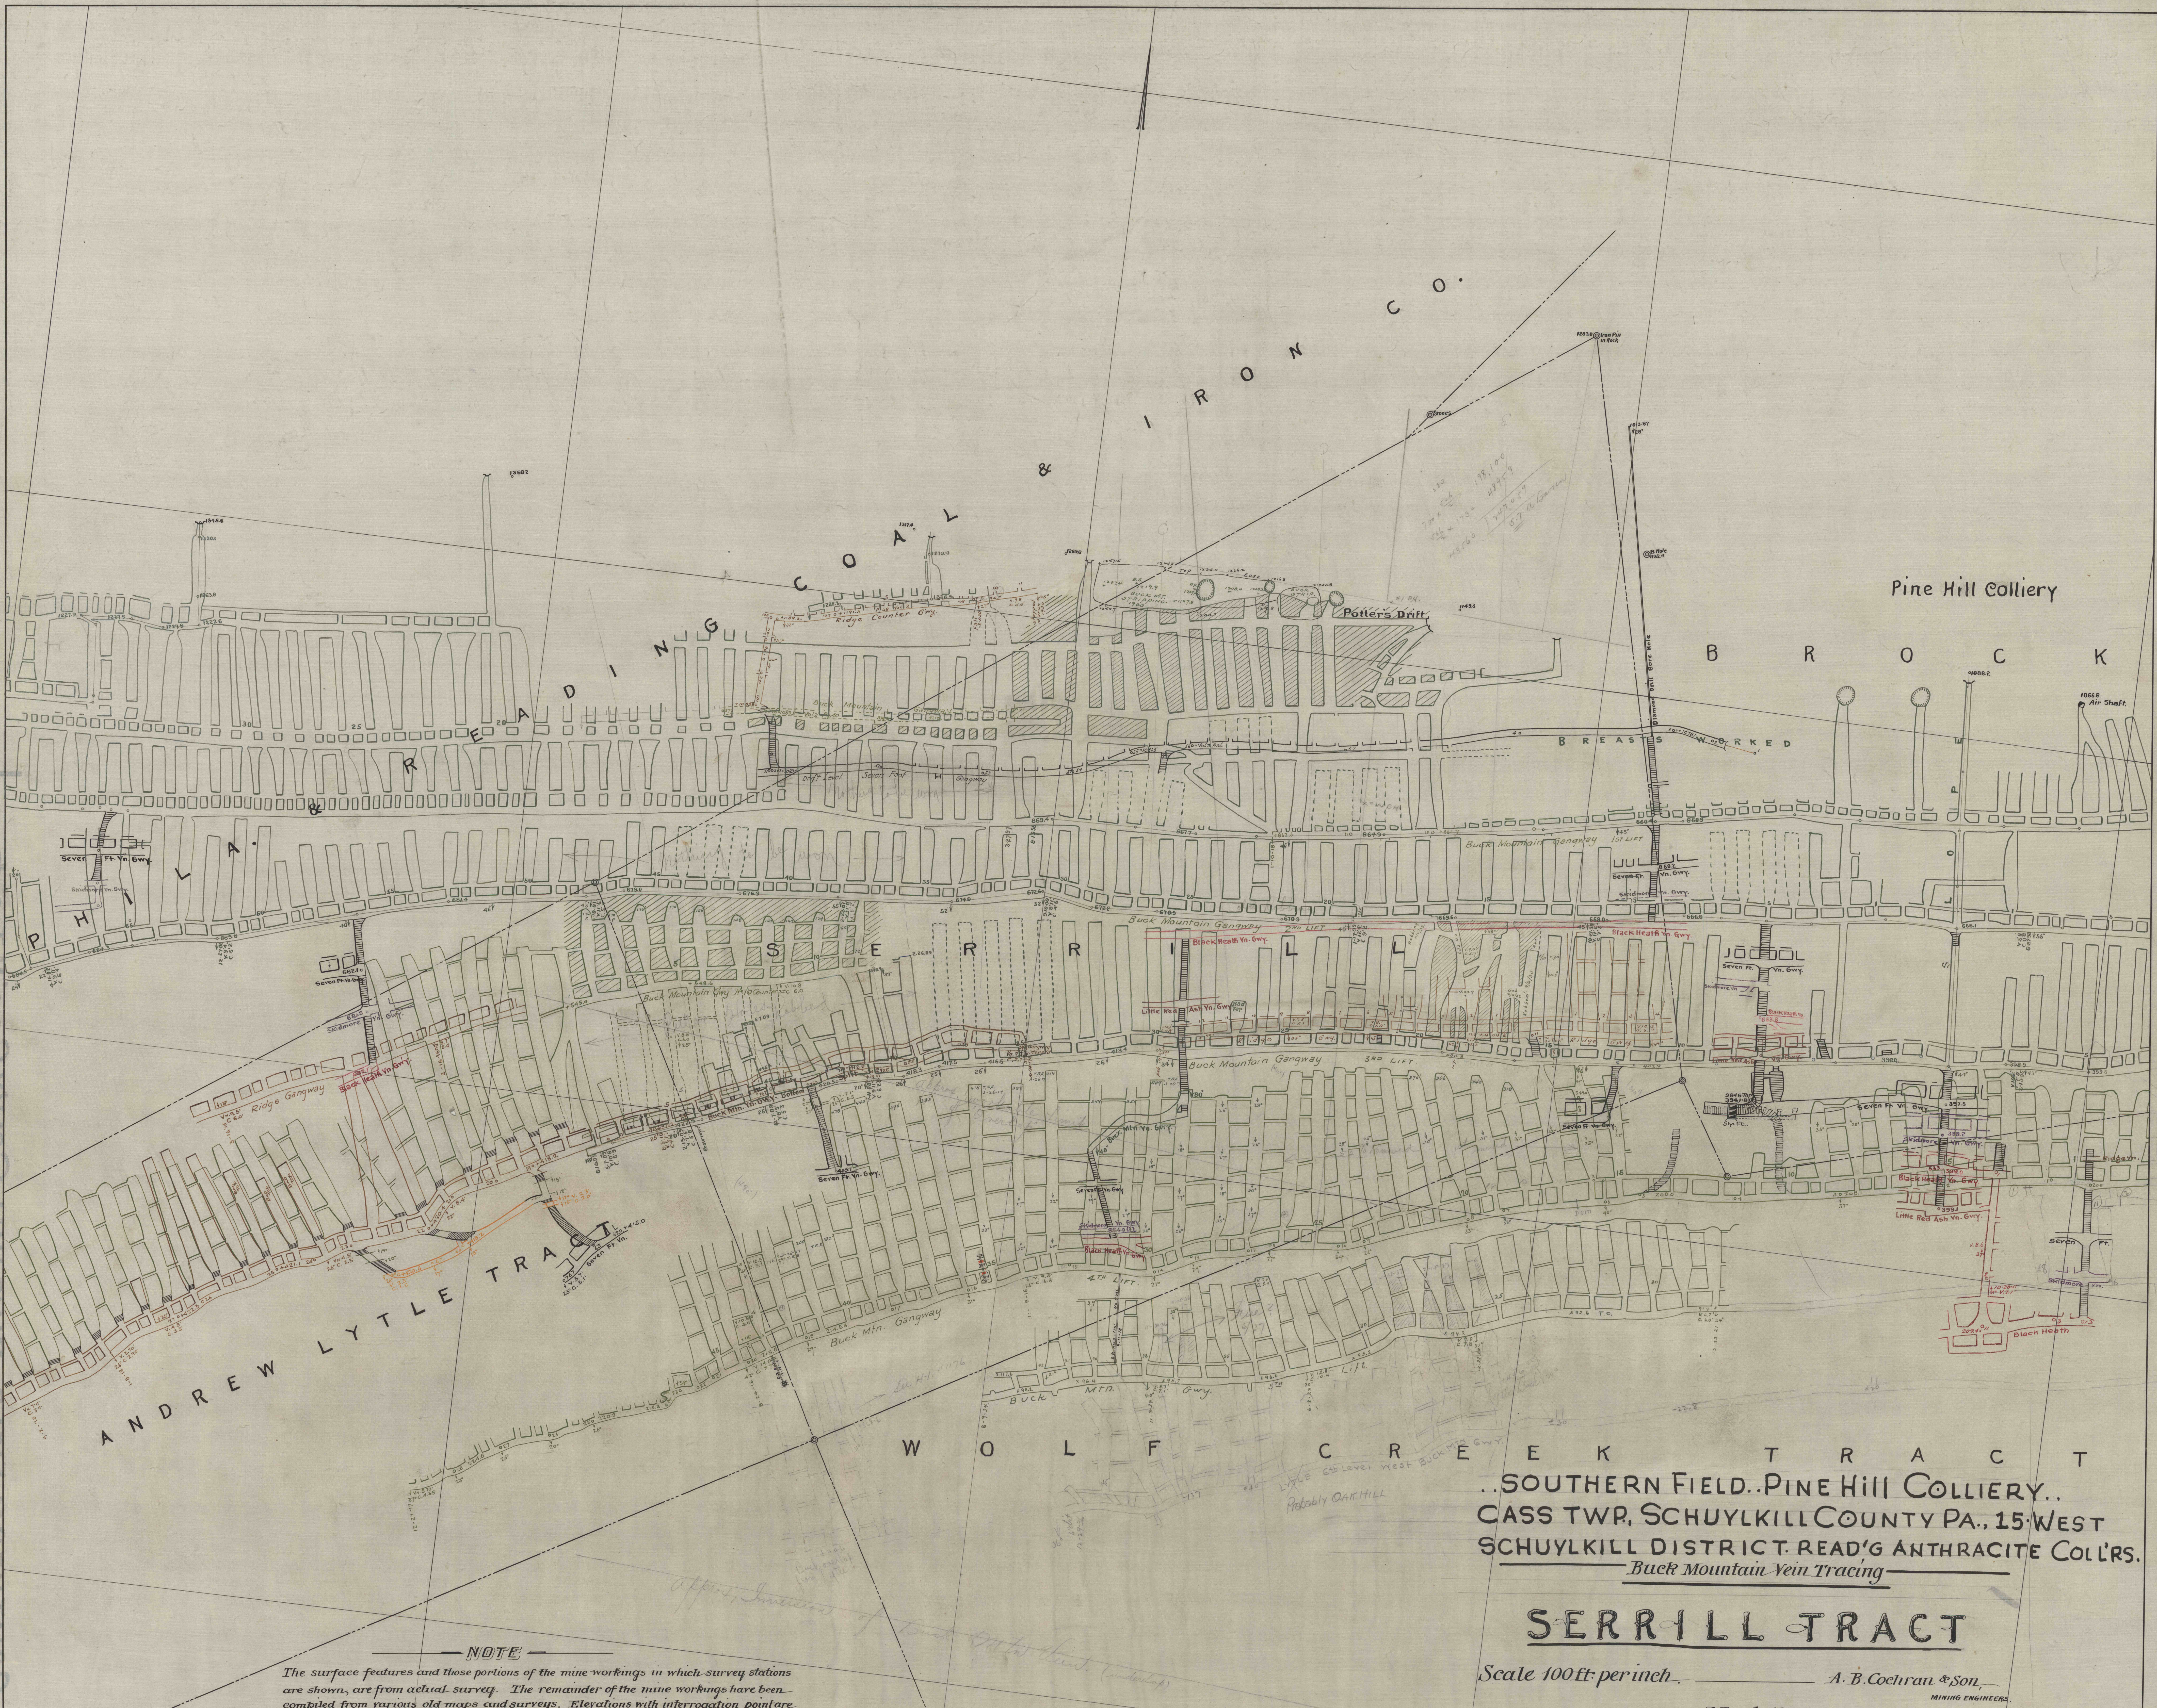
PHILA. & READING COAL & IRON CO.
BROCK
Pine Hill Colliery
SERRILL
ANDREW LYTLE TRACT
WOLF CREEK TRACT
Potters Drift
Air Shaft.
1066.8
Iron Pin in Rock
1283.0
Stones
B. Hole 1132.4
Diamond Drill Bore Hole
BREASTS WORKED
Ridge Counter Gwy.
BUCK MT. STRIPPING 1905
BUCK STRIP.
Drift Level Seven Foot Gangway
Buck Mountain Gangway
Buck Mountain Gangway 1ST LIFT
Buck Mountain Gangway 2ND LIFT
Buck Mountain Gangway 3RD LIFT
4TH LIFT
Buck Mtn. Gwy. 5TH Lift
Buck Mtn. Gangway
Buck Mtn. Yn. Gwy. bottom
Buck Mtn. Yn. Gwy.
Buck Mountain Gwy. No 10 Counter
Seven Ft. Yn. Gwy.
Skidmore Yn. Gwy.
Black Heath Yn. Gwy.
Little Red Ash Yn. Gwy.
Ridge Gangway
Ridge Gwy.
Ridge Yn.
Seven Ft. Vn.
Black Heath
Shaft.
Nothing to be won
Robbed
Probably OAK HILL
Lytle 6th Level West Buck Mtn. Gwy.
See H-1 #1176
Approx. Inversion of Buck Mtn. Vein. (underlap)
6th L. W. Buck
14
-29.5
← 160' to turn to 7 ft where there is a seal #10
also a seal in #1 chute 40' N of Gwy #9
700 × 566/4 = 198,100
566/4 × 173 = 48959
43560 | 247,059
5.7 A Barren

..SOUTHERN FIELD..PINE HILL COLLIERY..
CASS TWP., SCHUYLKILL COUNTY PA., 15·WEST
SCHUYLKILL DISTRICT. READ'G ANTHRACITE COLL'RS.

Buck Mountain Vein Tracing

SERRILL TRACT

Scale 100 ft. per inch. — *A. B. Cochran & Son,*
MINING ENGINEERS.

March 1910.

NOTE

The surface features and those portions of the mine workings in which survey stations are shown, are from actual survey. The remainder of the mine workings have been compiled from various old maps and surveys. Elevations with interrogation point are estimated or taken from old maps and surveys.

Compiled Nov. 19, 1915 By Est. of P.W. Sheafer Decd. Pottsville Pa.

C-7
708