


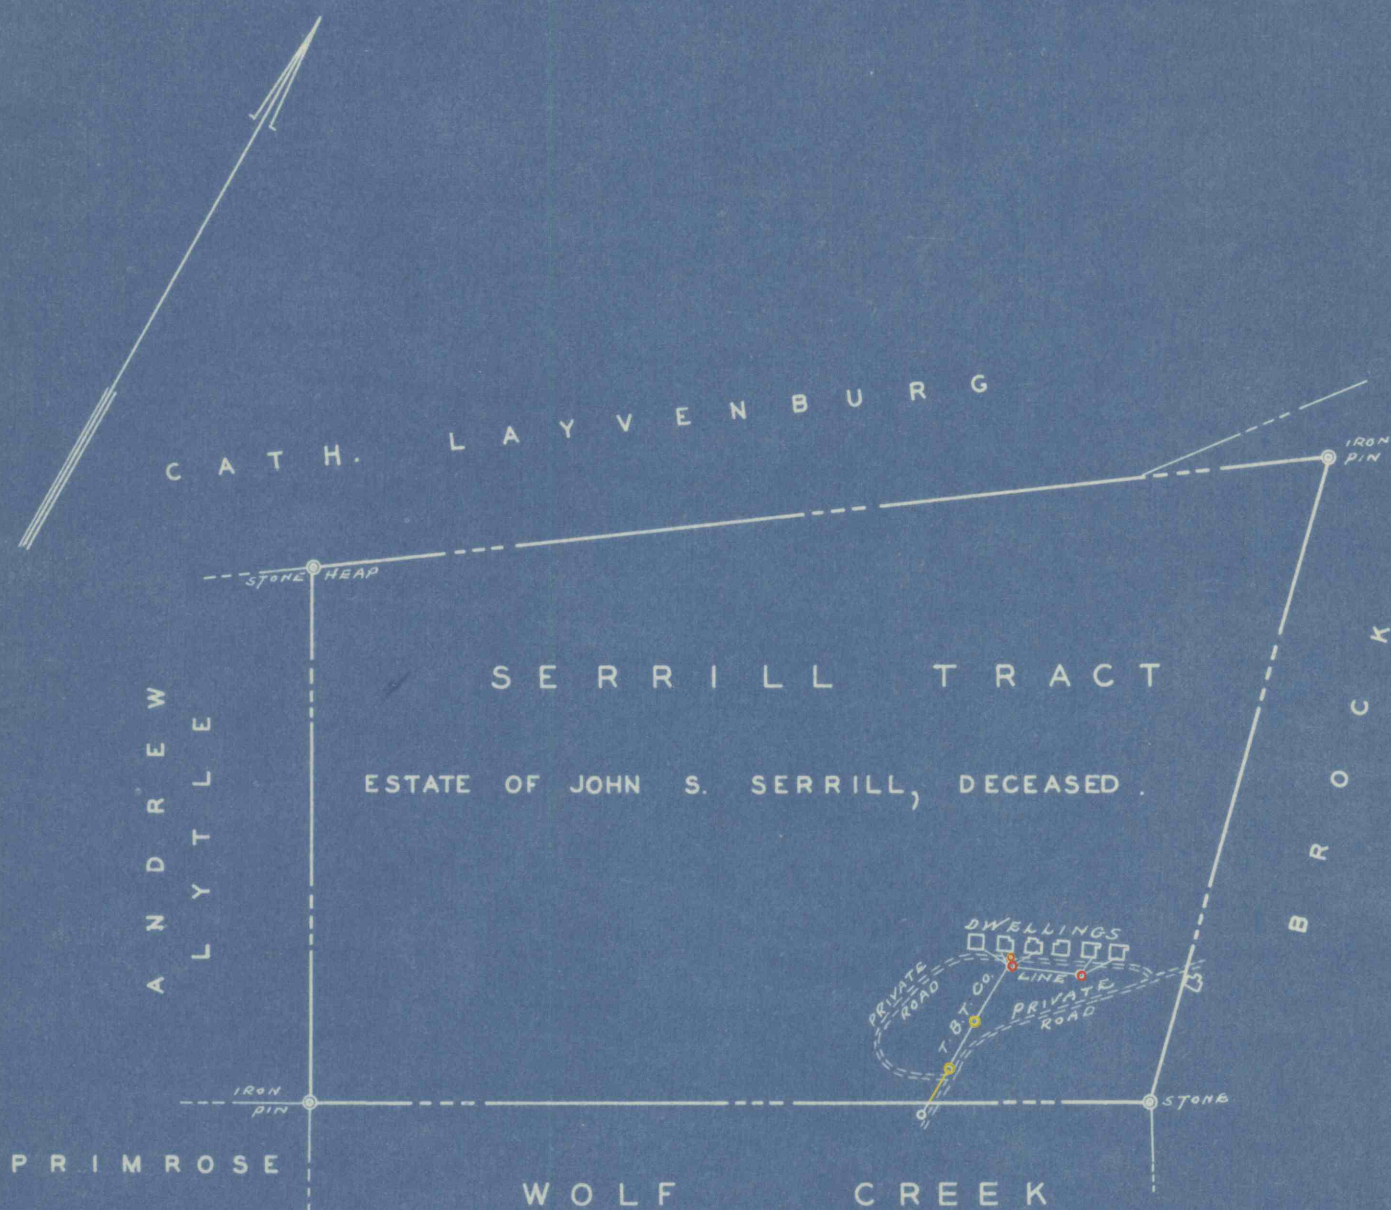

Sketch showing the location of:—  
**THE BELL TELEPHONE CO. LINES**  
 ON THE SERRILL TRACT  
 IN CASS TOWNSHIP, SCH.CO., PA.  
 As Described in the Accompanying Agreement  
 Dated [REDACTED]  
 BETWEEN  
 THE ESTATE OF JOHN S. SERRILL, Dec'd.  
 AND  
 THE BELL TELEPHONE CO. of PENN'A.

SCALE 1" = 400'

P.W. SHEAFER AGENCY  
 Pottsville, Pa.

YELLOW DENOTES T.B.T. Co. POLES & ANCHOR GUYS.  
 RED DENOTES POLES OF OTHER OWNERS CARRYING T.B.T. Co. WIRES.

F