


19
26 Poles
35 Anch
6 wire charges

5/16/35 Grant
Morgan & De Witt

25 Poles (red)
35 Anch. (3 and 4 1st stub pole)
60
6 wire charges

Grant to be made Oct. 15.

CATH. LAYVENBURG

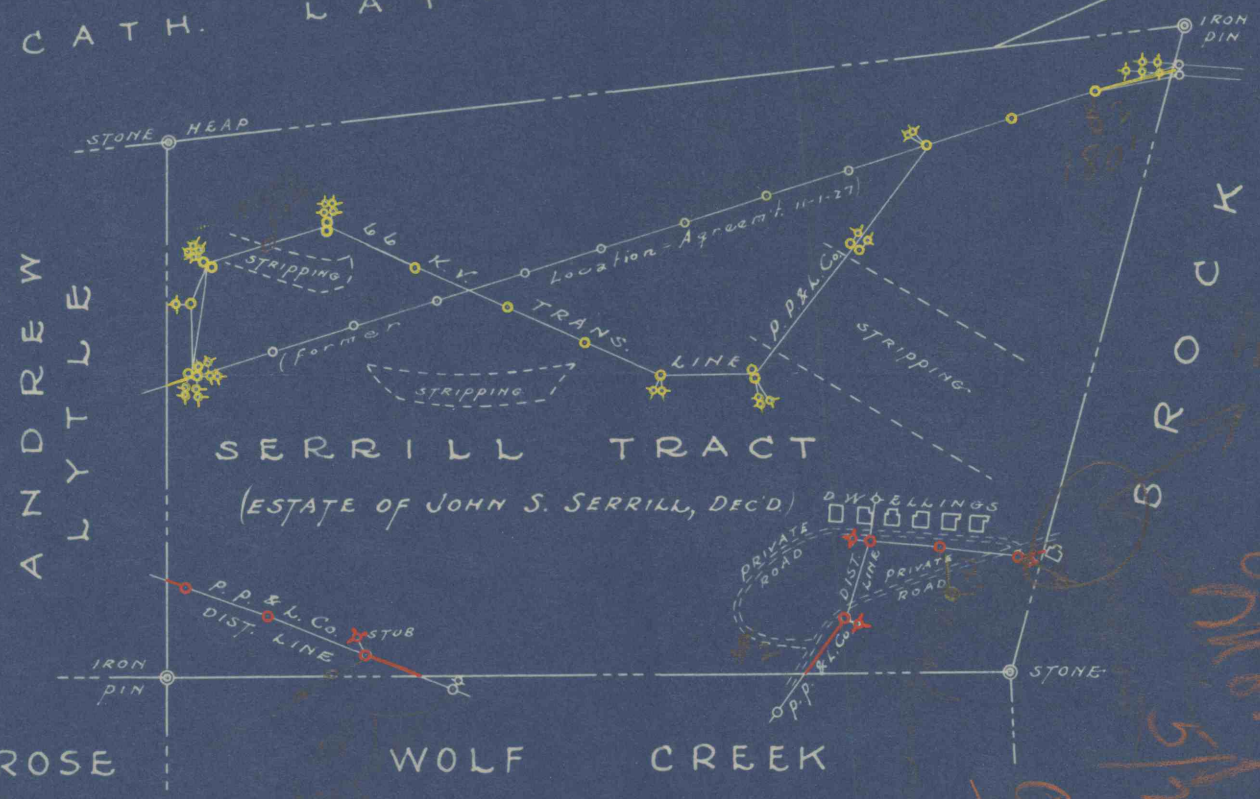

5/19/36

Sketch showing the location of:

26 Poles THE PENN'A. POWER & LIGHT COMPANY
35 Anch TRANSMISSION & DISTRIBUTION LINES
6 wire charges ACROSS THE SERRILL TRACT
#9 IN CASS TOWNSHIP, SCH. CO., PENN'A.

As Described in the Accompanying Agreement
DATED [redacted], Between

THE ESTATE OF JOHN S. SERRILL, DEC'D.

AND

THE PENN'A. POWER & LIGHT COMPANY.

p.w. Sheaffer Agency

Pottsville, Penn'a

NOTE:—

YELLOW DENOTES POLES & ANCHORS OF 66 K.V. TRANSMISSION LINE.
RED " " " " DISTRIBUTION SYSTEM.

OK.
5/10/40
5/21/41
5/12/41