


Count to be made Oct 15.

5/16/36 Count

26 Poles
35 Anchors (3 red & 1 stub-pole)
6 wire charges = \$9

Total = \$70

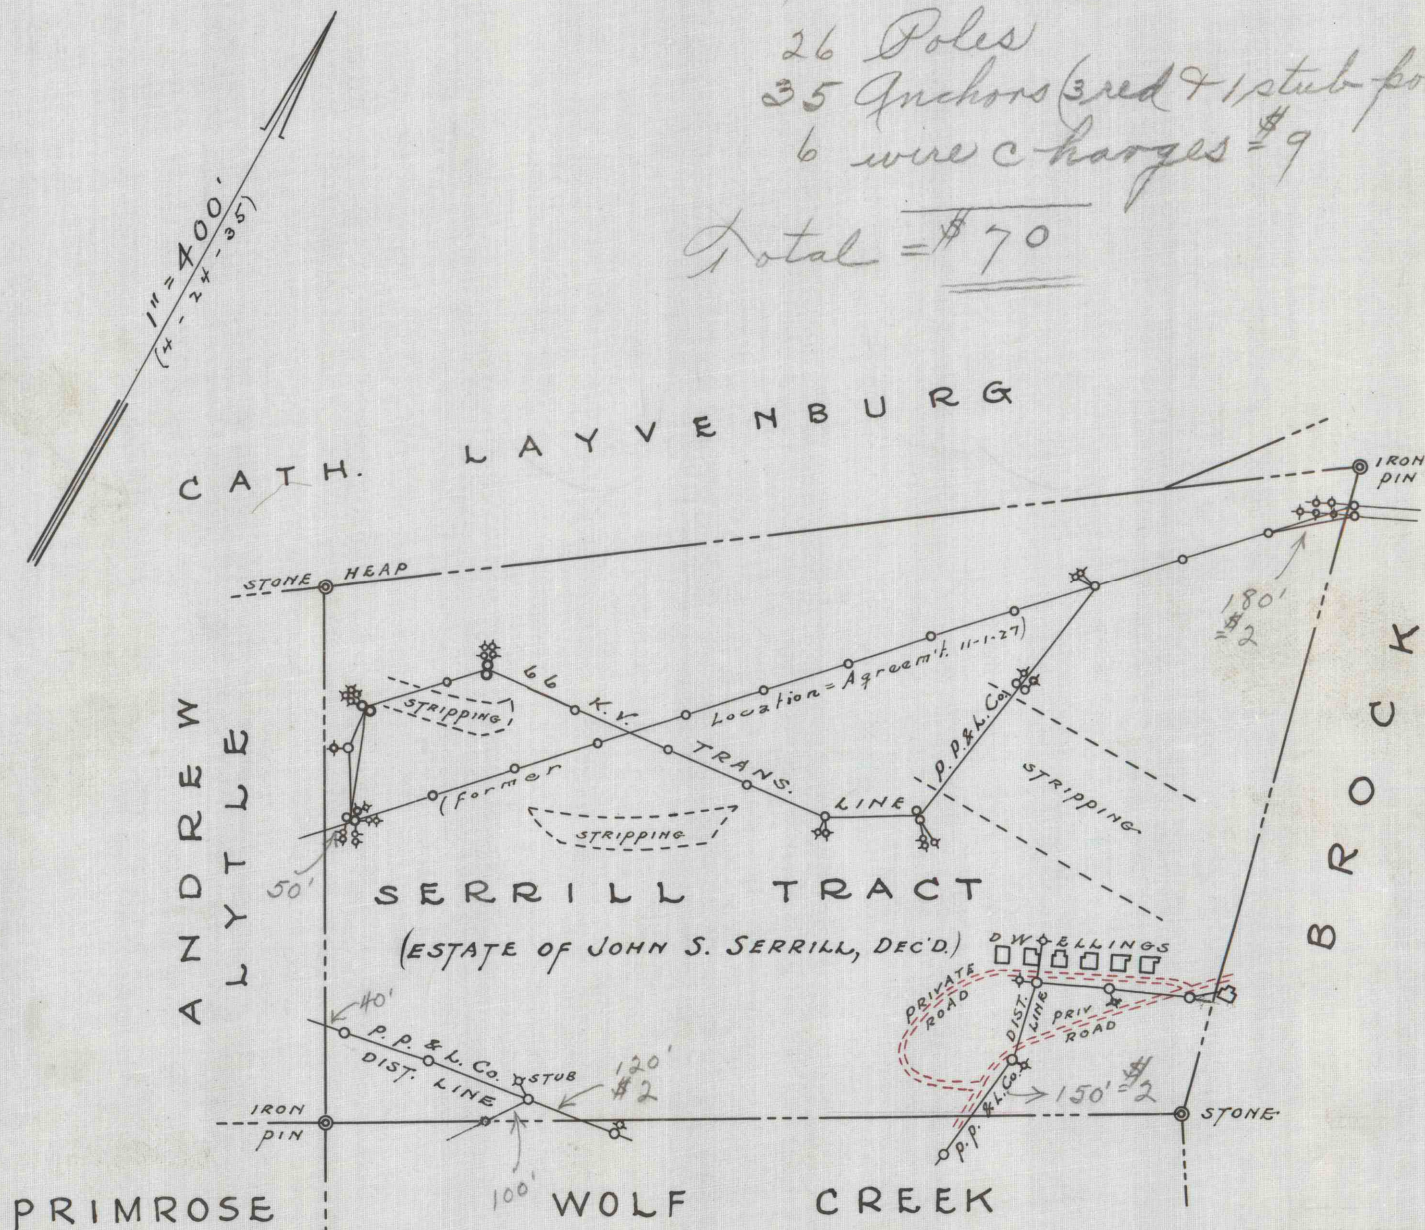

Sketch showing the location of:—
THE PENN'A. POWER & LIGHT COMPANY
TRANSMISSION & DISTRIBUTION LINES
ACROSS THE SERRILL TRACT
IN CASS TOWNSHIP, SCH. CO., PENN'A.
As Described in the Accompanying Agreement
DATED [REDACTED], Between
THE ESTATE OF JOHN S. SERRILL, DEC'D.
AND
THE PENN'A. POWER & LIGHT COMPANY.

p.w. sheaffer Agency

pottsville, Penn'a

NOTE:—

YELLOW DENOTES POLES & ANCHORS OF 66 K.V. TRANSMISSION LINE.
RED " " " " DISTRIBUTION SYSTEM.