


LAYVENBURG TRACT

BROCK TRACT

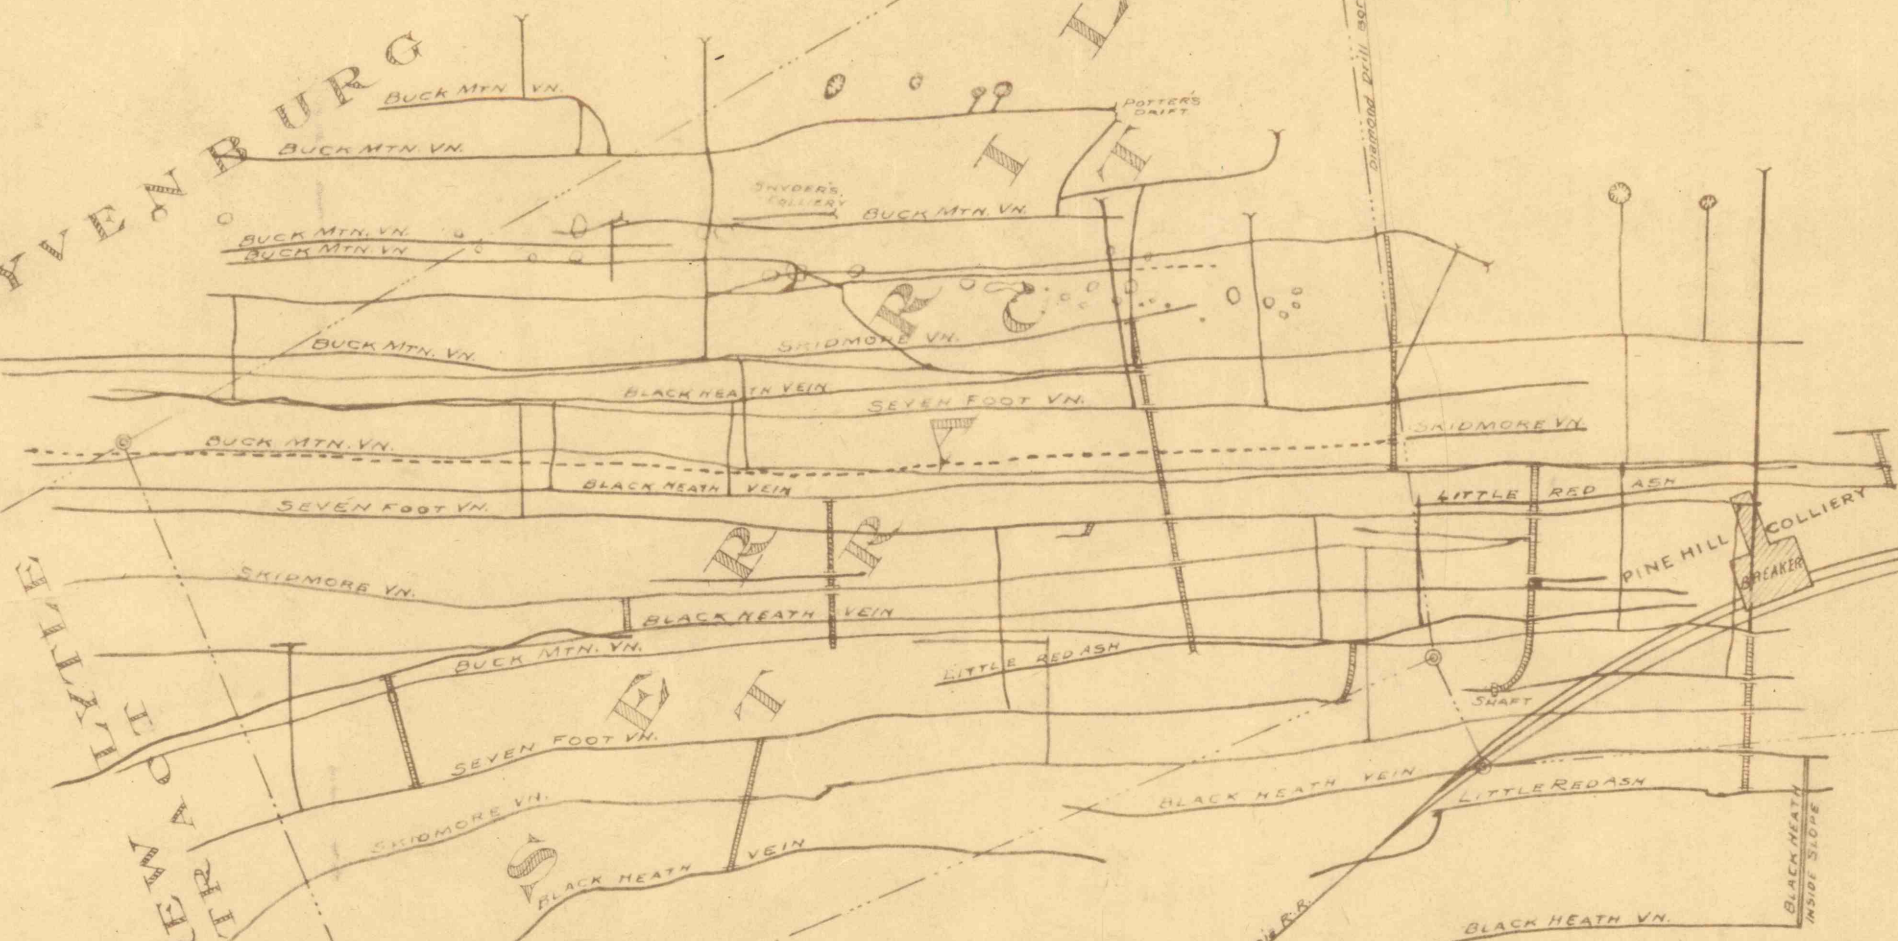

LITTLE ANDERSON

WOLF CREEK TRACT

PRIMROSE

MAP OF
SERPILL TRACT
SHOWING MINE WORKINGS
OF PINE HILL COLLIERY

Scale - One Inch = 300 Feet

Estate of P.W. Sheaffer Decd - Pottsville Pa.