


LAYNE & BURG TRACT

BROCK TRACT

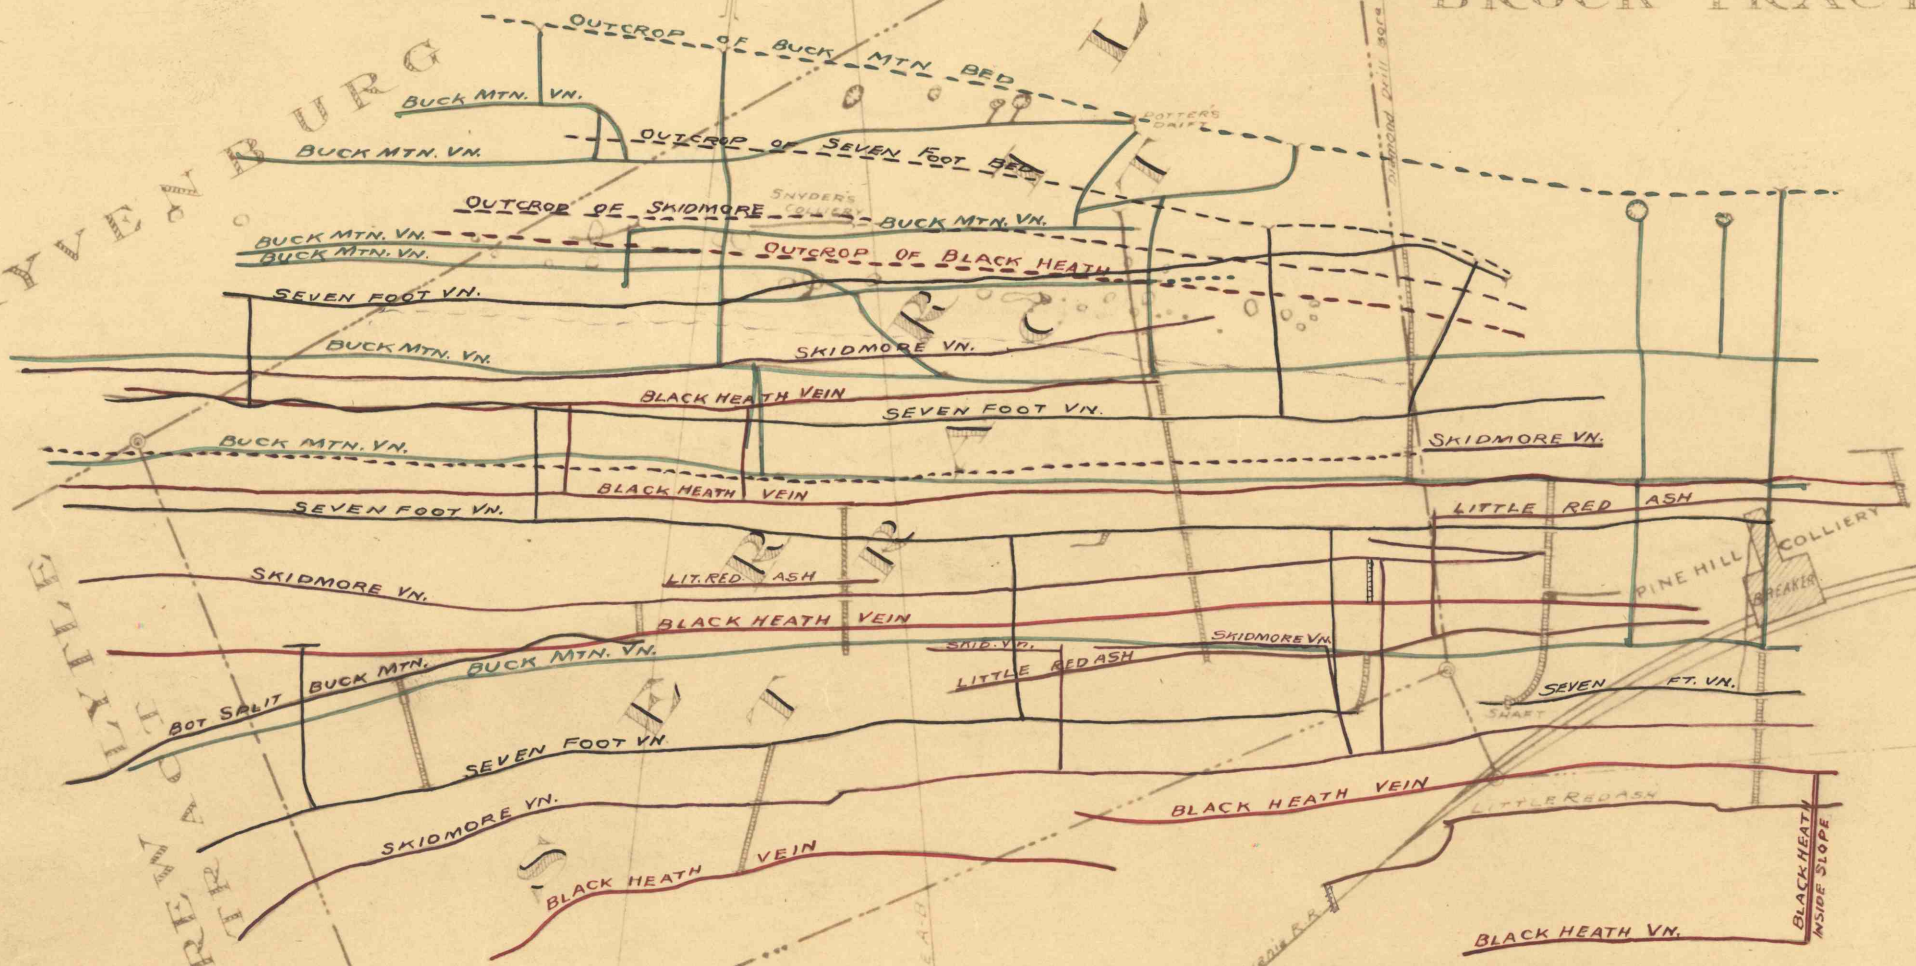

PRIMROSE

WOLF CREEK TRACT

MAP OF
SERRILL TRACT
SHOWING MINE WORKINGS
OF PINE HILL COLLIERY

Scale - One Inch = 300 Feet

Estate of P.W. Sheaffer Decd - Pottsville Pa.
Feb. 5th 1914