


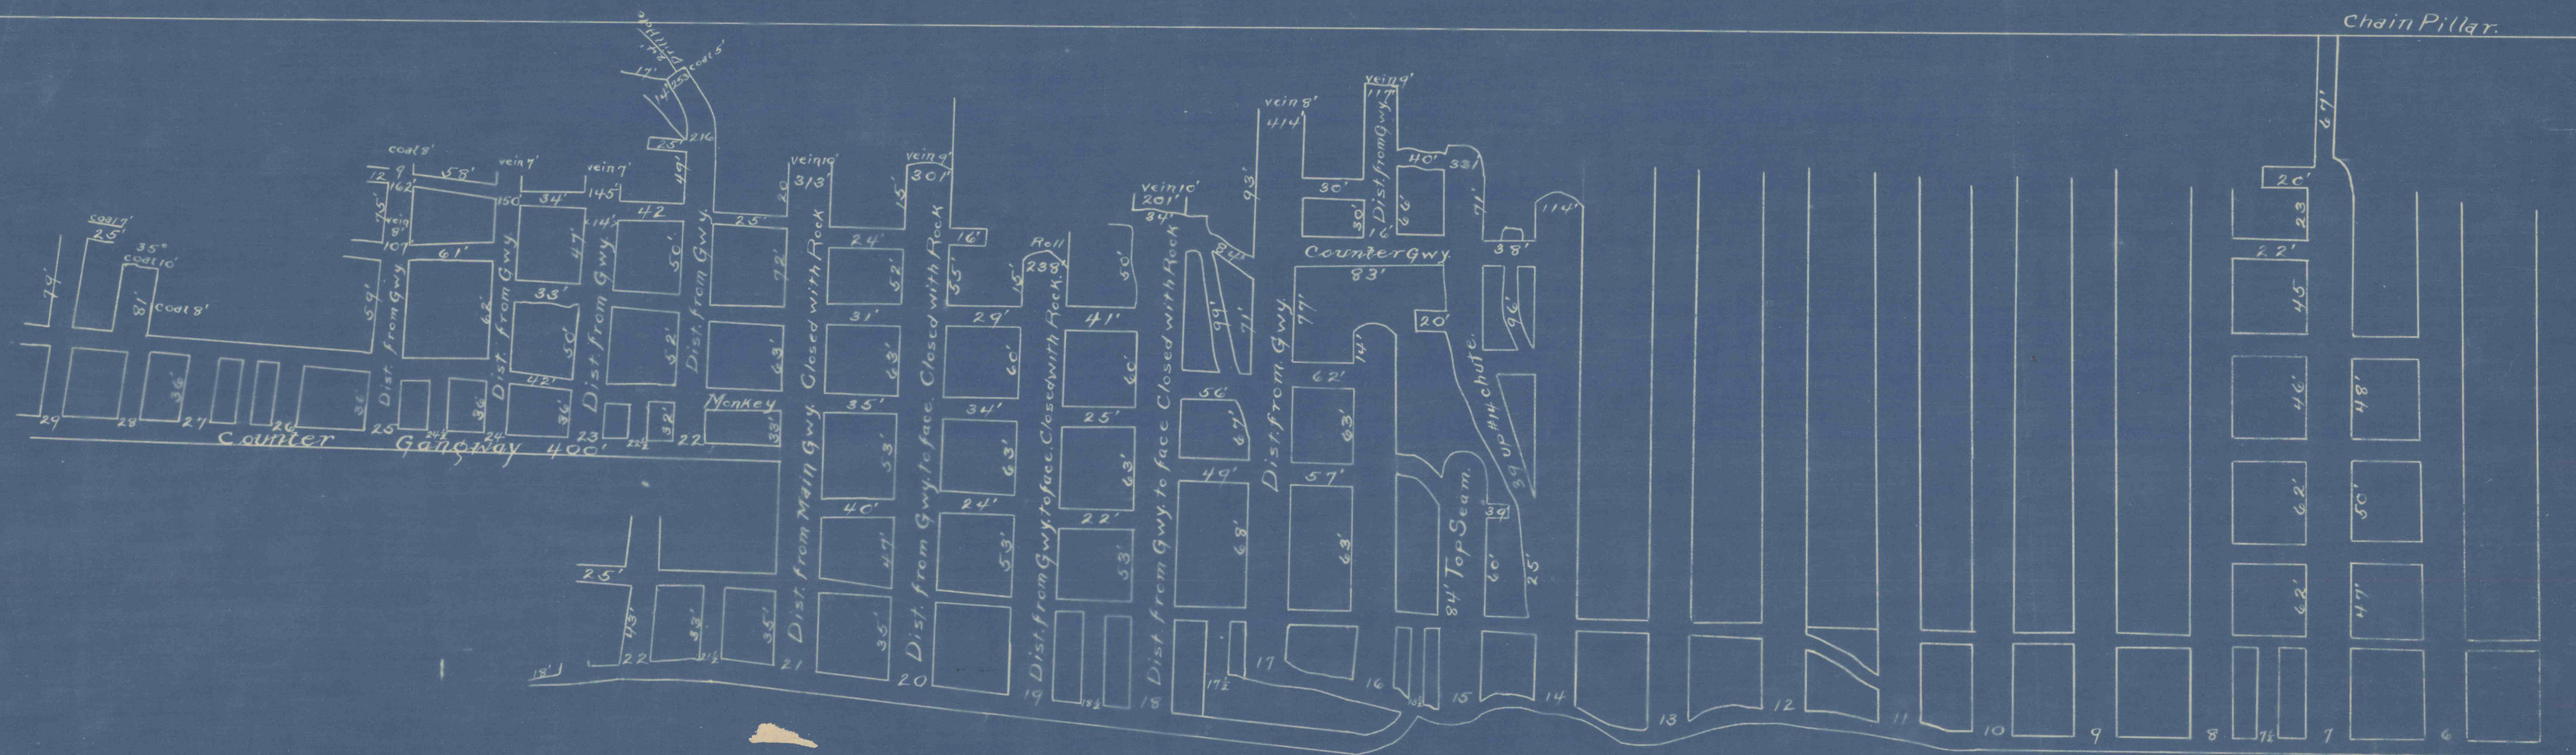

COPY of  
 ROBERT MILLER'S SKETCH  
 of  
 4TH LIFT WEST BLACK HEATH  
 PINE HILL COLLIERY

Scale =  
 JANUARY, 1918

Est. of P.W. Sheaffer, dec'd  
 POTTSVILLE, PENNA.