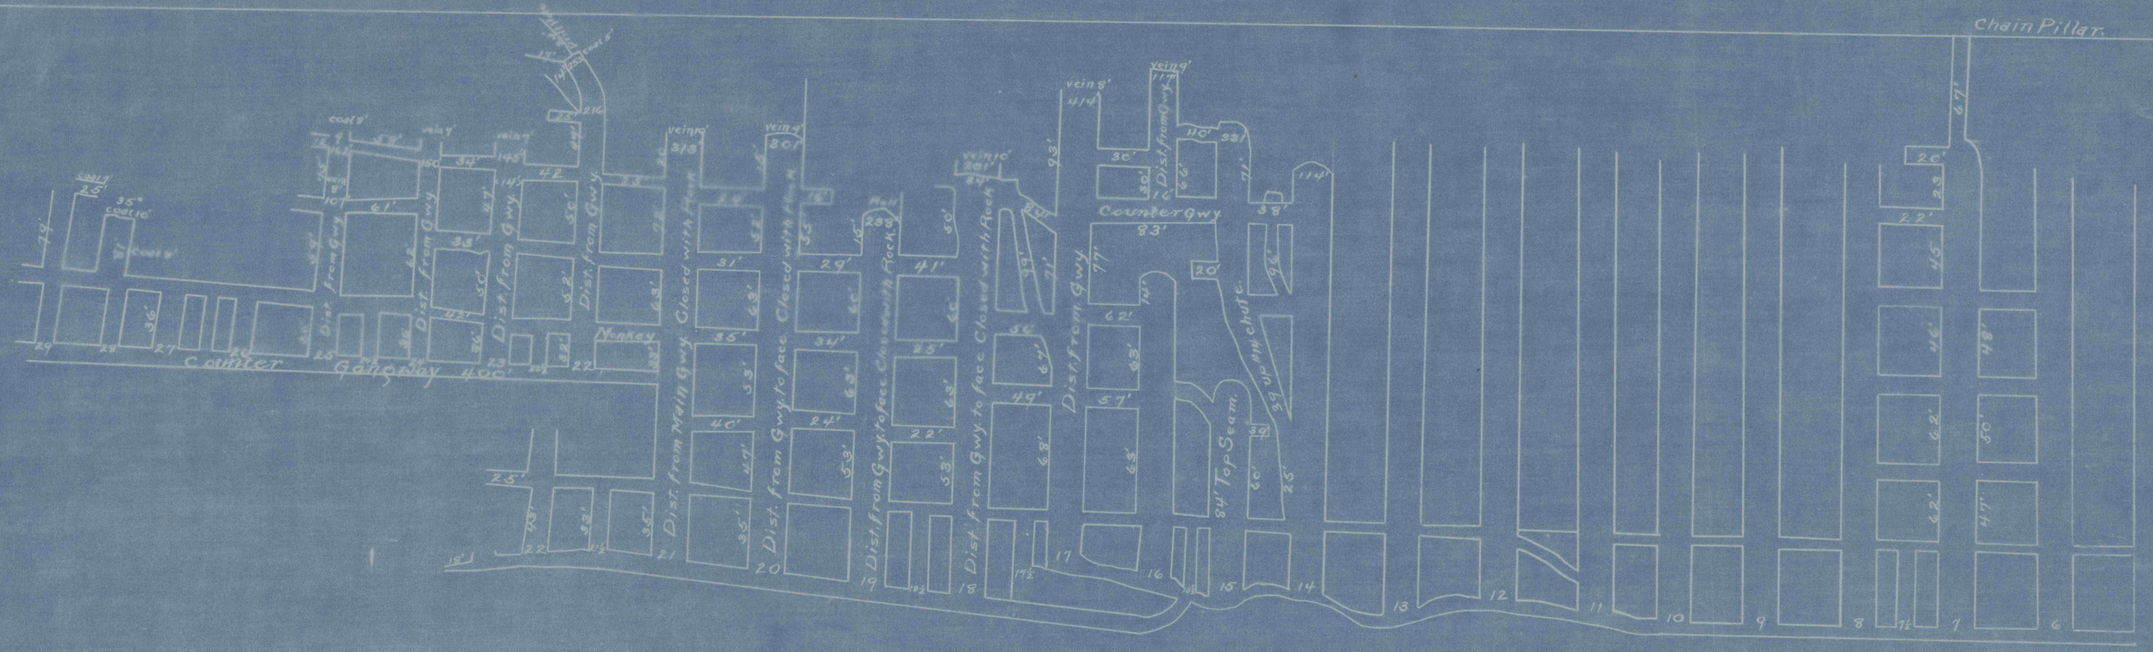
Chain Pillar.
Counter Gangway 400'
Dist. from Gwy.
Dist. from Main Gwy. Closed with Flume
Dist. from Gwy. to face. Closed with Flume
Dist. from Gwy. to face. Closed with Pack.
Dist. from Gwy. to face. Closed with Pack.
Dist. from Gwy.
Counter Gwy.
83'
Dist. from Gwy.
Dist. from Gwy.
Nunley
8th Top Seam.
Up my chute.
veins'
coals'
35" coal 16'
coal 8'
coal 9'
coal 8'
coal 8'
coal 8