


Existing Line Shown Thus —

Portion To Be Removed Shown Thus —

New Location Shown Thus —

Scale 1"=100'

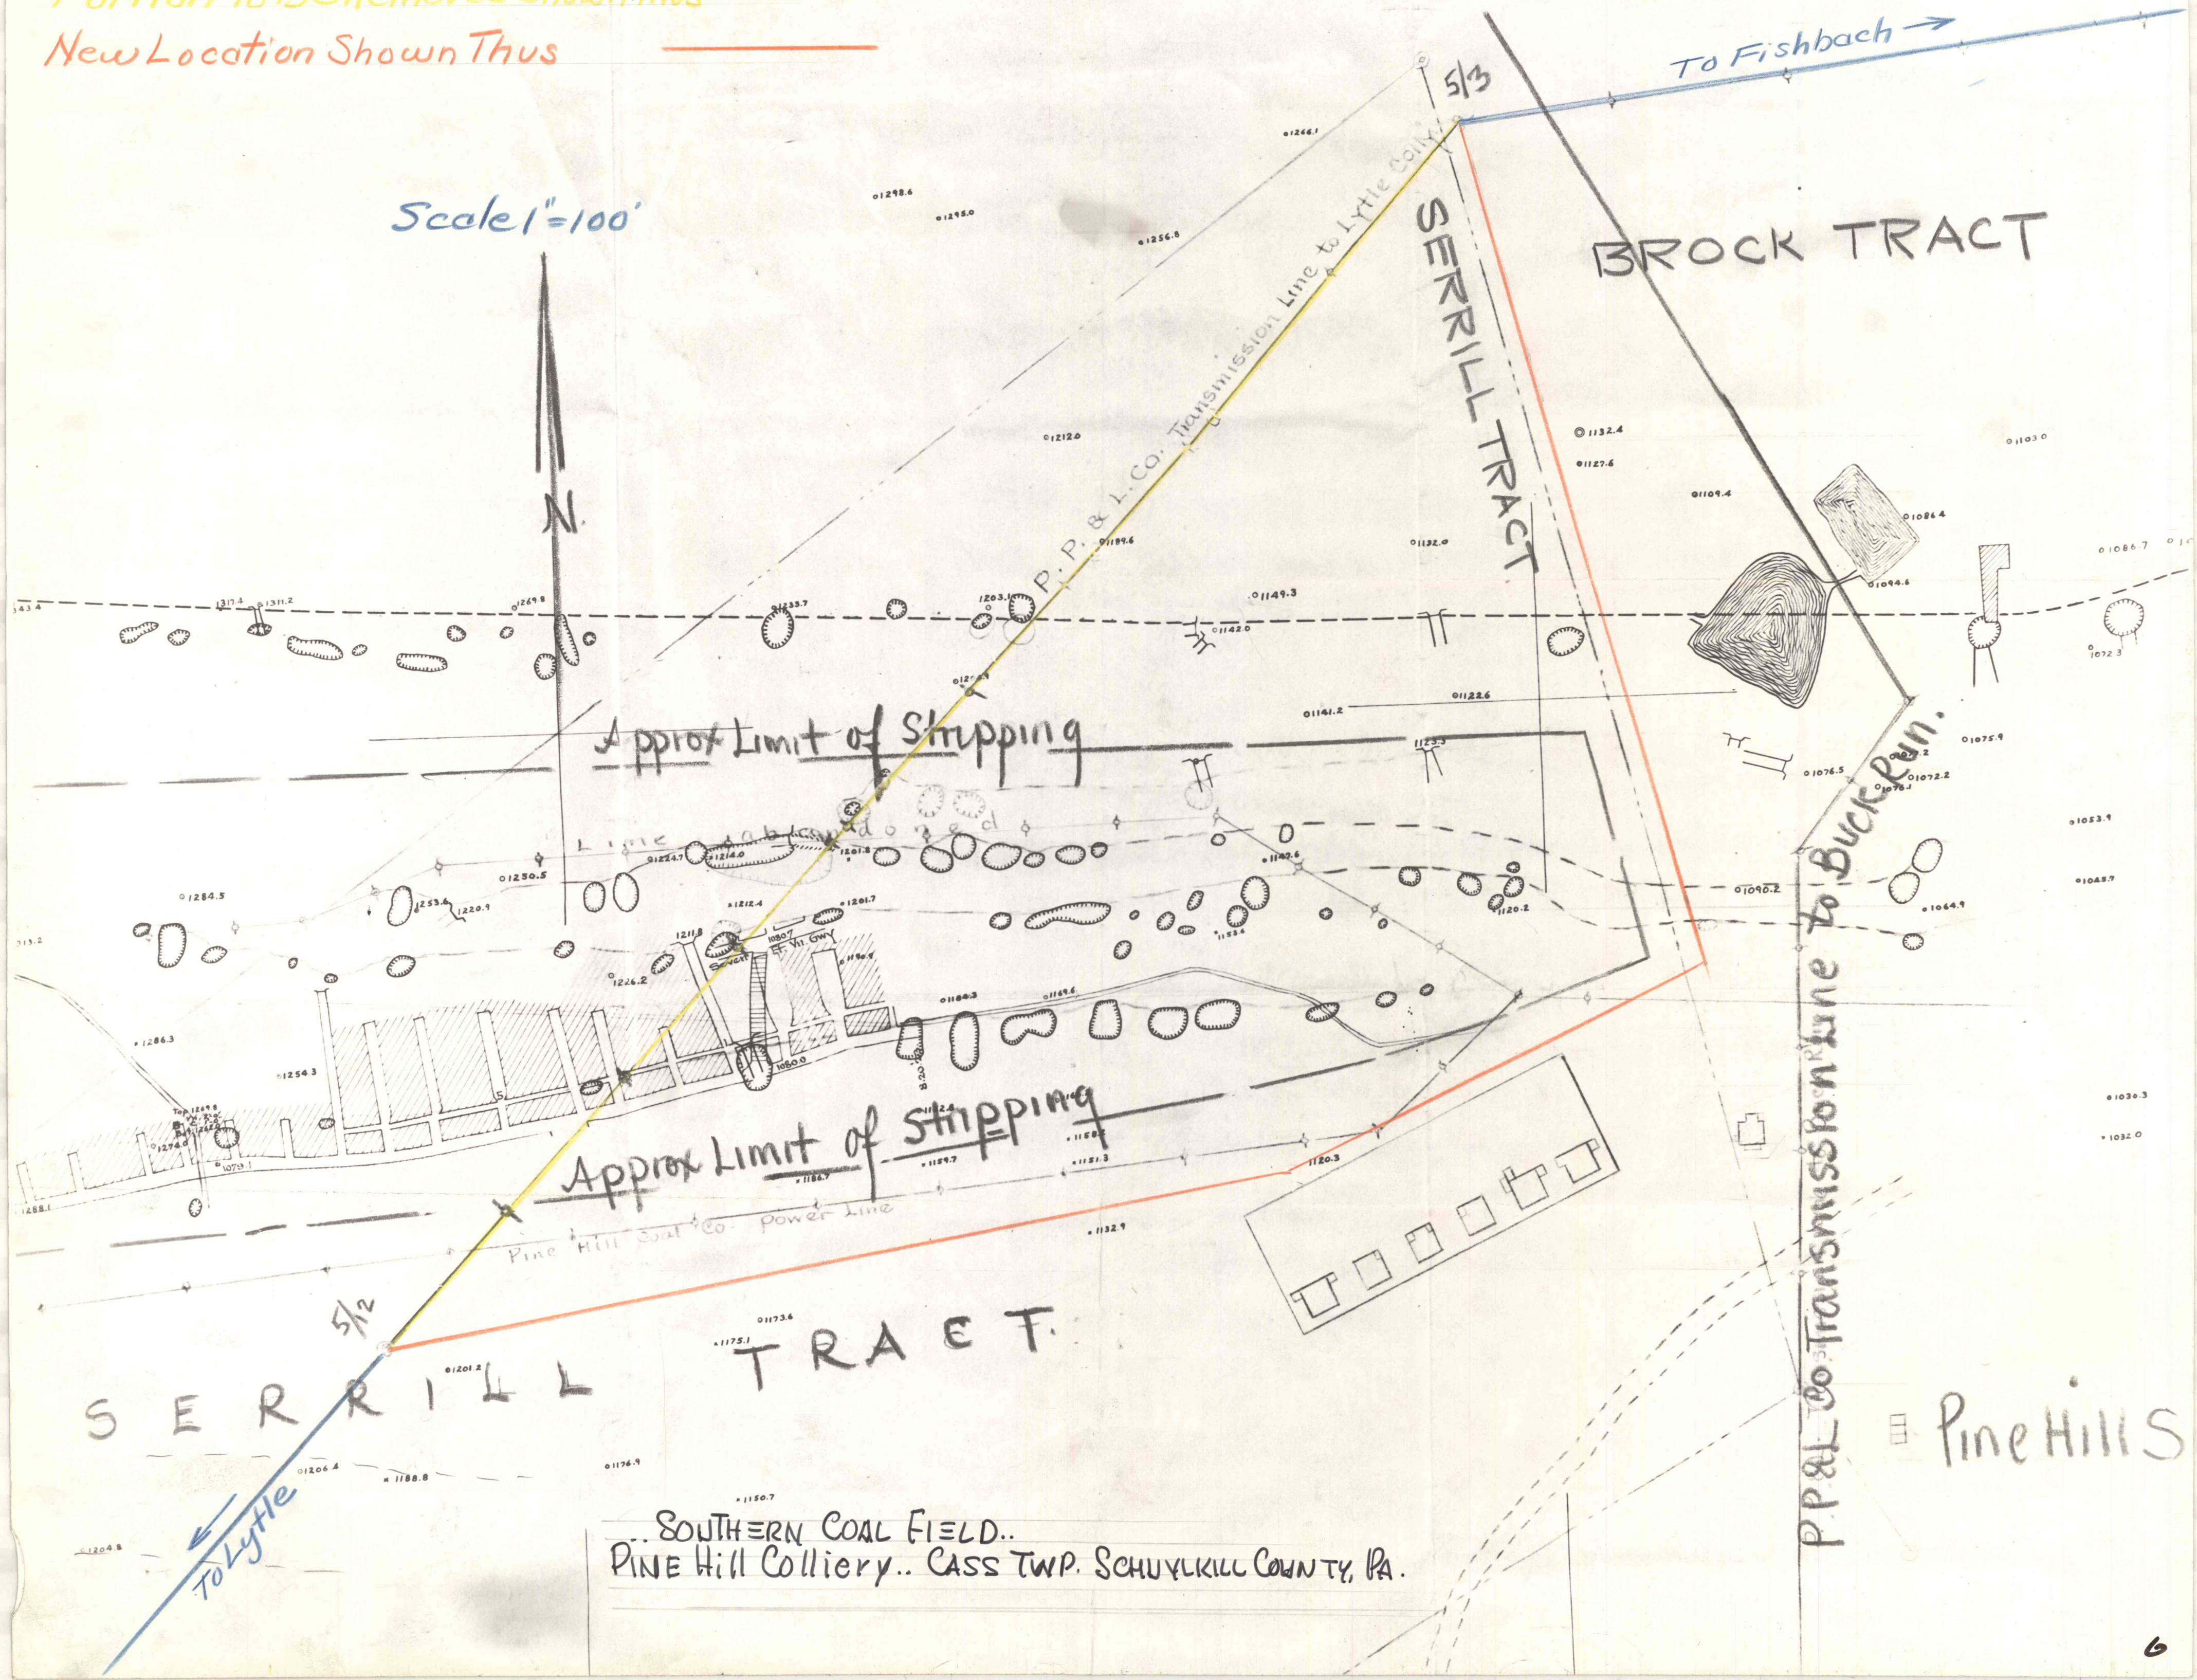

SOUTHERN COAL FIELD..
PINE Hill Colliery.. CASS TWP. SCHUYLKILL COUNTY, PA.