


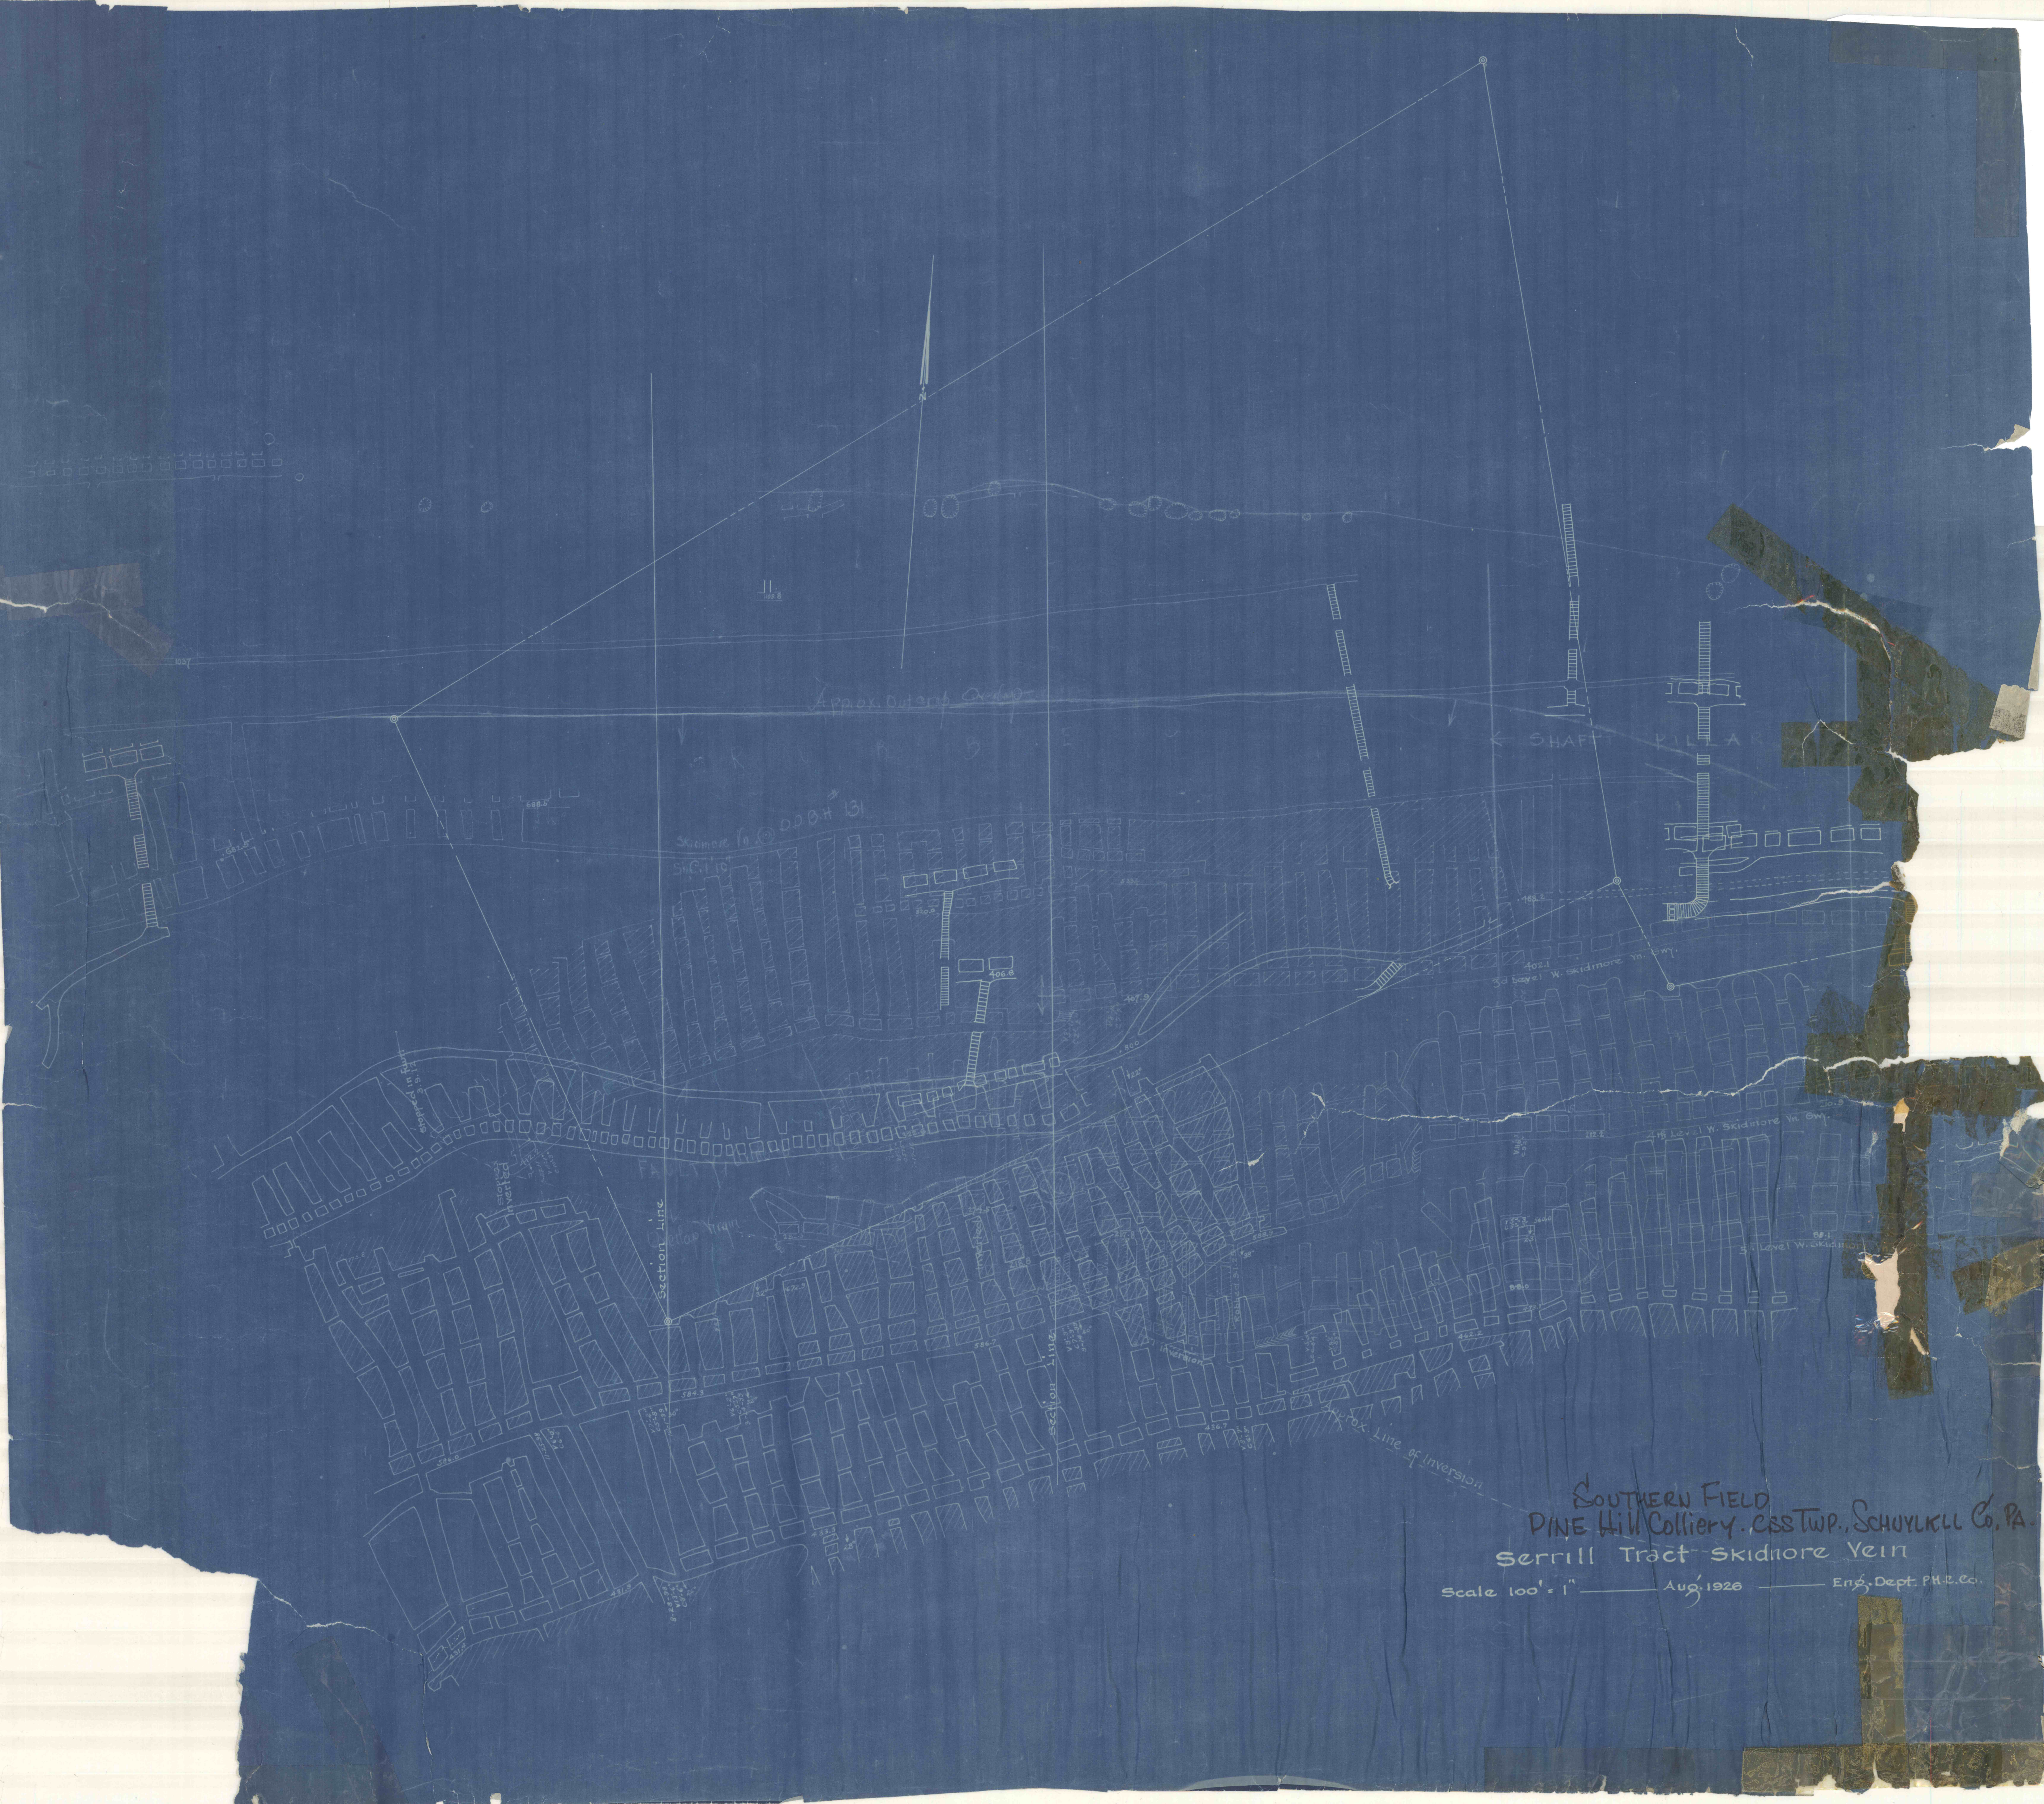

SOUTHERN FIELD
PINE HILL Colliery, CSS TWP., SCHUYLKILL CO., PA.
Serrill Tract Skidmore Vein

Scale 100' = 1" Aug. 1926 Eng. Dept. PH. & CO.