


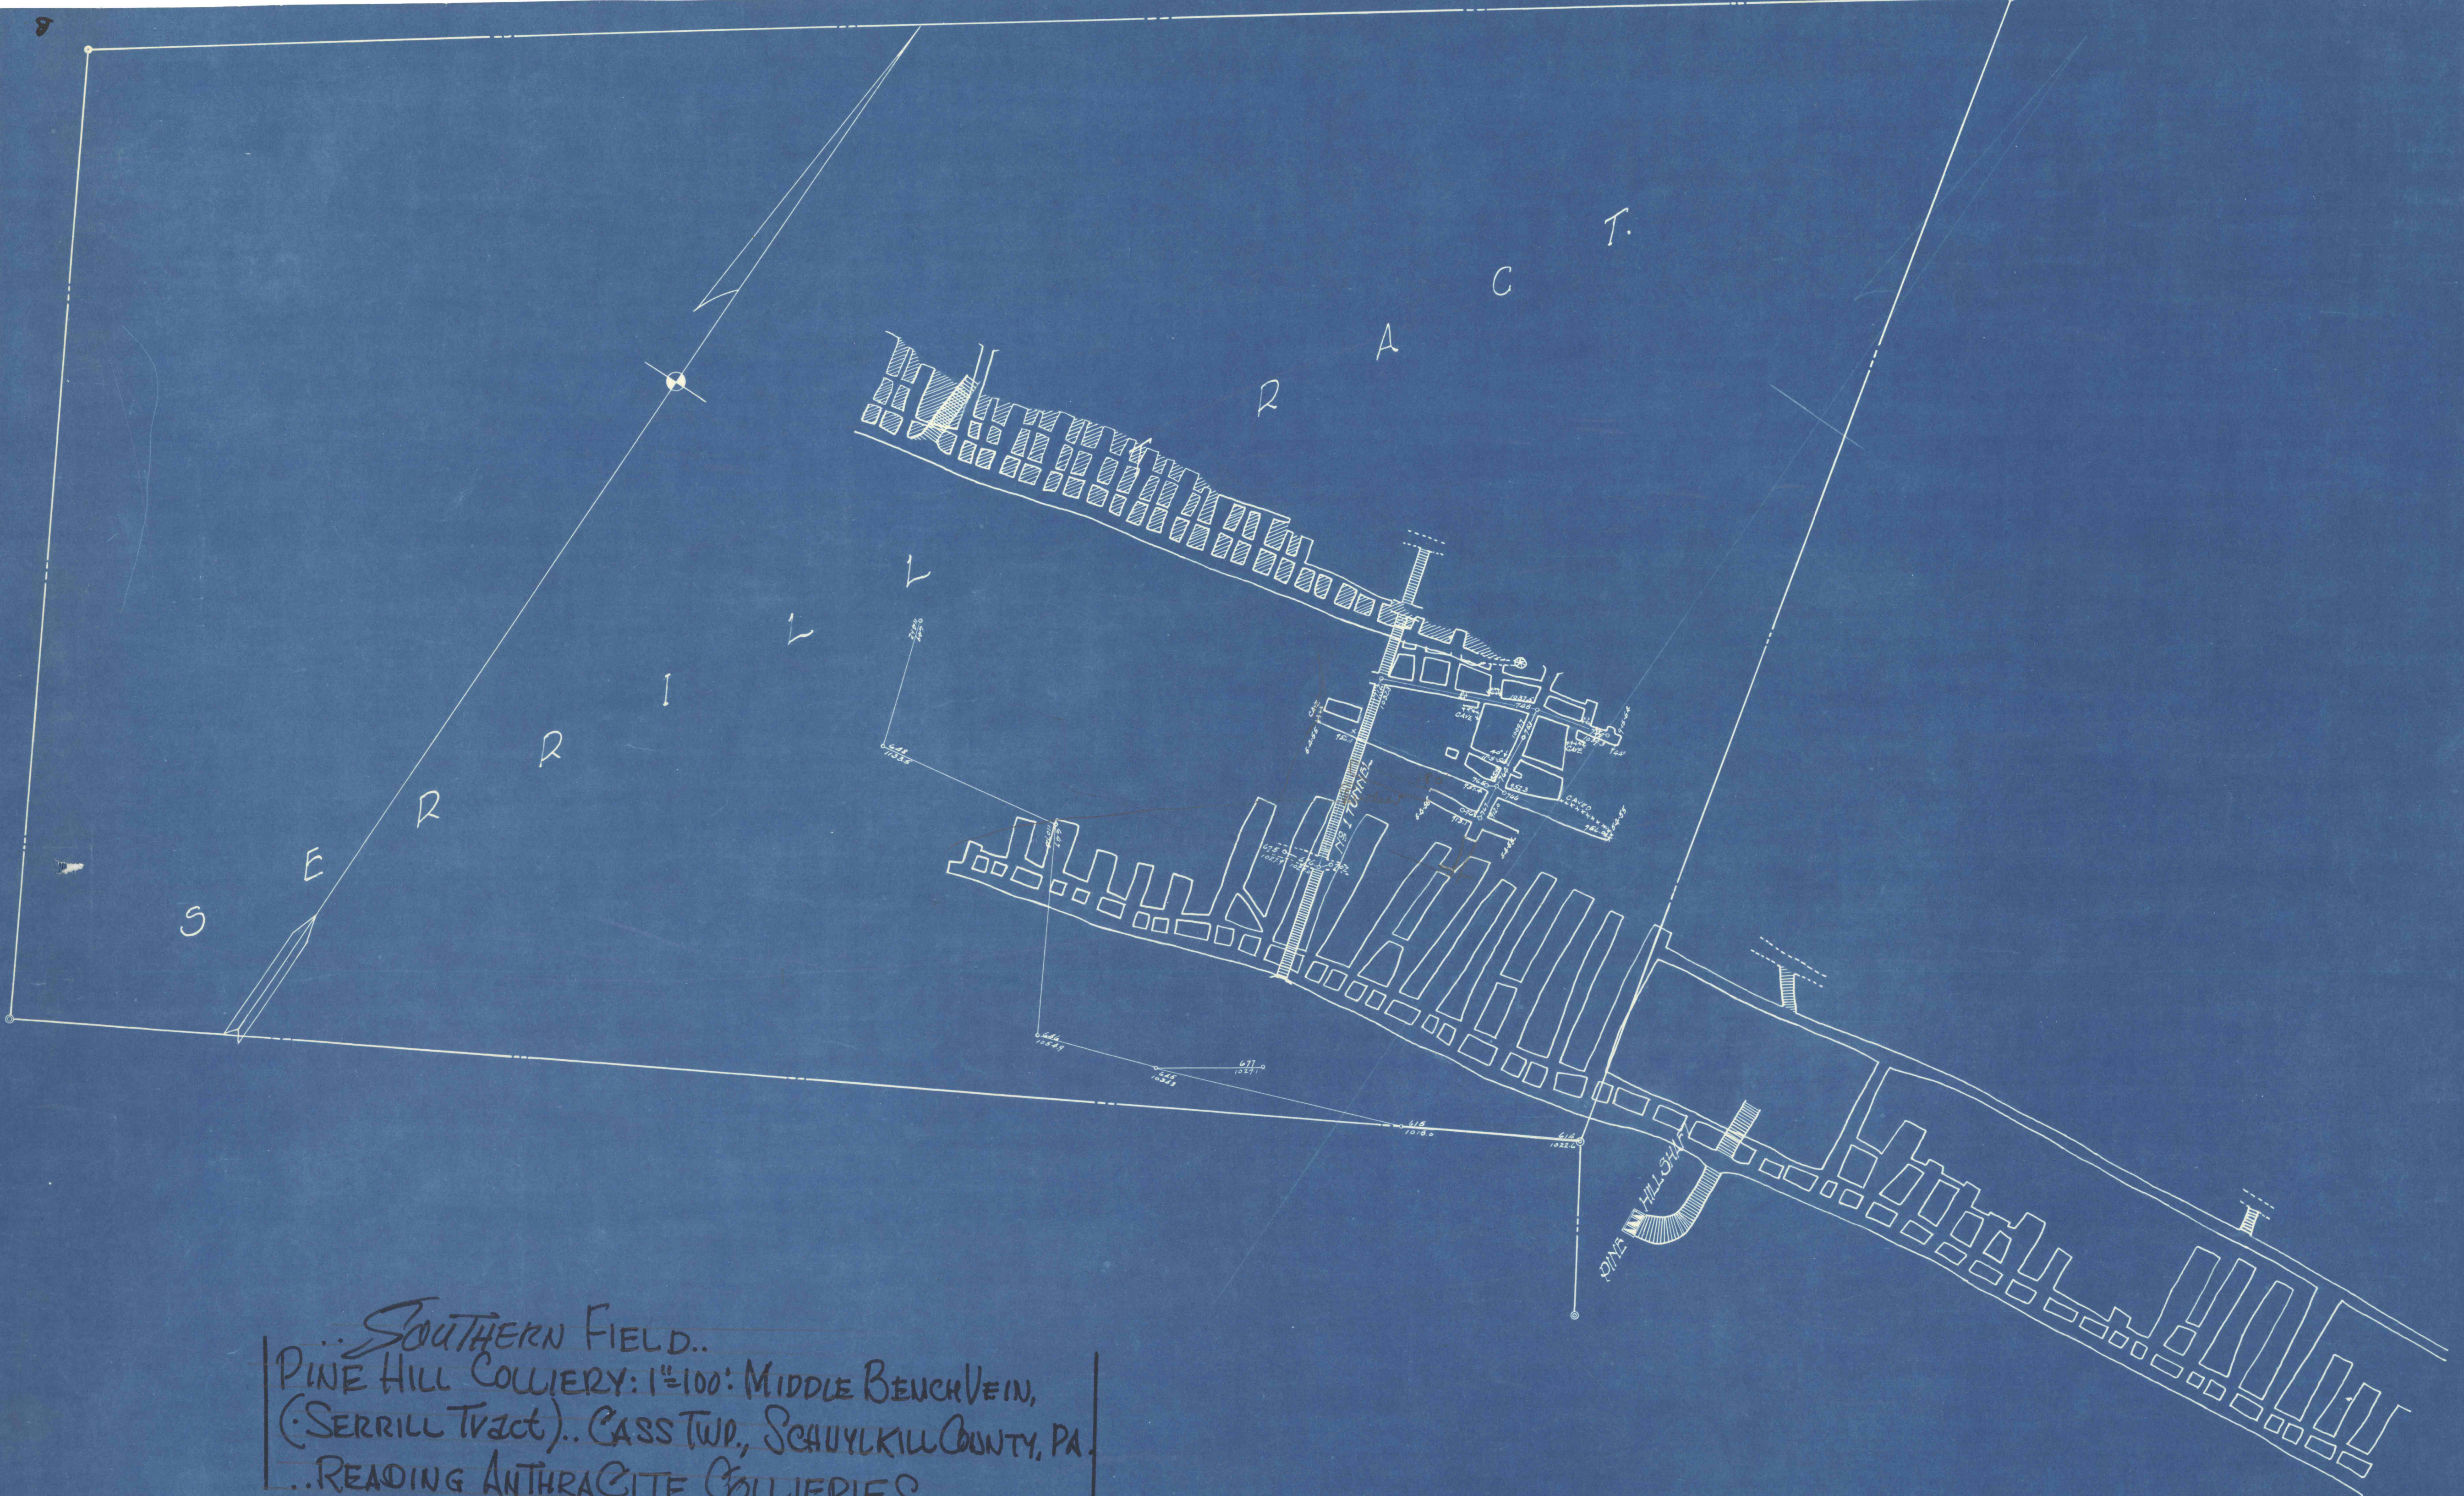

SOUTHERN FIELD..
 PINE HILL COLLIERY: 1"=100': MIDDLE BENCH VEIN,
 (SERRILL TRACT).. CASS TWP., SCHUYLKILL COUNTY, PA.
 ..READING ANTHRACITE COLLIERIES..
 .. 2 OF 2 = PRNTS:

SERRILL TRACT
 MIDDLE BENCH VEIN
 10-26-54 1"=100'