


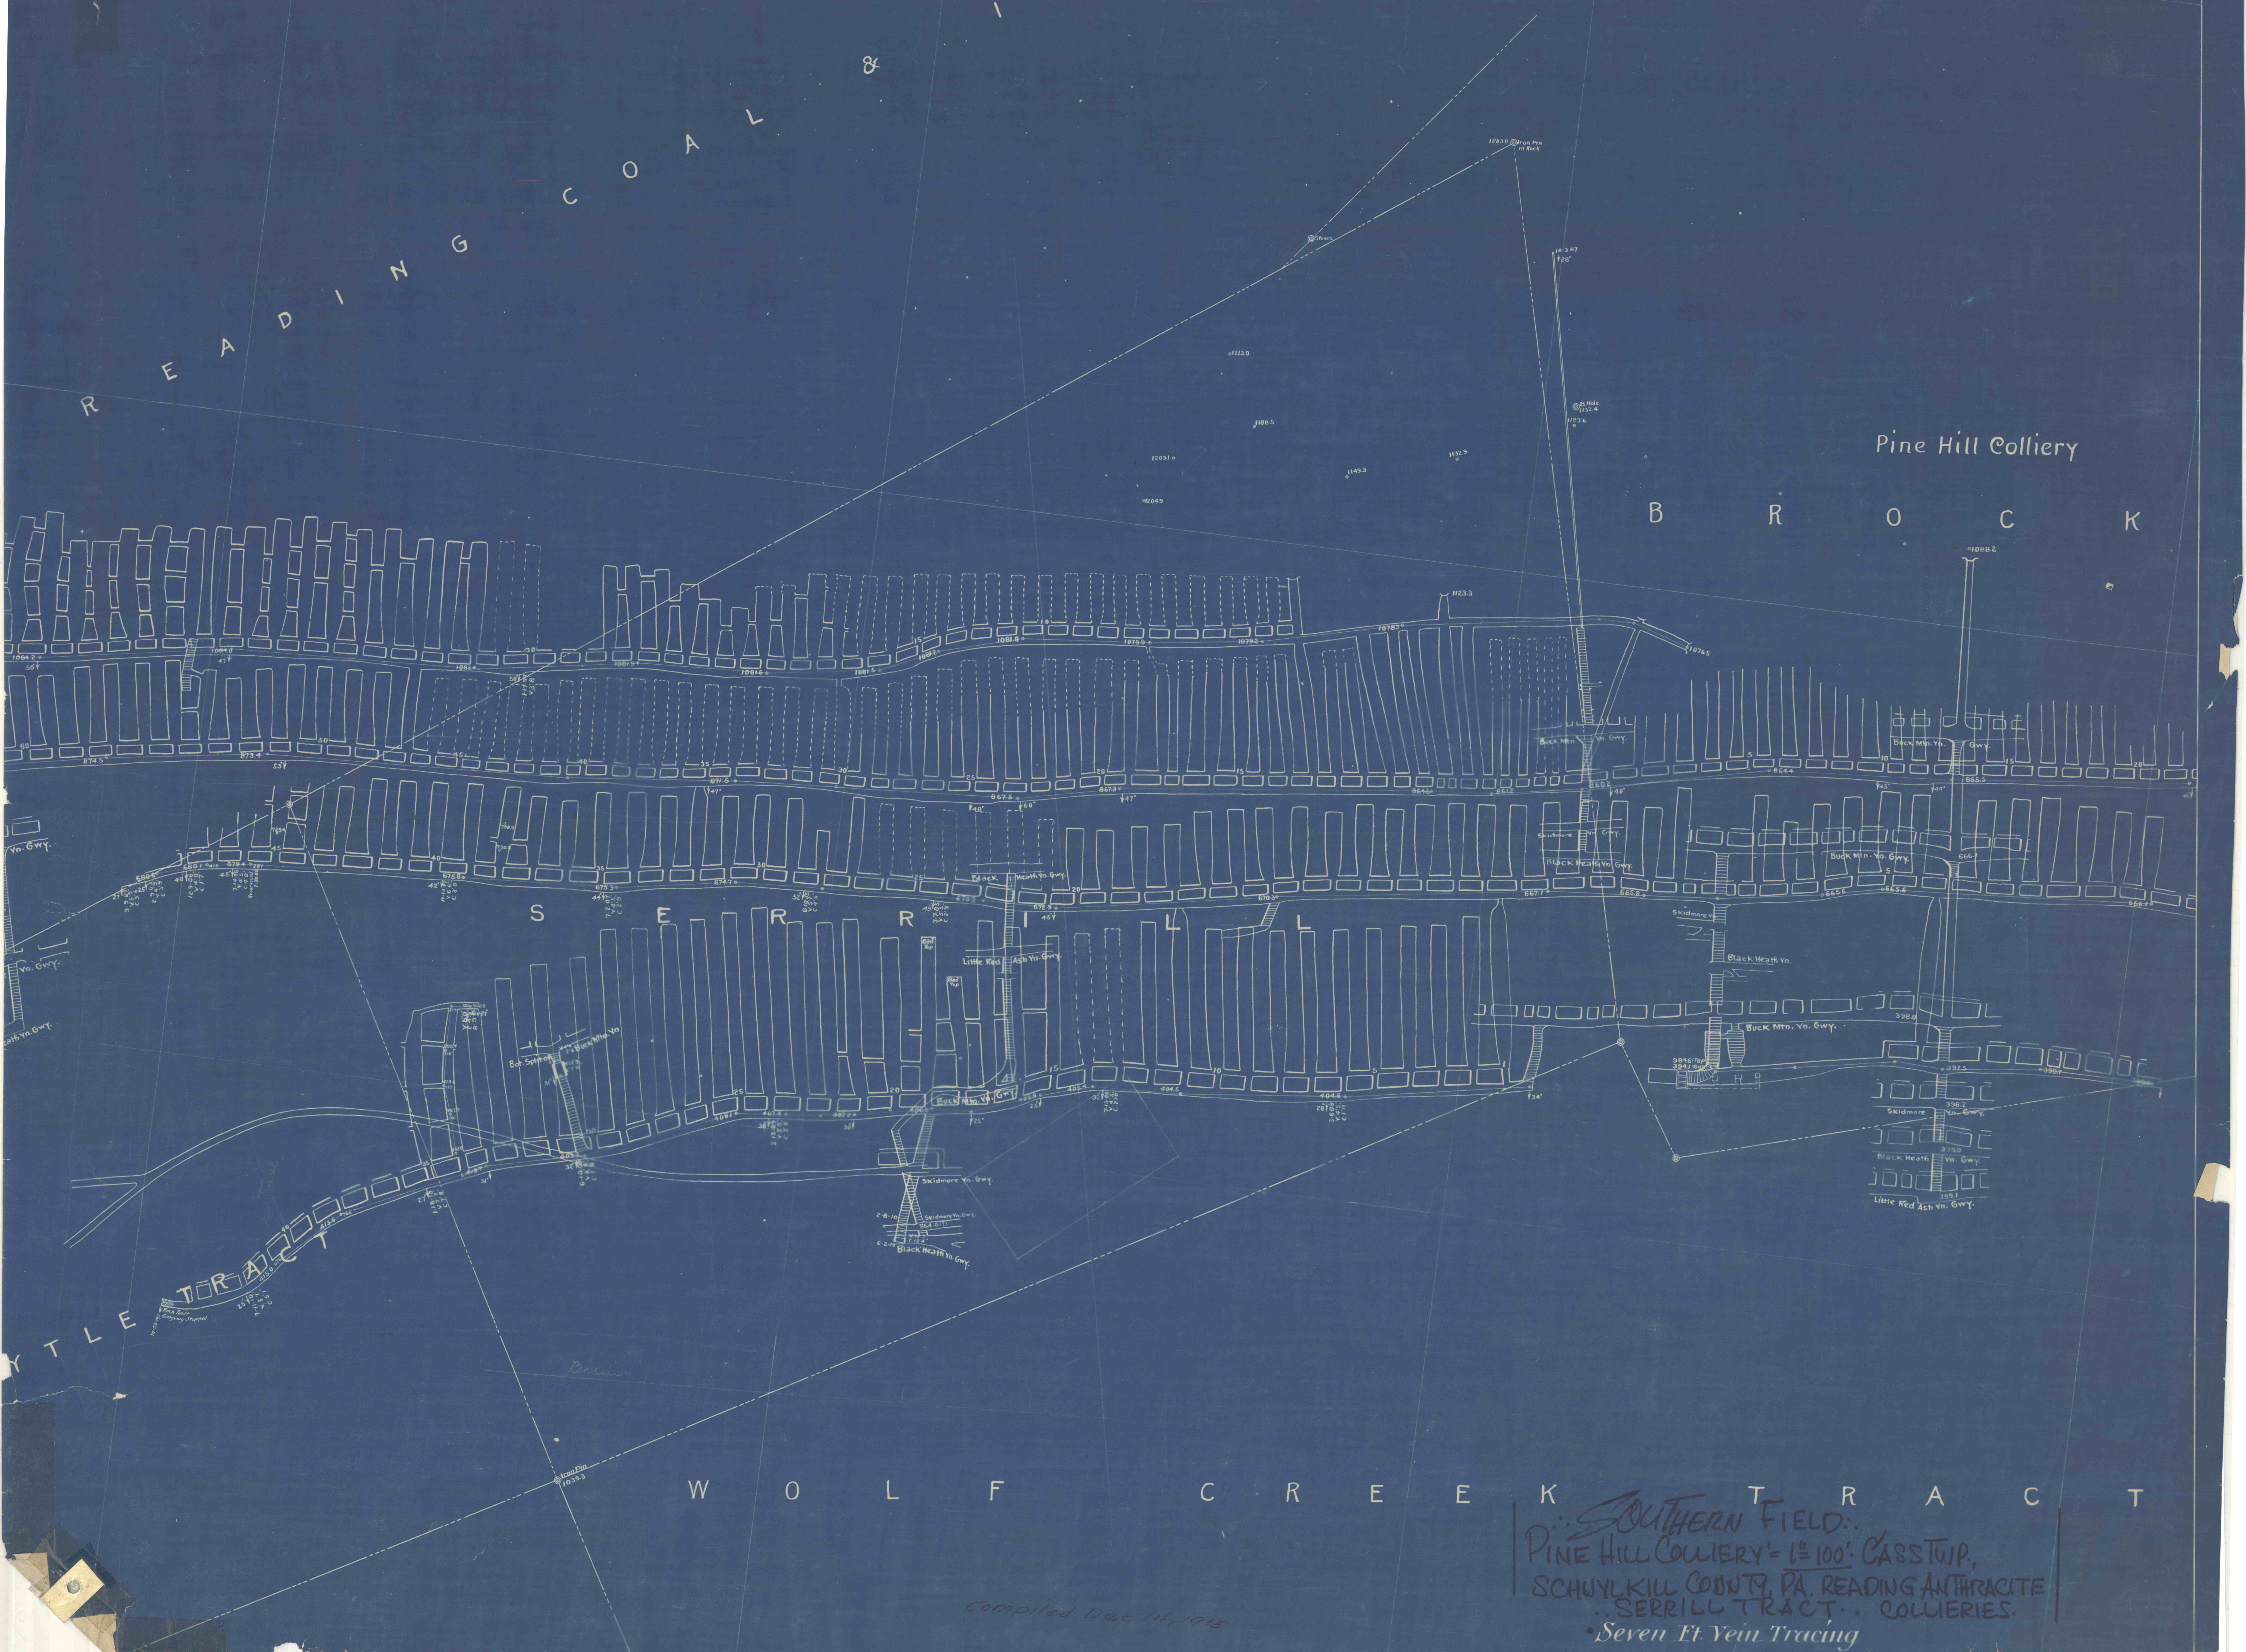

SOUTHERN FIELD:
PINE HILL COLLIERY - 1st 100' CASSTWP.
SCHUYLKILL COUNTY, PA. READING ANTHRACITE
SERRILL TRACT - COLLIERIES.
Seven Ft Vein Tracing

Compiled Dec 14, 1915