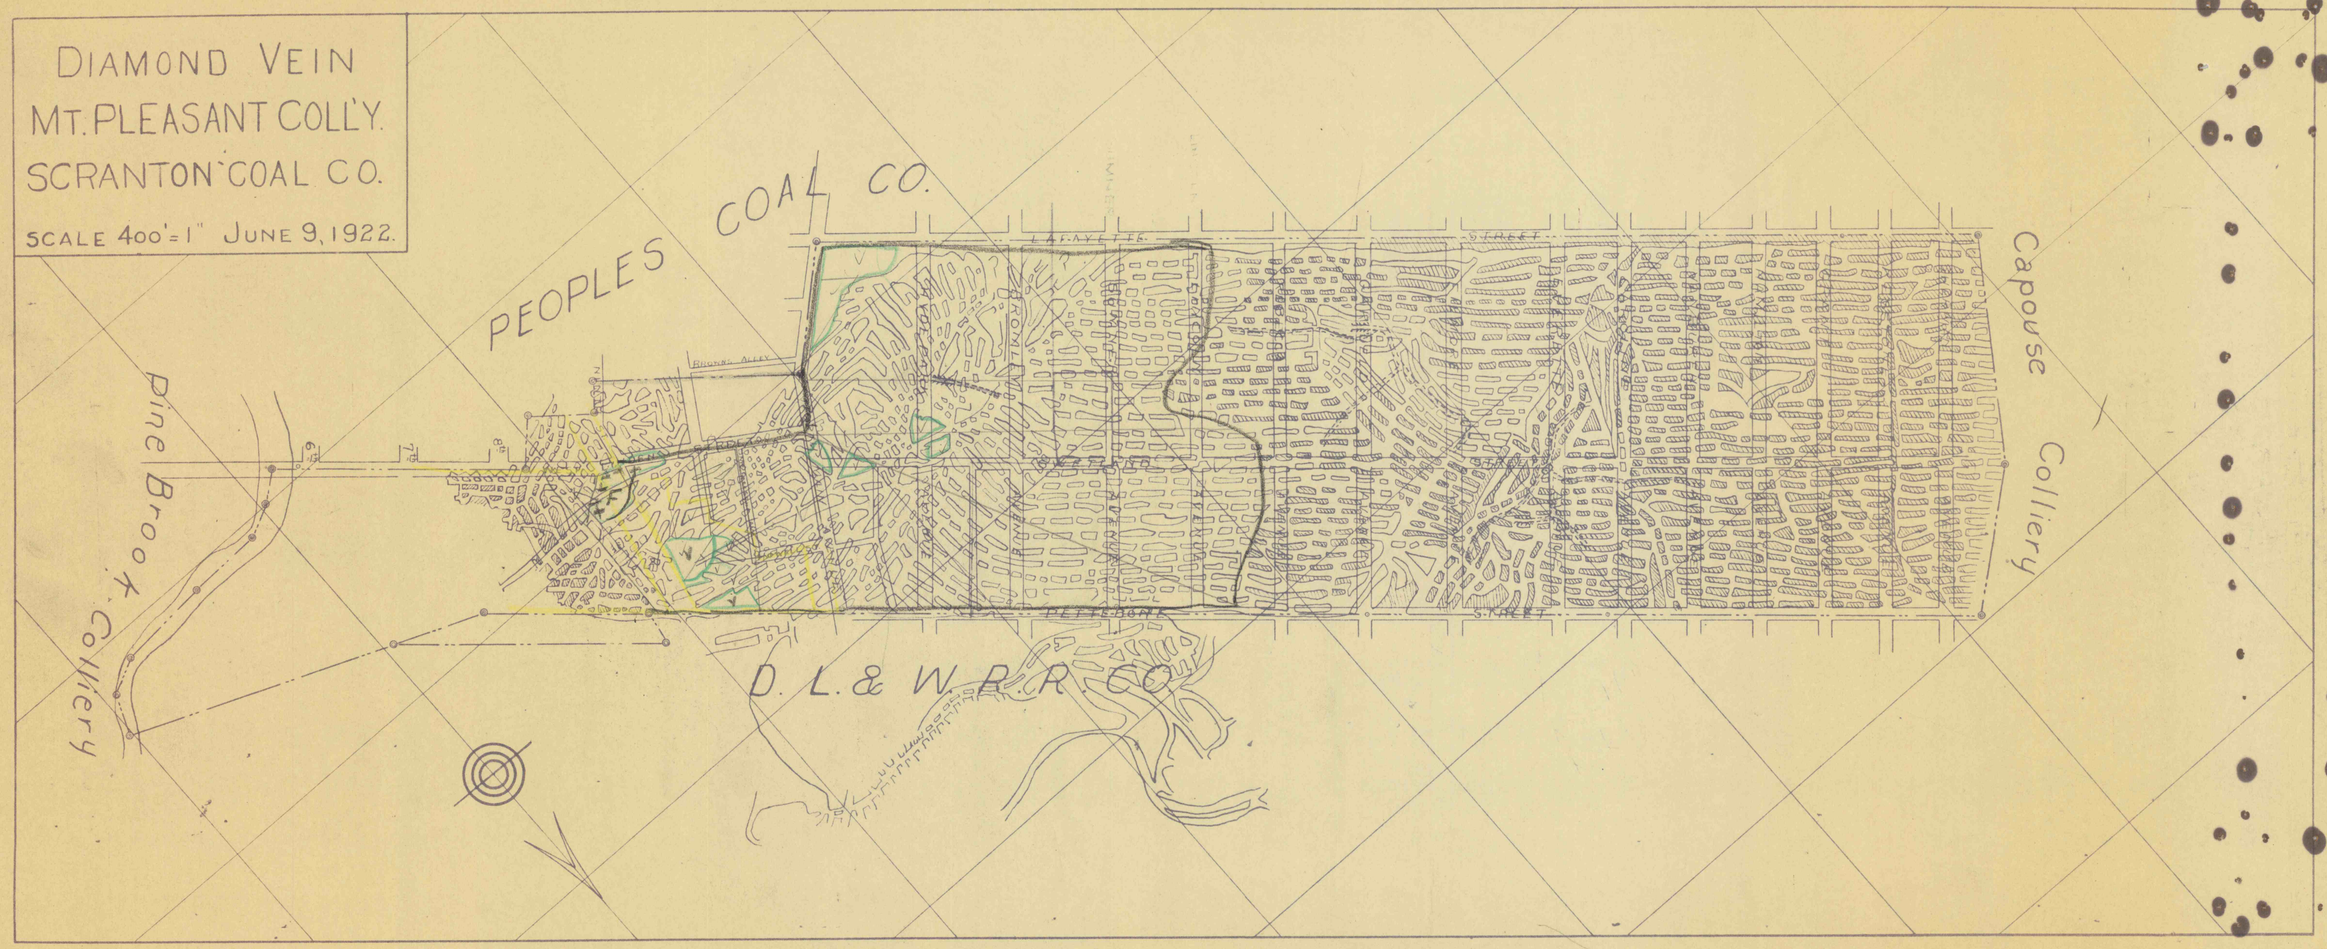
DIAMOND VEIN
MT. PLEASANT COLL'Y.
SCRANTON COAL CO.
SCALE 400'=1" JUNE 9, 1922.
PEOPLES COAL CO.
Pine Brook Colliery
Capouse Colliery
D. L. & W. R. R. CO.
LAFAYETTE
STREET
BROWN ALLEY
BELLEBORE
STREET